

KOLB LAND CONSULTING, INC.
LAND SURVEYING • SUBDIVIDING • LAND PLANNING

929 WILLIAMS STREET LAKE GENEVA, WISCONSIN 53147 414-248-3697

NORTHWEST CORNER
SEC. 14-3-18

(S 89°44'40" E 120.00')

IRON ROD UNDER
DIRT PILE


(1143.53')



SCALE: 1" = 40'


LEGEND

- - IRON ROD FOUND
- X - P.K. NAIL FOUND
- () - AS RECORDED
- - CONCRETE MONUMENT FOUND

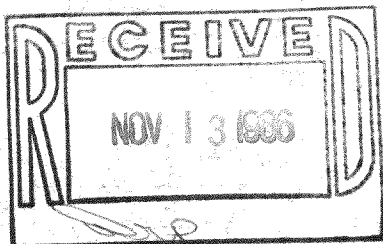

ORDERED BY: 5 STAR HOMES
90 E. GENEVA SQUARE
LAKE GENEVA, WI. 53147


NOTE: BEARINGS ARE ASSUMED
AS SHOWN ON THE RECORDED PLAT
OF INTERLAKEN.

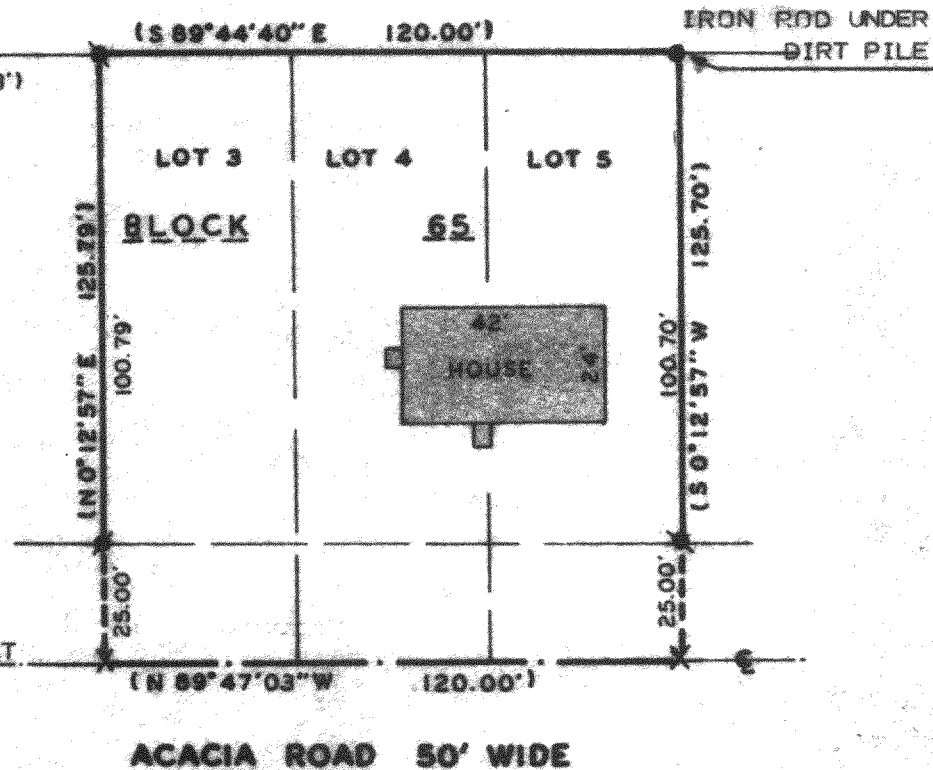

PLAT OF SURVEY OF

LOTS 3-5, BLOCK 65, OF THE FIFTH MAP OF INTERLAKEN, LOCATED IN THE
NORTHWEST 1/4 OF SECTION 14, T3N, R16E, TOWN OF SUGAR CREEK, WALWORTH
COUNTY, WISCONSIN.

I, HAROLD H. KOLB, DO HEREBY CERTIFY THAT
I HAVE SURVEYED THE PROPERTY HEREON DES-
CRIBED ACCORDING TO THE OFFICIAL RECORDS,
AND THAT THE PLAT HEREON IS A CORRECT REP-
RESENTATION OF THE LOT LINES TO THE BEST
OF MY KNOWLEDGE AND BELIEF.

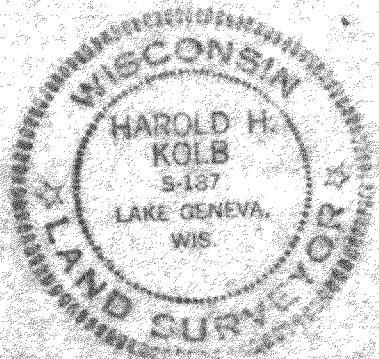

Harold H. Kolb

HAROLD H. KOLB

WISCONSIN REGISTERED LAND SURVEYOR, S-187

DATE FEBRUARY 11, 1986

REVISED _____

REVISED _____