

PLAT OF SURVEY OF

LOTS 8 & 9, BLOCK 49 OF THE 4TH MAP OF INTERLAKEN, A SUBDIVISION LOCATED IN SECTION 11, T. 3 N., R. 16 E. IN THE TOWNSHIP OF SUGAR CREEK, WALWORTH COUNTY, WISCONSIN.



SCALE 1" = 20'

o = IRON PIPE STAKE FOUND.

• = CONCRETE MONUMENT FOUND.

FOR THE VETERANS ADMINISTRATION

BEARINGS RELATE TO EAST LINE OF BLOCK 49 WHICH WAS USED AS PLATTED AS S. 18°37' E.

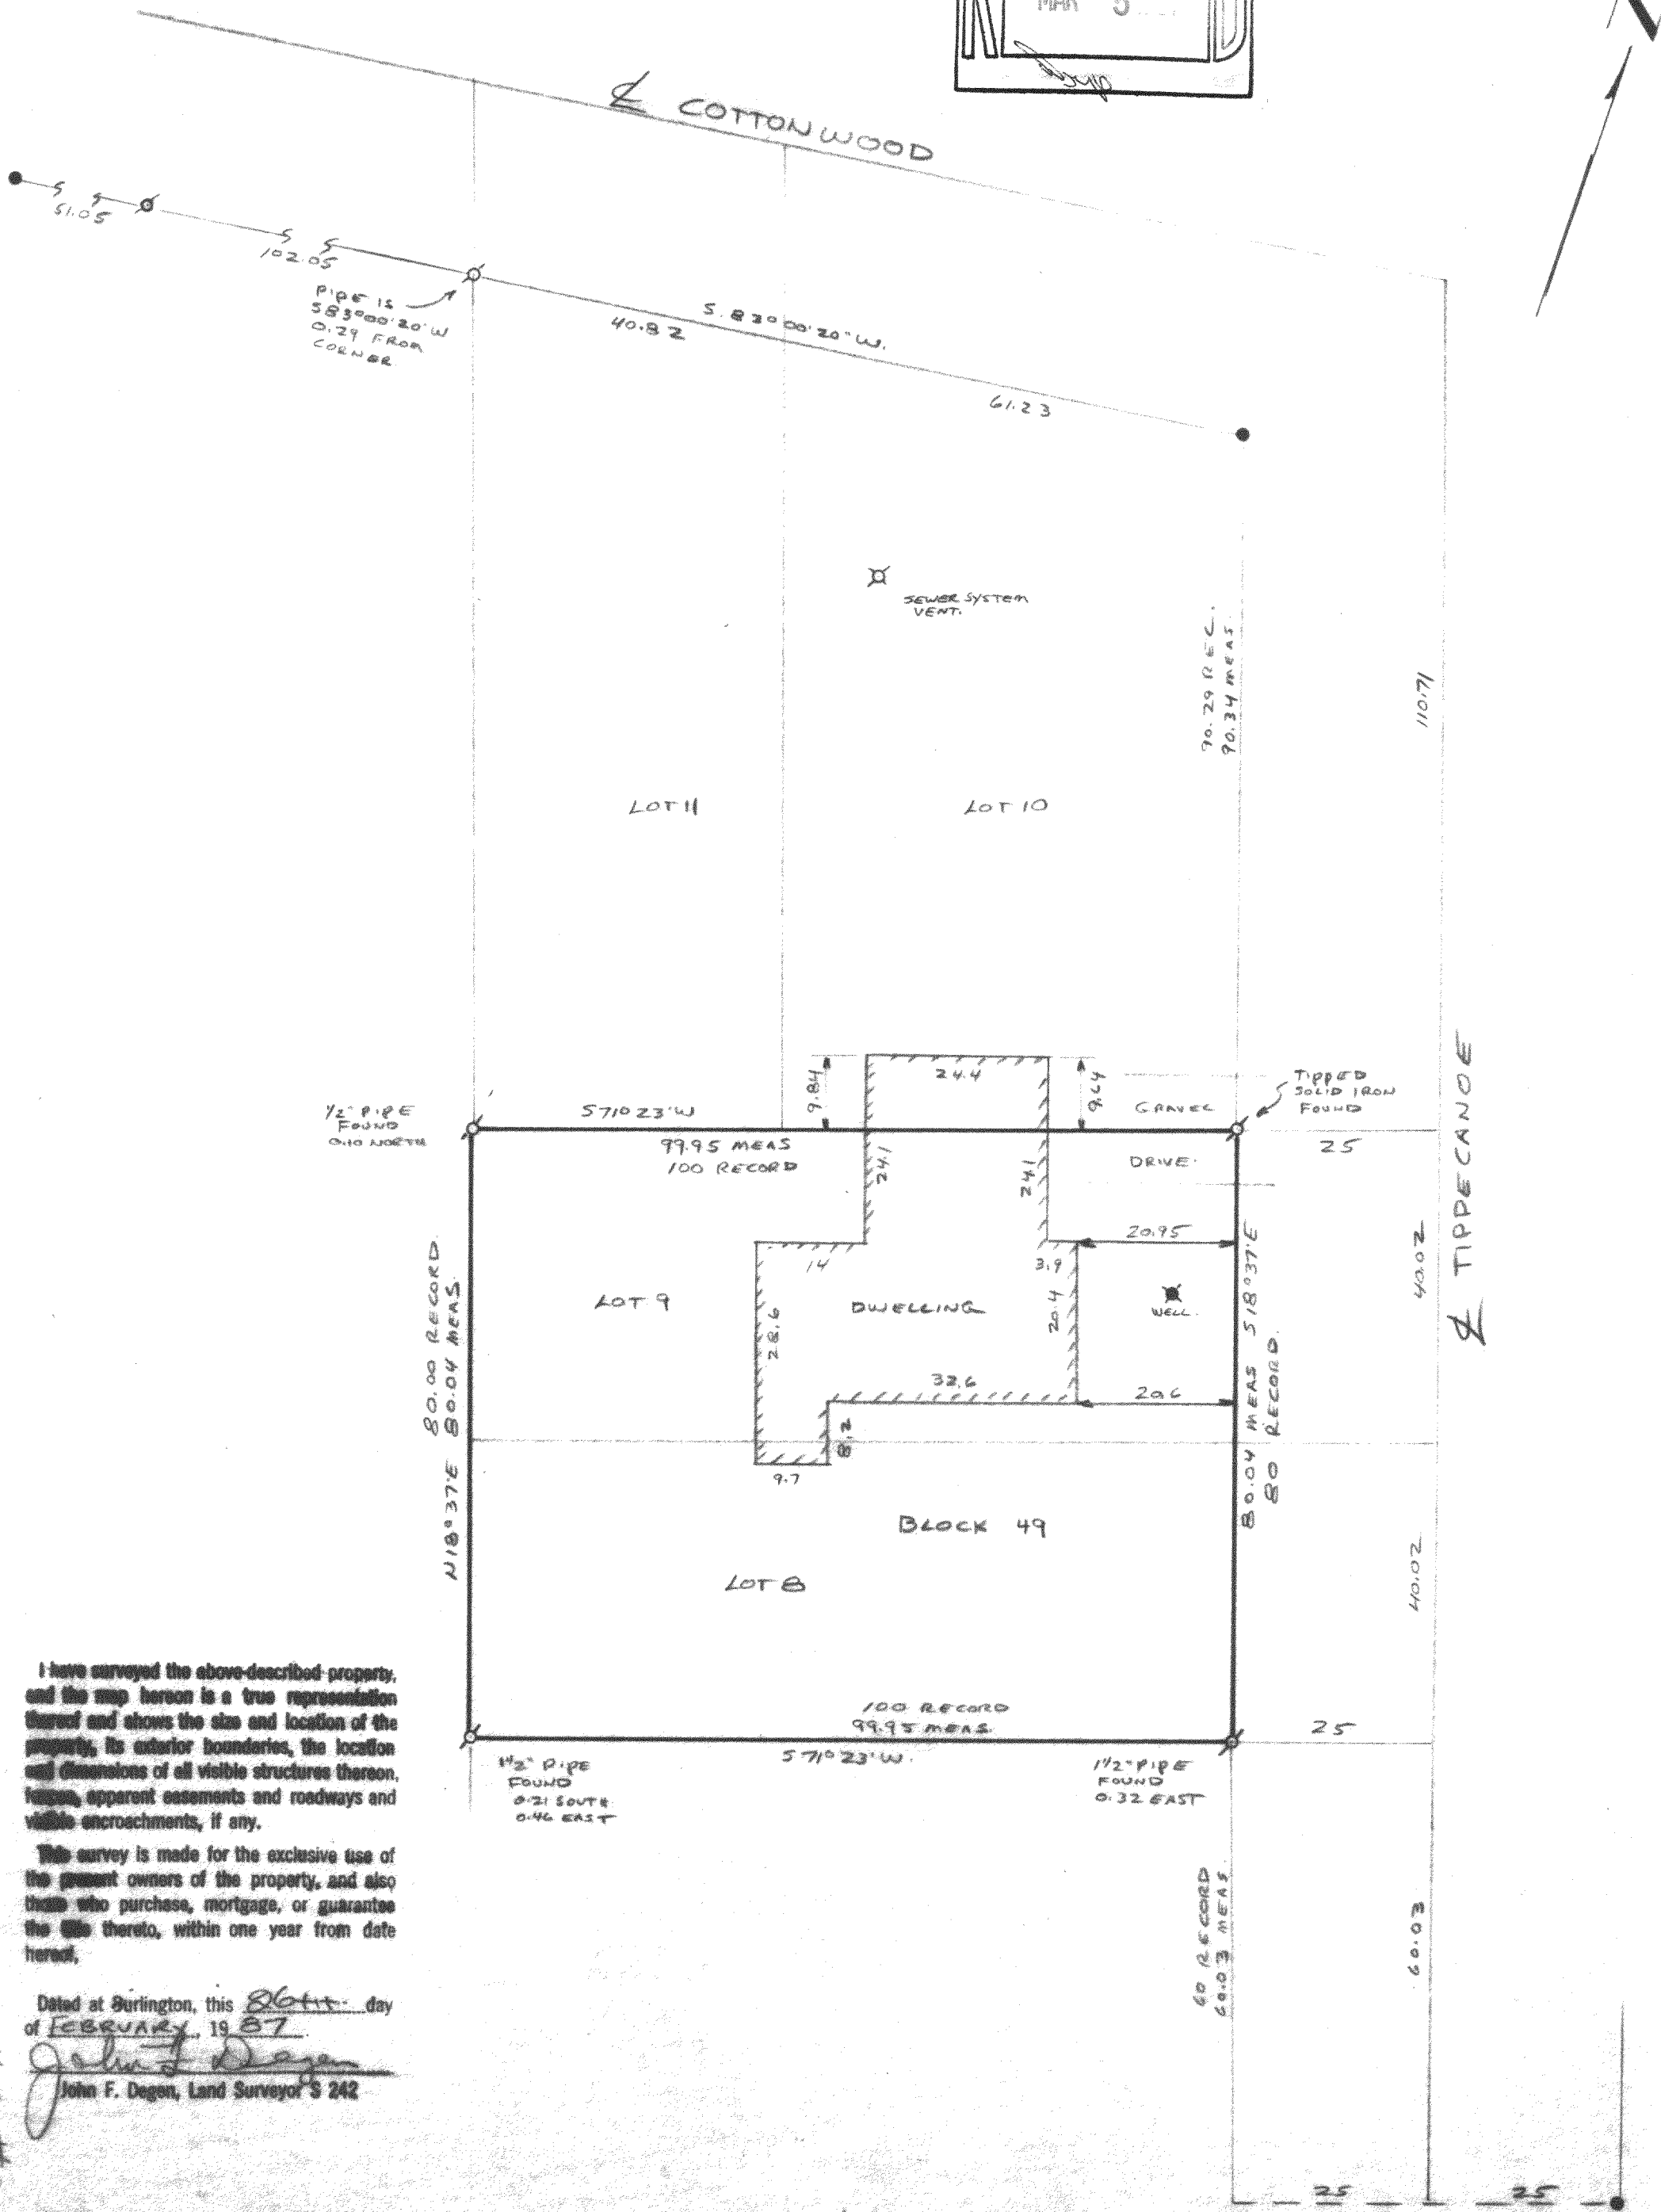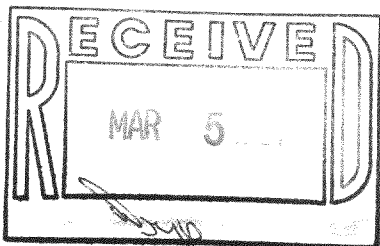

I have surveyed the above-described property, and the map hereon is a true representation thereof and shows the size and location of the property, its exterior boundaries, the location and dimensions of all visible structures thereon, easements, apparent easements and roadways and visible encroachments, if any.

This survey is made for the exclusive use of the present owners of the property, and also those who purchase, mortgage, or guarantee the title thereto, within one year from date hereof.

Dated at Burlington, this 26th day of FEBRUARY, 1987.

John F. Degen, Land Surveyor S 242