



COOPER SURVEYING SERVICES
Rural - Residential - Commercial

DANIEL D. COOPER
Registered Land Surveyor

Route 3, Box 255 :: Elkhorn, Wisconsin 53121

Phone (414) 723-6265

SURVEYING & PLANNING
SUBDIVISIONS - LOT SURVEYS
CONSTRUCTION STAKING - MAPPING

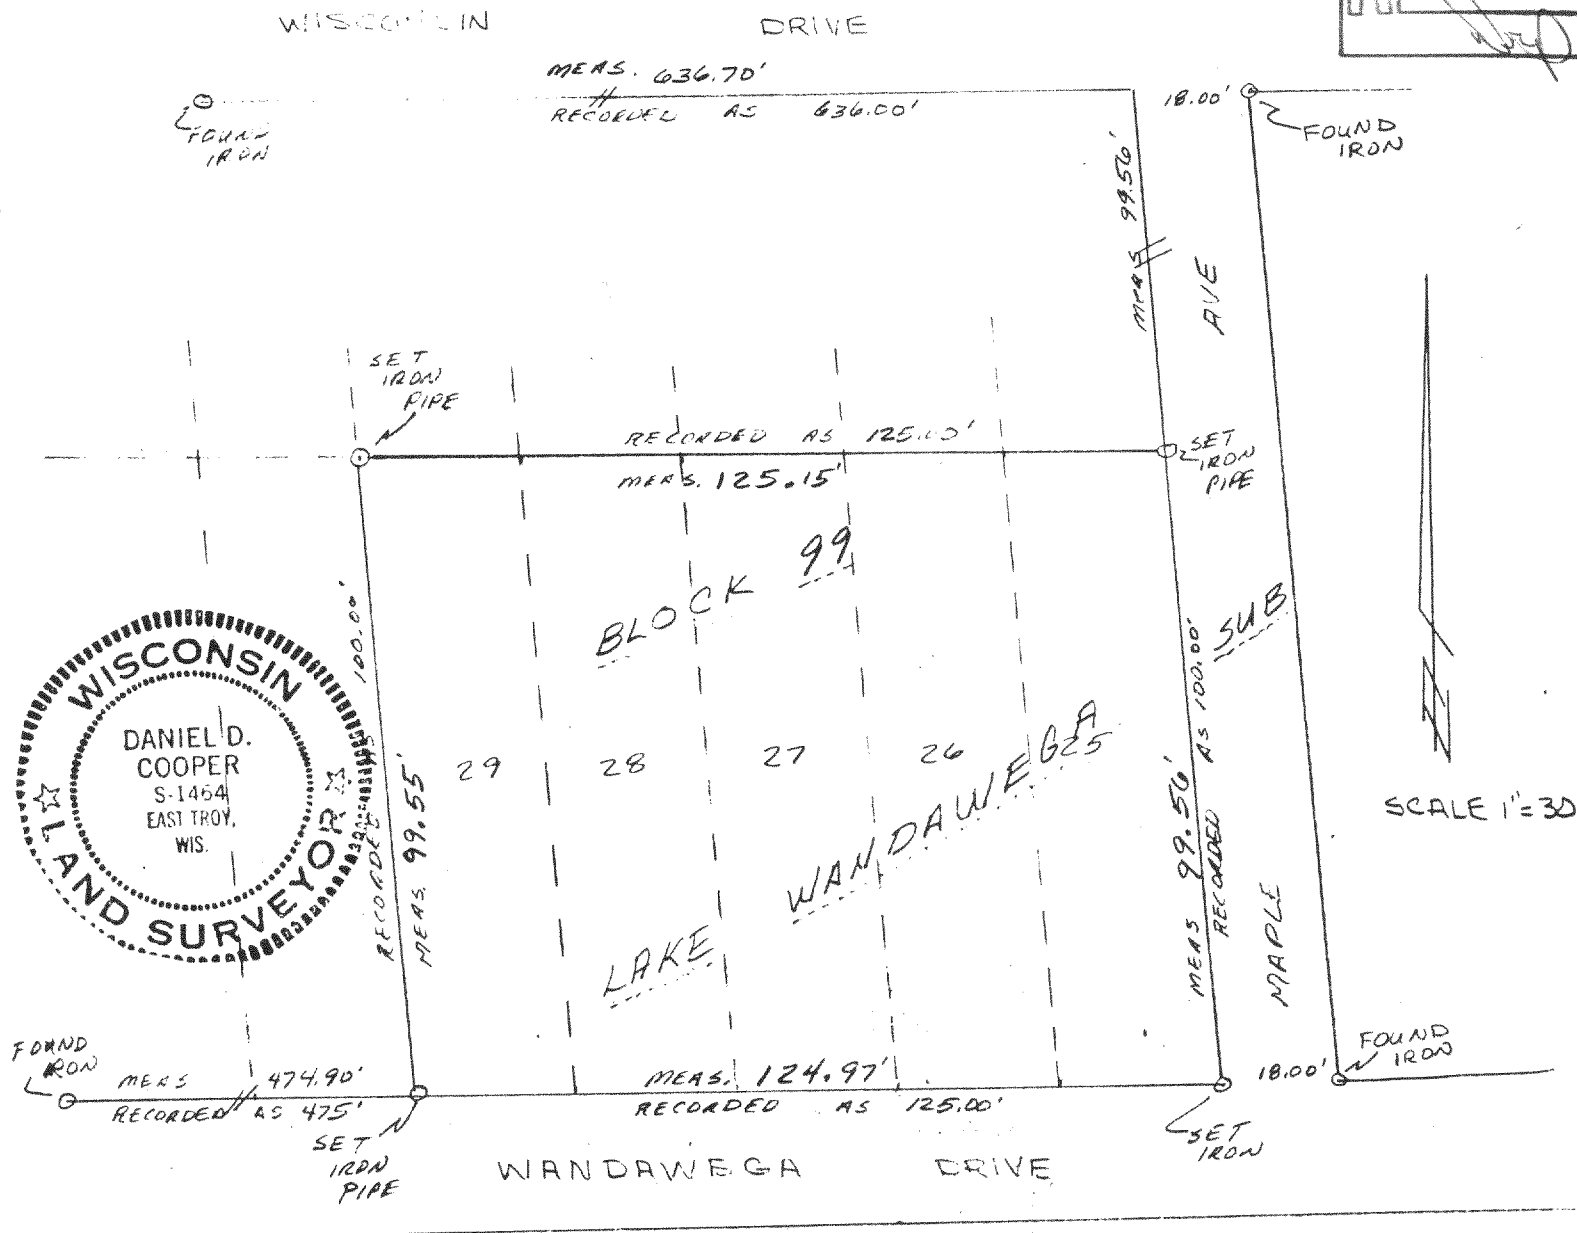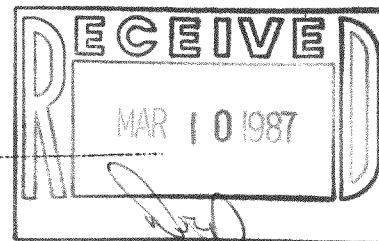

WORK ORDERED BY: HAFFNER

Plat of Survey of Lots 25-29 of Block 99 of
Lake Wandawega Subdivision, being a subdivision
located in the Town of Sugar Creek, Walworth County
Wisconsin.

I hereby certify that I have surveyed the property described hereon and that the
above map is a true and accurate representation of the lot lines to the best of
my professional knowledge and belief.

Dated this 22 day of JUNE, 1983

Daniel D. Cooper
Daniel D. Cooper RLS, No. S-1464

TAX Parcel GLW 00196