



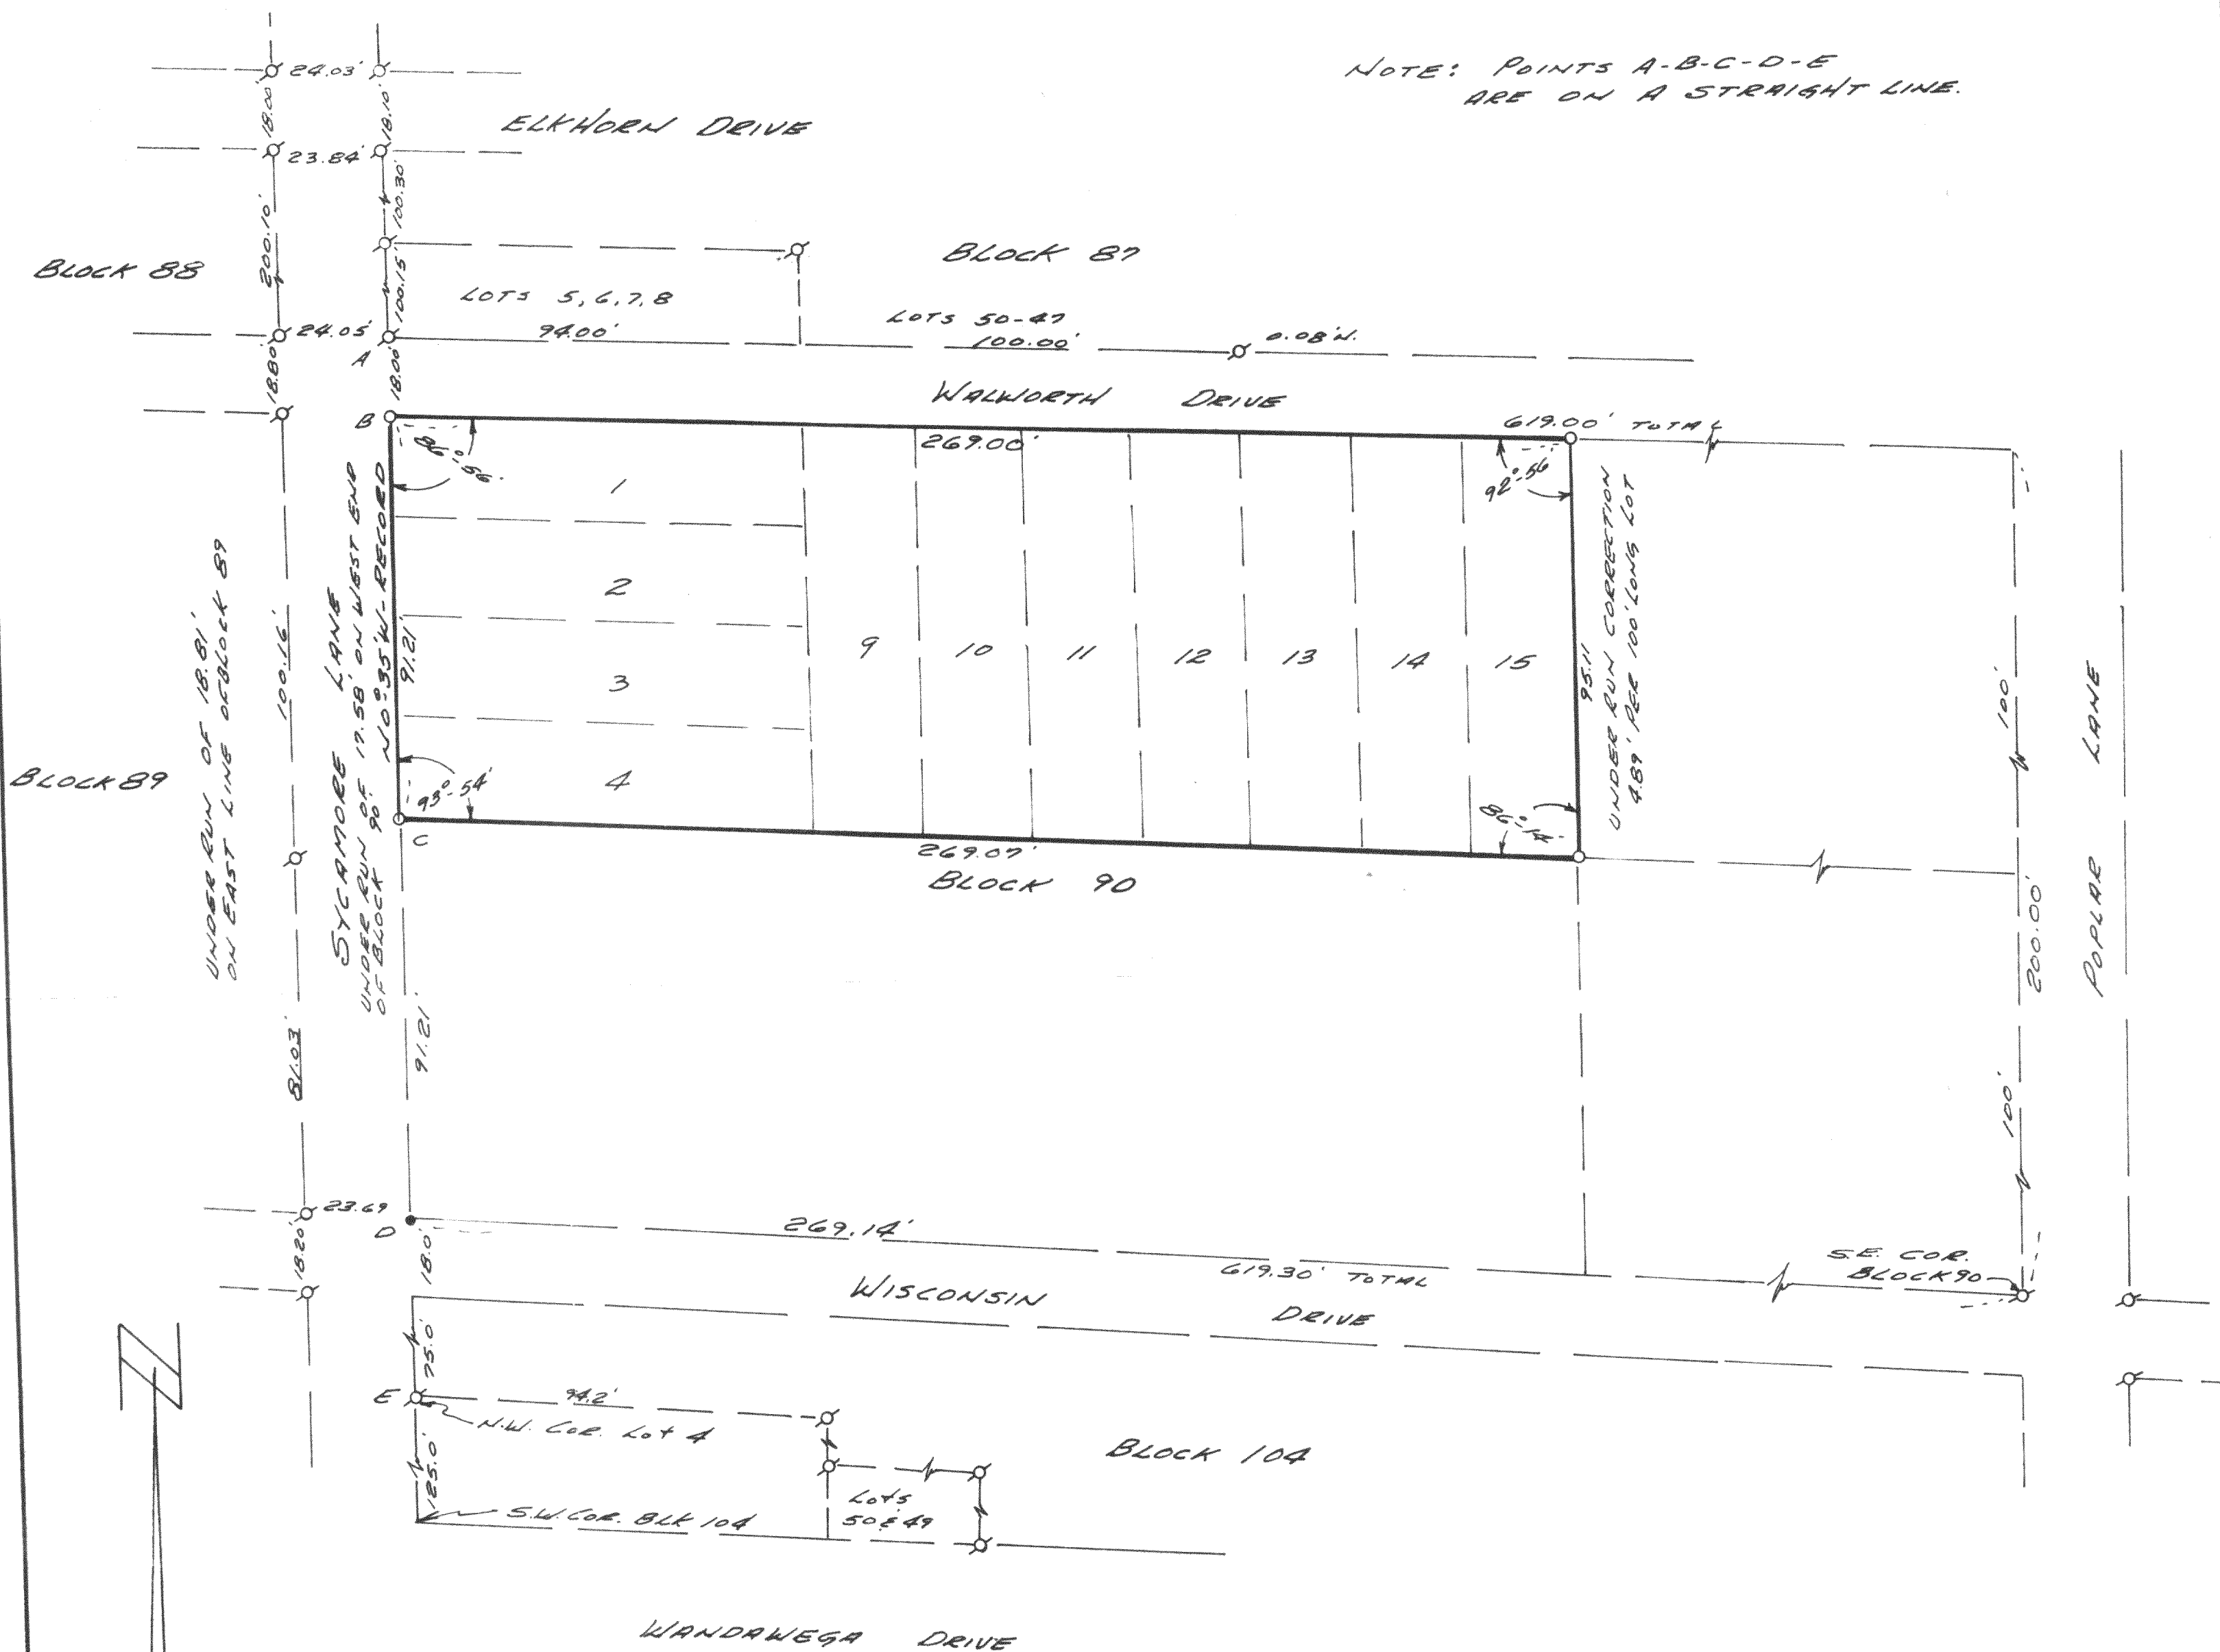

GLW-149, 150, 151, 152, 153

- ⊗ IRON PIPE FOUND
- IRON PIPE SET
- IRON ROD SET

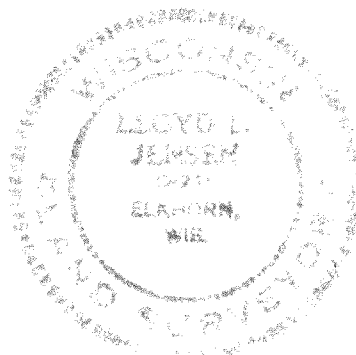

PLAT OF SURVEY OF

LOTS 1, 2, 3, 4, 9, 10, 11, 12, 13, 14, 15 BLOCK 90
OF LAKE WANDAWEGA SUBD. LOCATED
IN SECTION 2, T3N R16E, WAL. CO. WIS.

Lloyd L. Jensen
SURVEYOR

SCALE 1" = 30'

DATE JULY 1971

316-38.1