


WALWORTH COUNTY
SURVEYING & MAPPING
LAKE GENEVA, WISCONSIN

WALWORTH AVENUE
(275')
268.97'


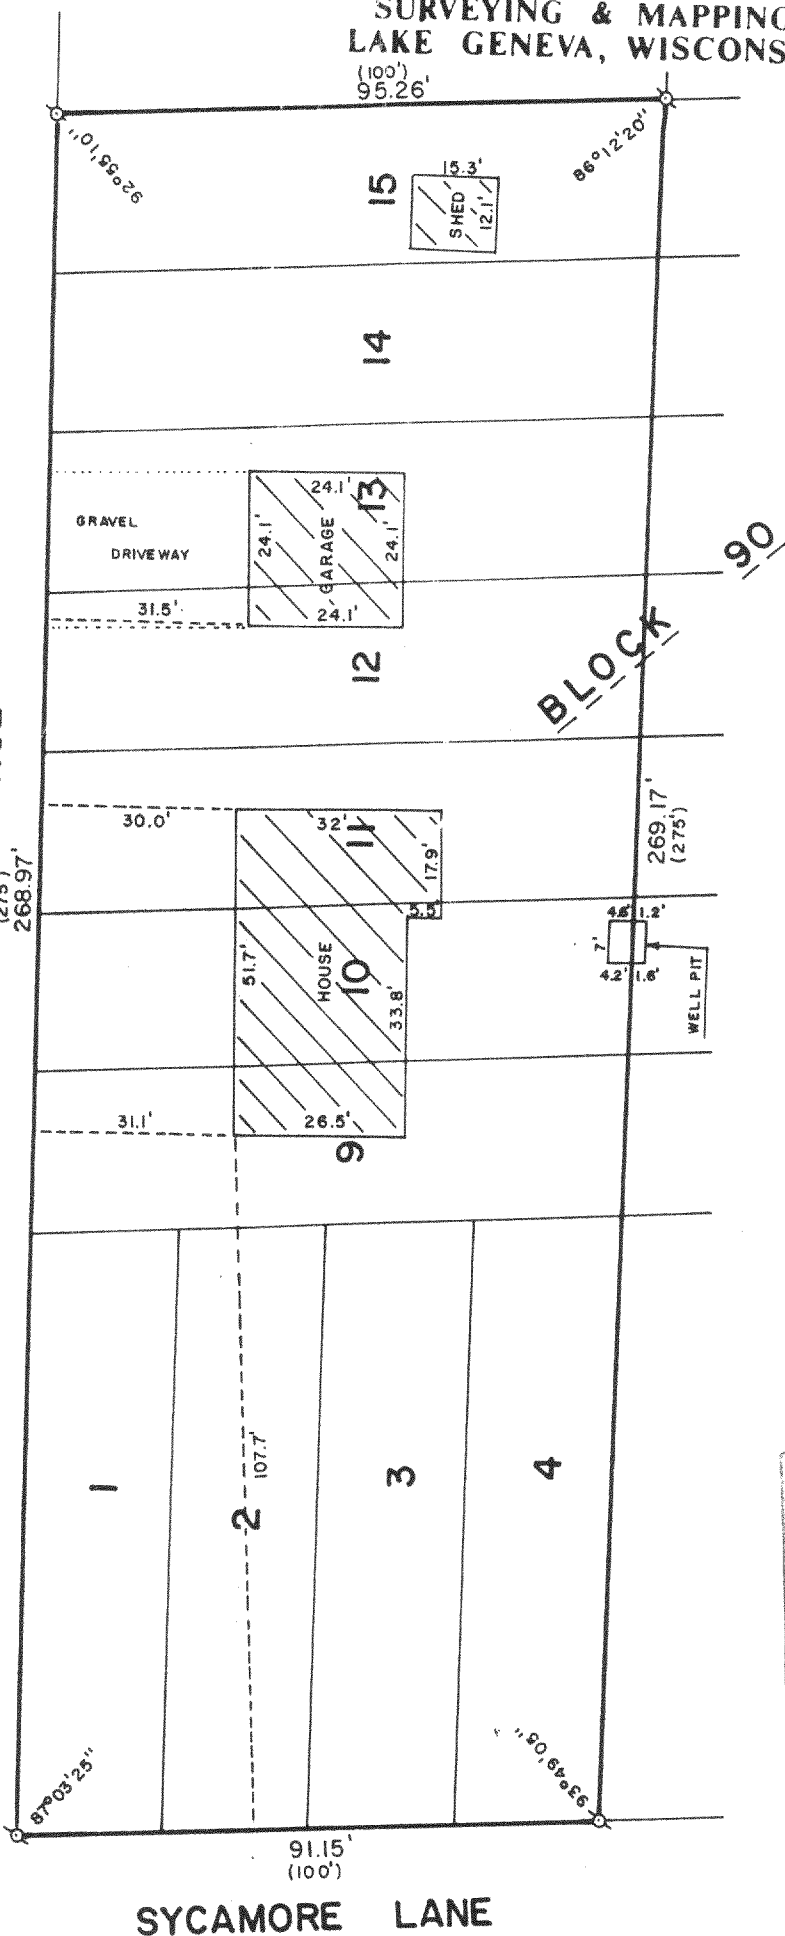


PLAT OF SURVEY OF

LOTS 1-4 AND 9-15, BLOCK 90 OF LAKE WANDAWEGA
SUBDIVISION, LOCATED IN SECTION 2, T 3 N, R 16 E,
WALWORTH COUNTY, WISCONSIN.

ORDERED BY: KENOSHA SAVINGS & LOAN
410 BROAD STREET
LAKE GENEVA, WISCONSIN 53147

NOTE: THIS SURVEY IS A RETRACEMENT
OF A SURVEY OF A SURVEY BY L. L.
JENSEN AS FOUND TO BE MONUMENTED.

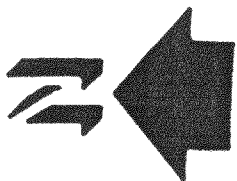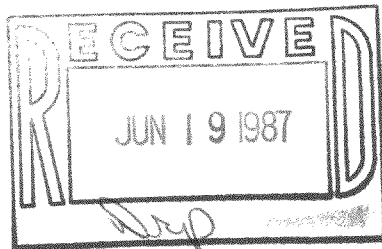

SCALE: 1"=30'

Ø-IRON PIPE FOUND
()-RECORDED AS

I, ROBERT M. BAERENWALD, DO HEREBY CERTIFY THAT I
HAVE SURVEYED THE PROPERTY HEREON DESCRIBED ACCORDING
TO THE OFFICIAL RECORDS AND THAT THE PLAT HEREON IS A
CORRECT REPRESENTATION OF THE PROPERTY LINES TO THE
BEST OF MY KNOWLEDGE AND BELIEF.

Robert M. Baerenwald
ROBERT M. BAERENWALD
WISCONSIN REGISTERED LAND SURVEYOR, S-1508

April 28, 1987
DATE: _____ JOB NO. 1024

NOTE: THIS IS NOT A CERTIFIED COPY UNLESS SEALED.

GLW-149, 152, 153

316-382