



PLAT OF SURVEY of Lots 20,21,22,23 of Block 23, Second Map of Interlaken, Located
in the SE $\frac{1}{4}$ of section 11, T3N R16E, Walworth County, Wisconsin.

Surveyed for Mr. Kurt Buehner

D. D. COOPER & CO., INC.
Daniel D. Cooper
Rt. 4 Box 508B
Elkhorn, WI 53121

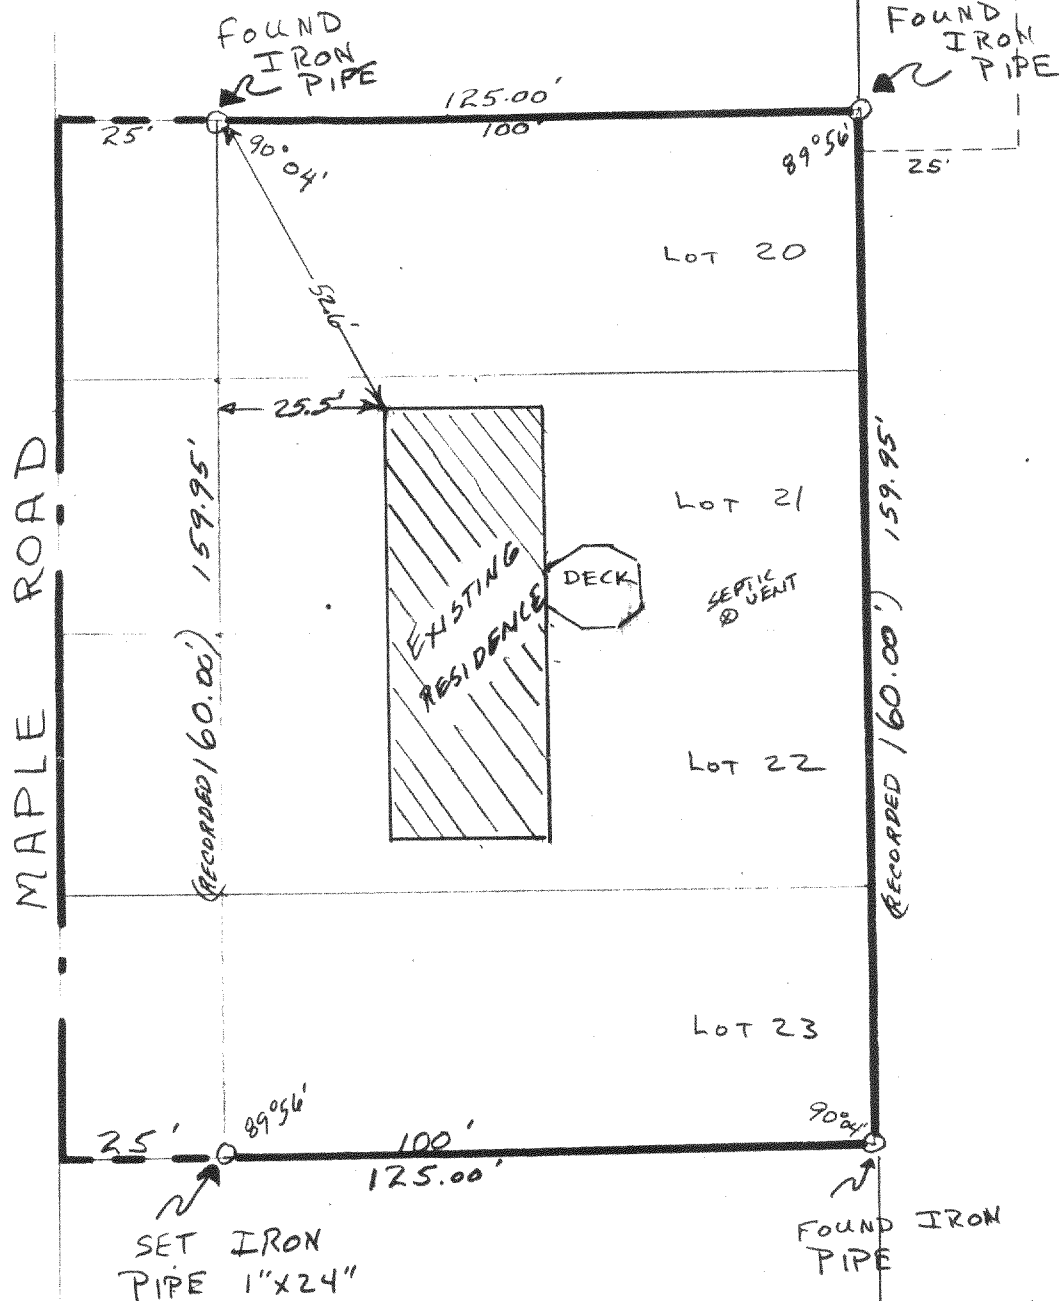

EASEMENT FOR
SEPTIC SYSTEM
AS DESCRIBED IN
VOL 346 pg 193
OF RECORDS, WALWORTH
COUNTY REGISTER OF
DEEDS.

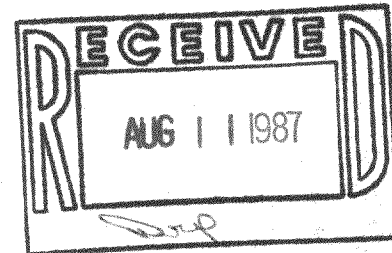

Scale
1" = 30'

I hereby certify that I have surveyed the property described
hereon and that the above is a true and accurate representation
thereof to the best of my professional knowledge.

Dated this 7th day of July 1987

Daniel D. Cooper, RLS No. S-1464

