

FARRIS, HANSEN & ASSOCIATES, INC.

7 RIDGEWAY COURT, P.O. BOX 487, ELKHORN, WISCONSIN



TEL. 414-723-2098

LOCATION: LOTS 23, 24 & 25 OF BLOCK 21 OF
INTERLAKEN SUBDIVISION IN SEC 11-3-16
WALWORTH COUNTY, WISCONSIN

WORK ORDERED BY: ATTY. LOWELL SWEET


MAP LEGEND

- = IRON PIPE STAKE FOUND
- = IRON PIPE STAKE SET
- = IRON ROD STAKE FOUND
- = IRON ROD STAKE SET
- = CONCRETE MONUMENT FOUND
- (XXXXX) = RECORD DIMENSION

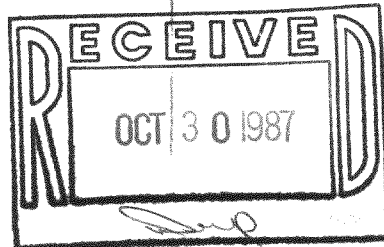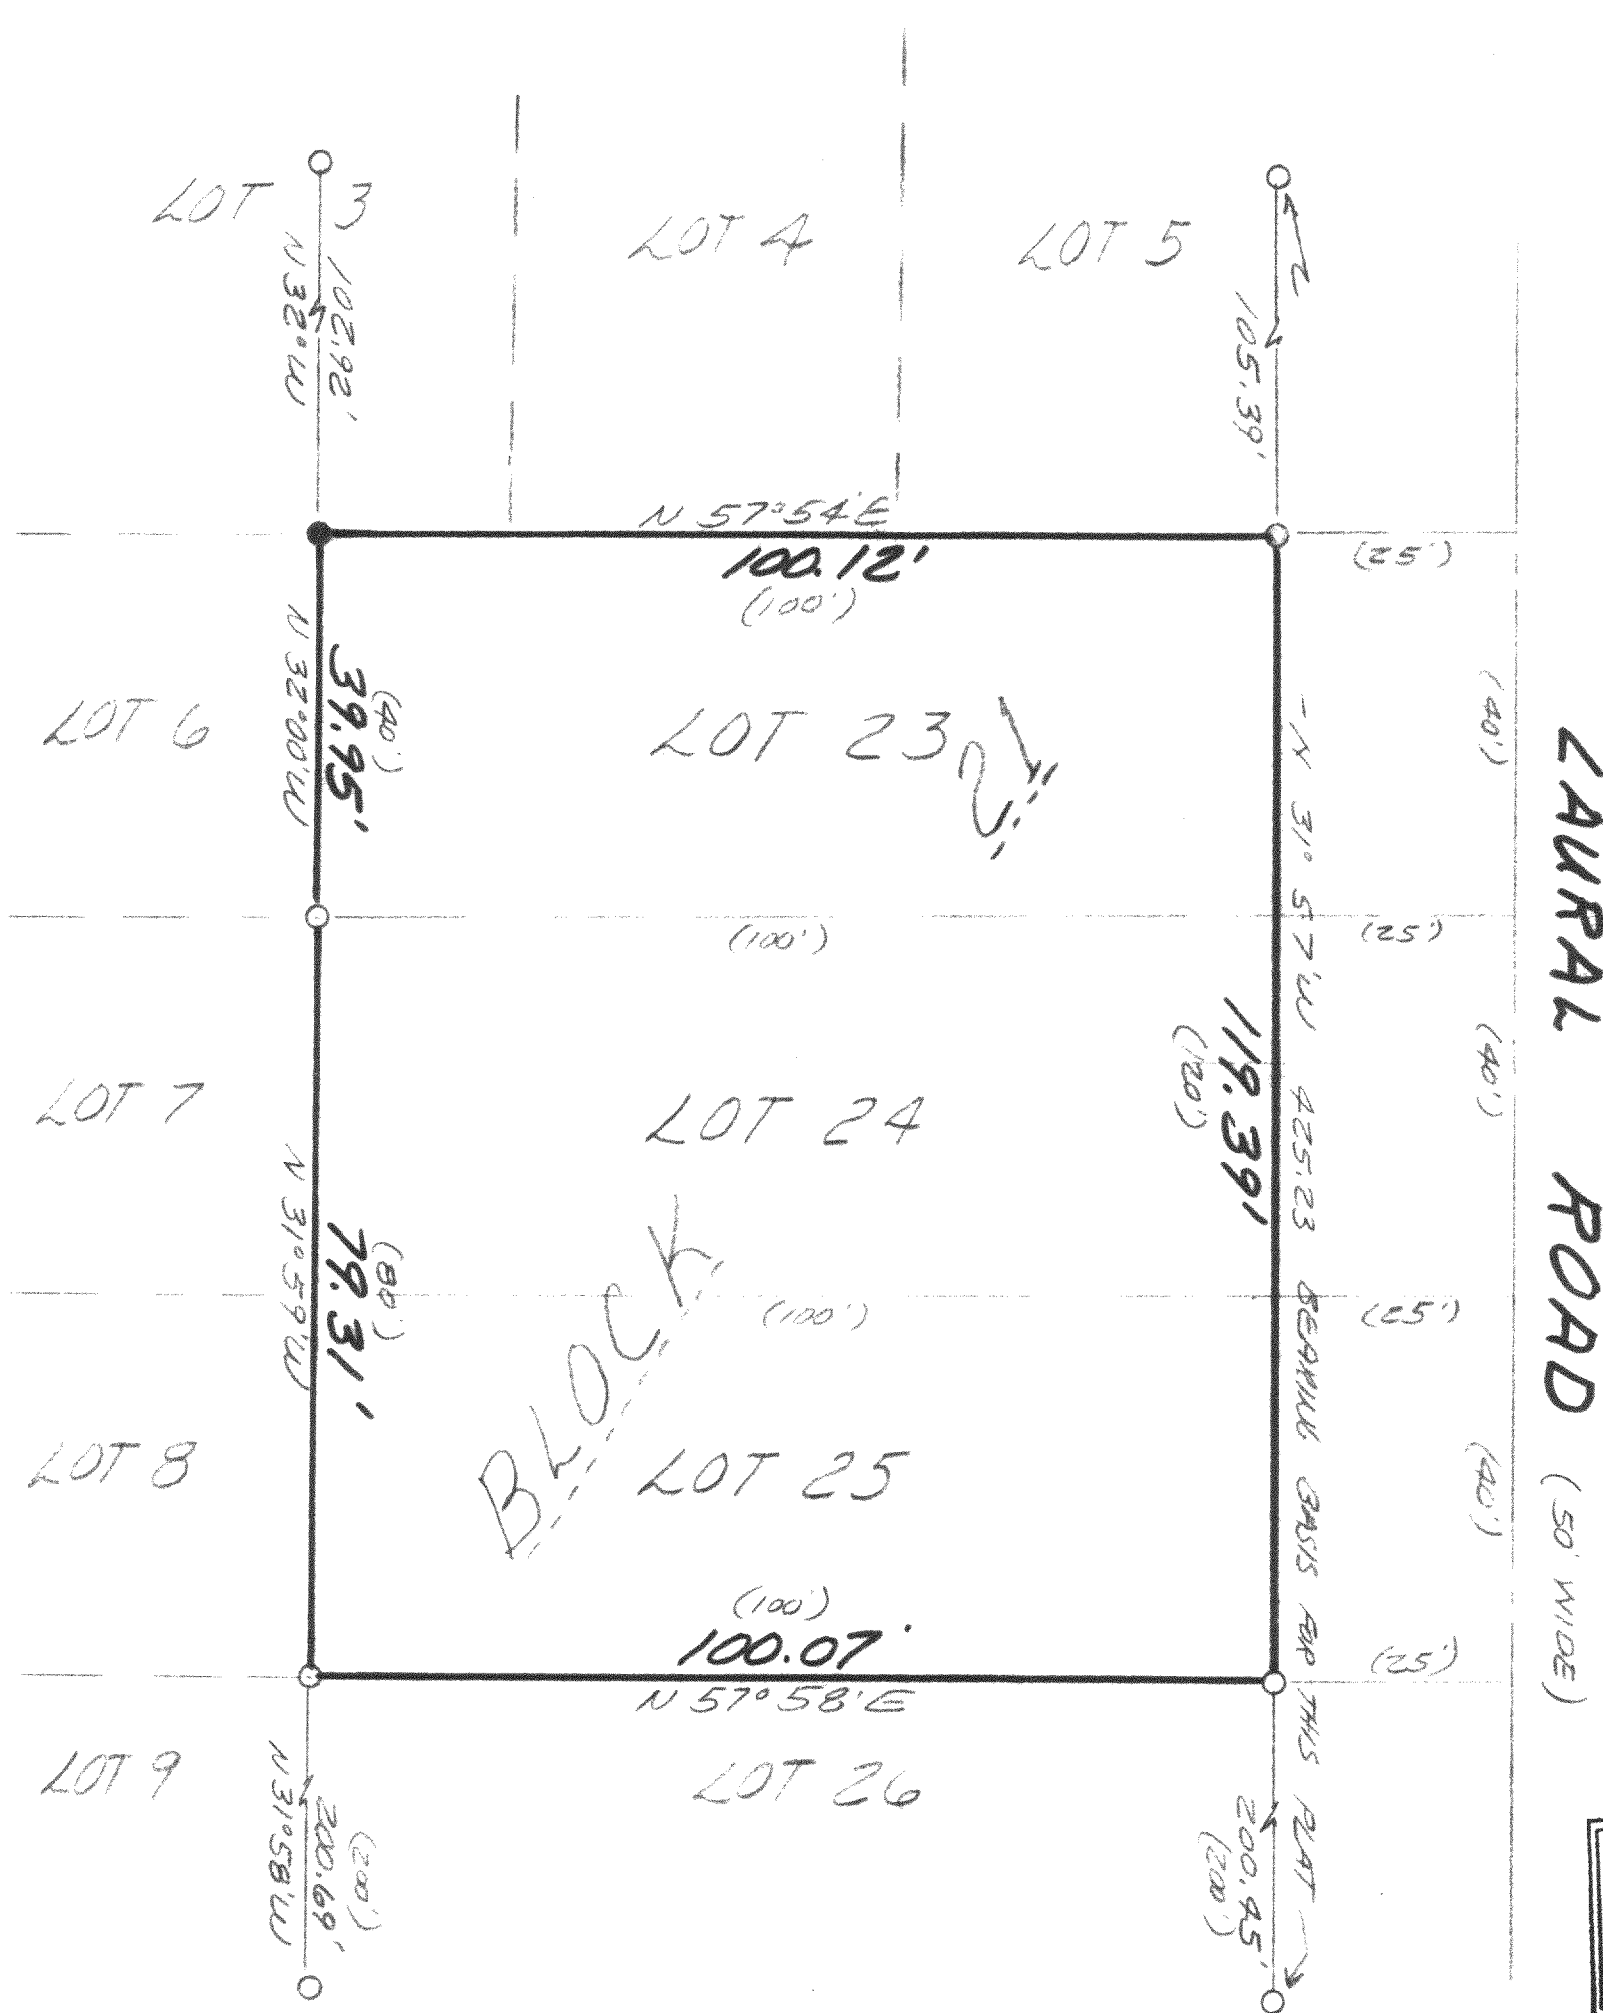

I hereby certify that the above described property has been surveyed under my direction and that the above map is a true representation thereof and shows the size and location of the property, its exterior boundaries, the location of all visible structures and dimensions of all principal buildings thereon, ~~boundary lines, apparent easements, roads, and visible encroachments.~~ This survey is made for the use of the present owners of the property, and also those who purchase, mortgage, or guarantee the title thereto within one year from the date hereof.

DATED : AUG 3, 1987

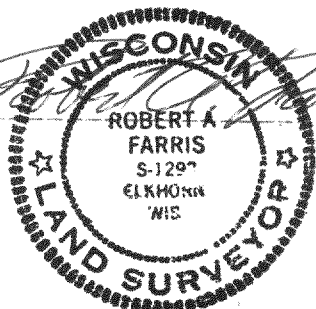

PROJ. NO. 2853