

COOPER SURVEYING SERVICES


Rural - Residential - Commercial

DANIEL D. COOPER
Registered Land Surveyor


Route 3, Box 255 :: Elkhorn, Wisconsin 53121

SURVEYING & PLANNING
SUBDIVISIONS - LOT SURVEYS
CONSTRUCTION STAKING - MAPPING

Phone (414) 723-6265

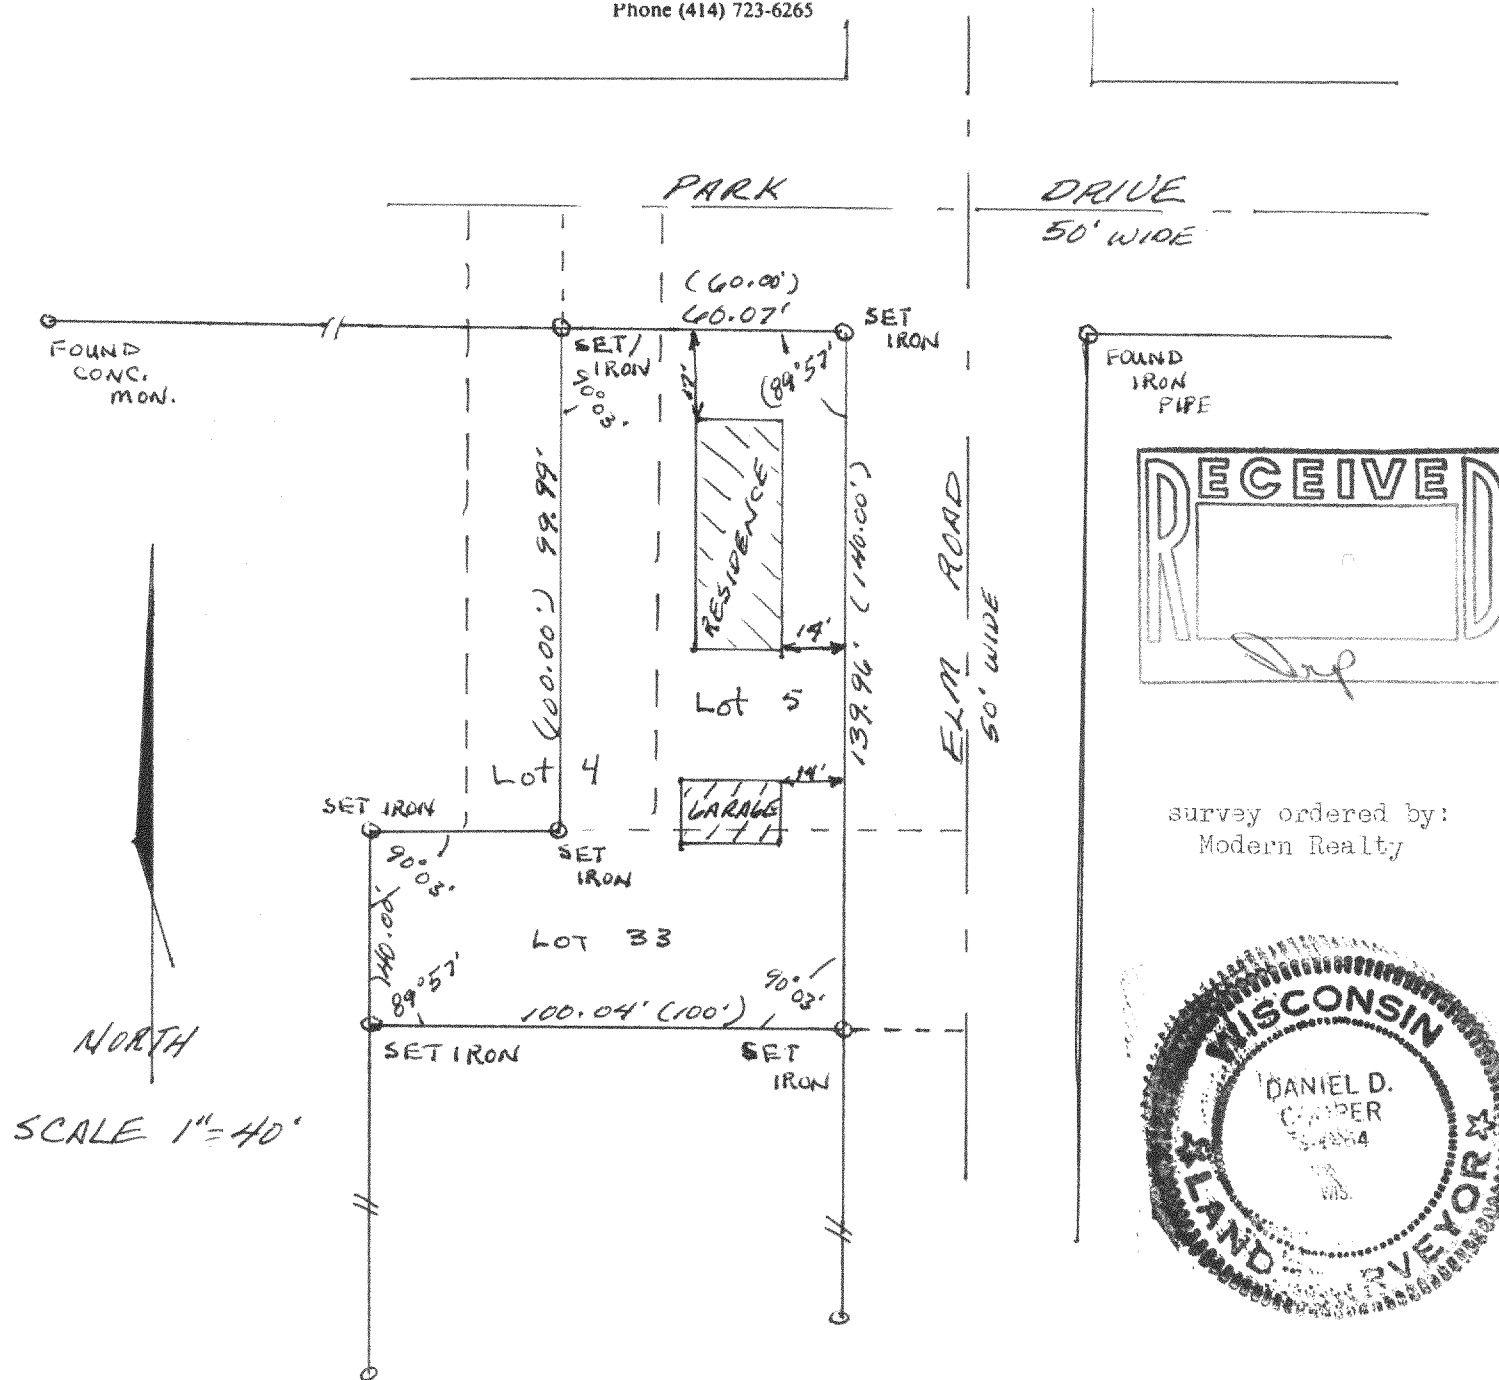

survey ordered by:
Modern Realty

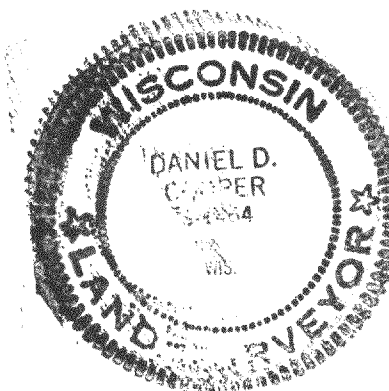

Plat of survey of the East 1/2 of Lot 4, Lot 5 and Lot 33, Block 13
of Interlaken 1st Map, Walworth County, Wisconsin.

I hereby certify that I have surveyed the property described hereon and that
the above map is an accurate representation thereof and shows the size and location
of the property and all principal structures thereon to the best of my
professional knowledge and belief. Dated this 23 day of NOV., 1982

Daniel D Cooper

316-393

DRAWING 1817