



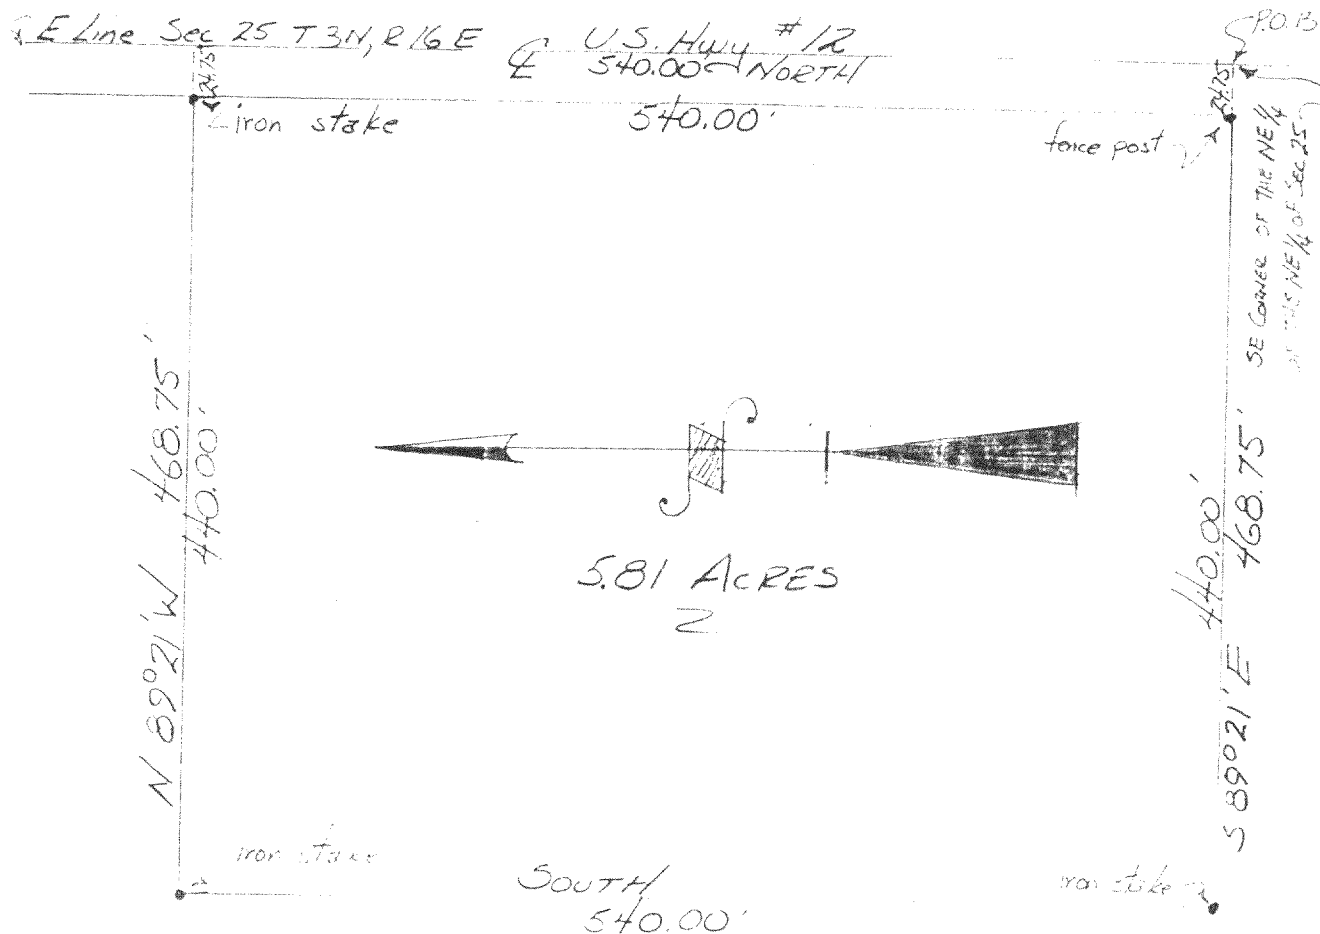

DESCRIPTION: Commencing at the SE corner of the NE 1/4 of the NE 1/4 of Section 25, Town 3 North, Range 16 East, Walworth County, Wisconsin, thence North along the East line of said section 540.00 feet to a point, thence N 89° 21' W 468.75 feet to an iron stake, thence South 540.00 feet to an iron stake, thence S 89° 21' E 468.75 feet to the place of beginning. Containing 5.81 acres


CERTIFICATE: I, James F. Biagi, surveyor do hereby certify that I have surveyed the property hereon described and that the measurements and bearings of the boundary lines are in accordance with the above drawing and description.

SIGNED AND SEALED THIS 31ST DAY OF JULY 1959

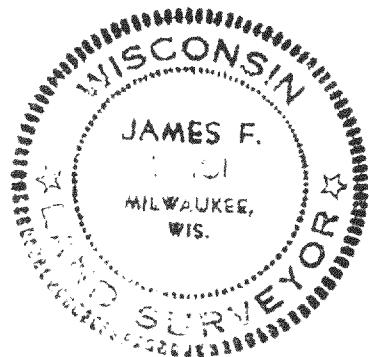

James F. Biagi
Land Surveyor (2/2)


316-39131

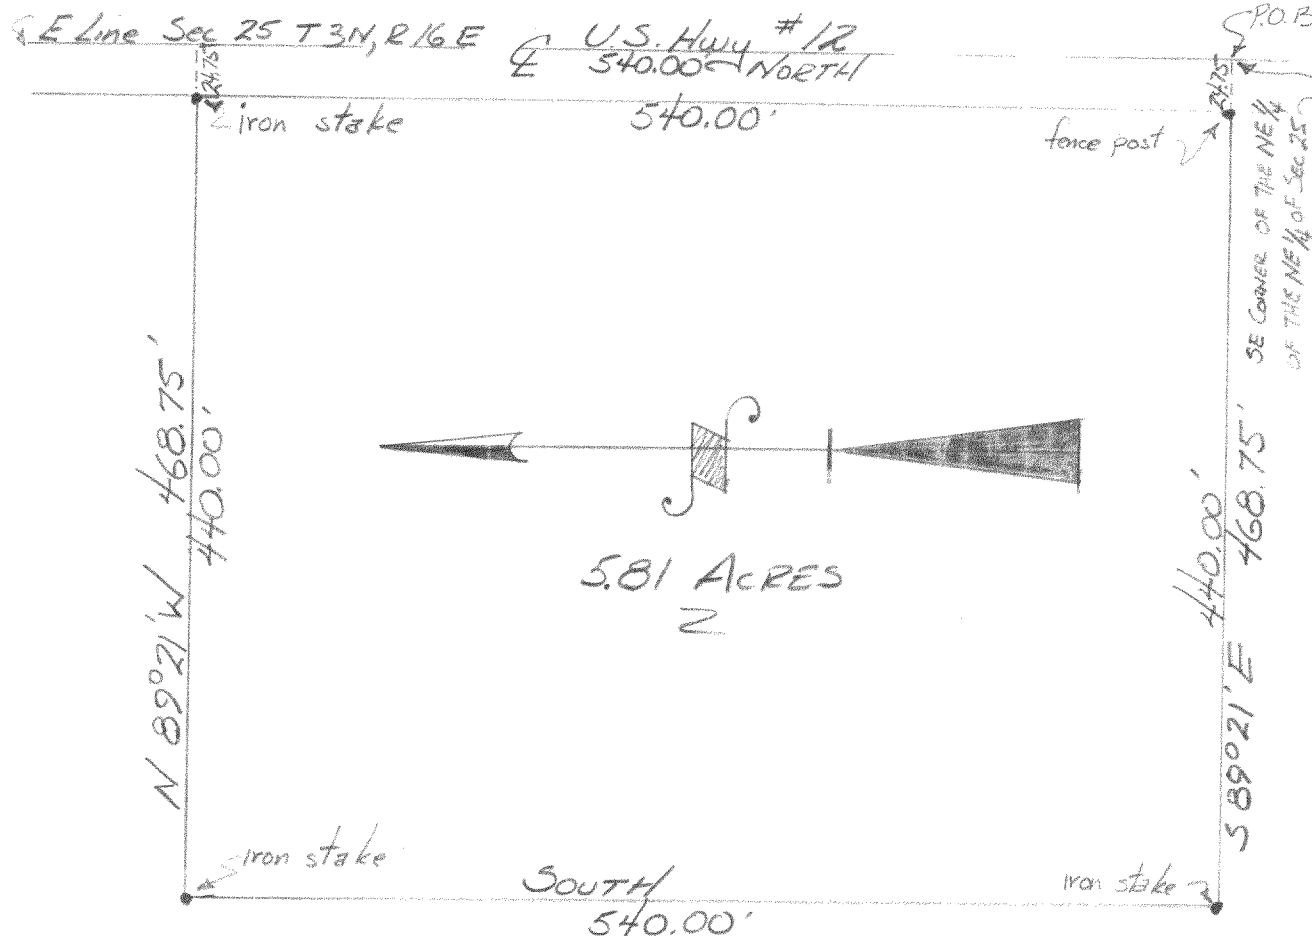

DESCRIPTION: Commencing at the SE corner of the NE $\frac{1}{4}$ of the NE $\frac{1}{4}$ of Section 25, Town 3 North, Range 16 East, Walworth County, Wisconsin, thence North along the East line of said section 540.00 feet to a point, thence N 89° 21' W 468.75 feet to an iron stake, thence South 540.00 feet to an iron stake, thence S 89° 21' E 468.75 feet to the place of beginning. Containing 5.81 acres

CERTIFICATE: I, James F. Biagi, surveyor do hereby certify that I have surveyed the property hereon described and that the measurements and bearings of the boundary lines are in accordance with the above drawing and description.

SIGNED AND SEALED THIS 31ST DAY OF JULY 1959

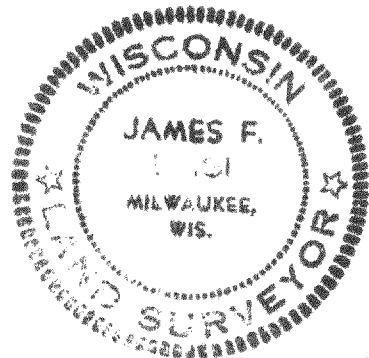

James F. Biagi
 Land Surveyor (2/2)

SC-25-1A before Hwy 12 was widened

316-39131

316-39131