



Plat of Survey of the NW 1/4 of the NW 1/4 of Section 24 Town 3 North, Range 16 East, Walworth County, Wisconsin, Except Beginnig 290.10 feet North of the SW corner of the NW 1/4 of the NW 1/4 of said section 24; thence East 208.70 feet; thence North 428.70 feet; thence West 208.70 feet; thence South 428.70 feet to the point of beginning.

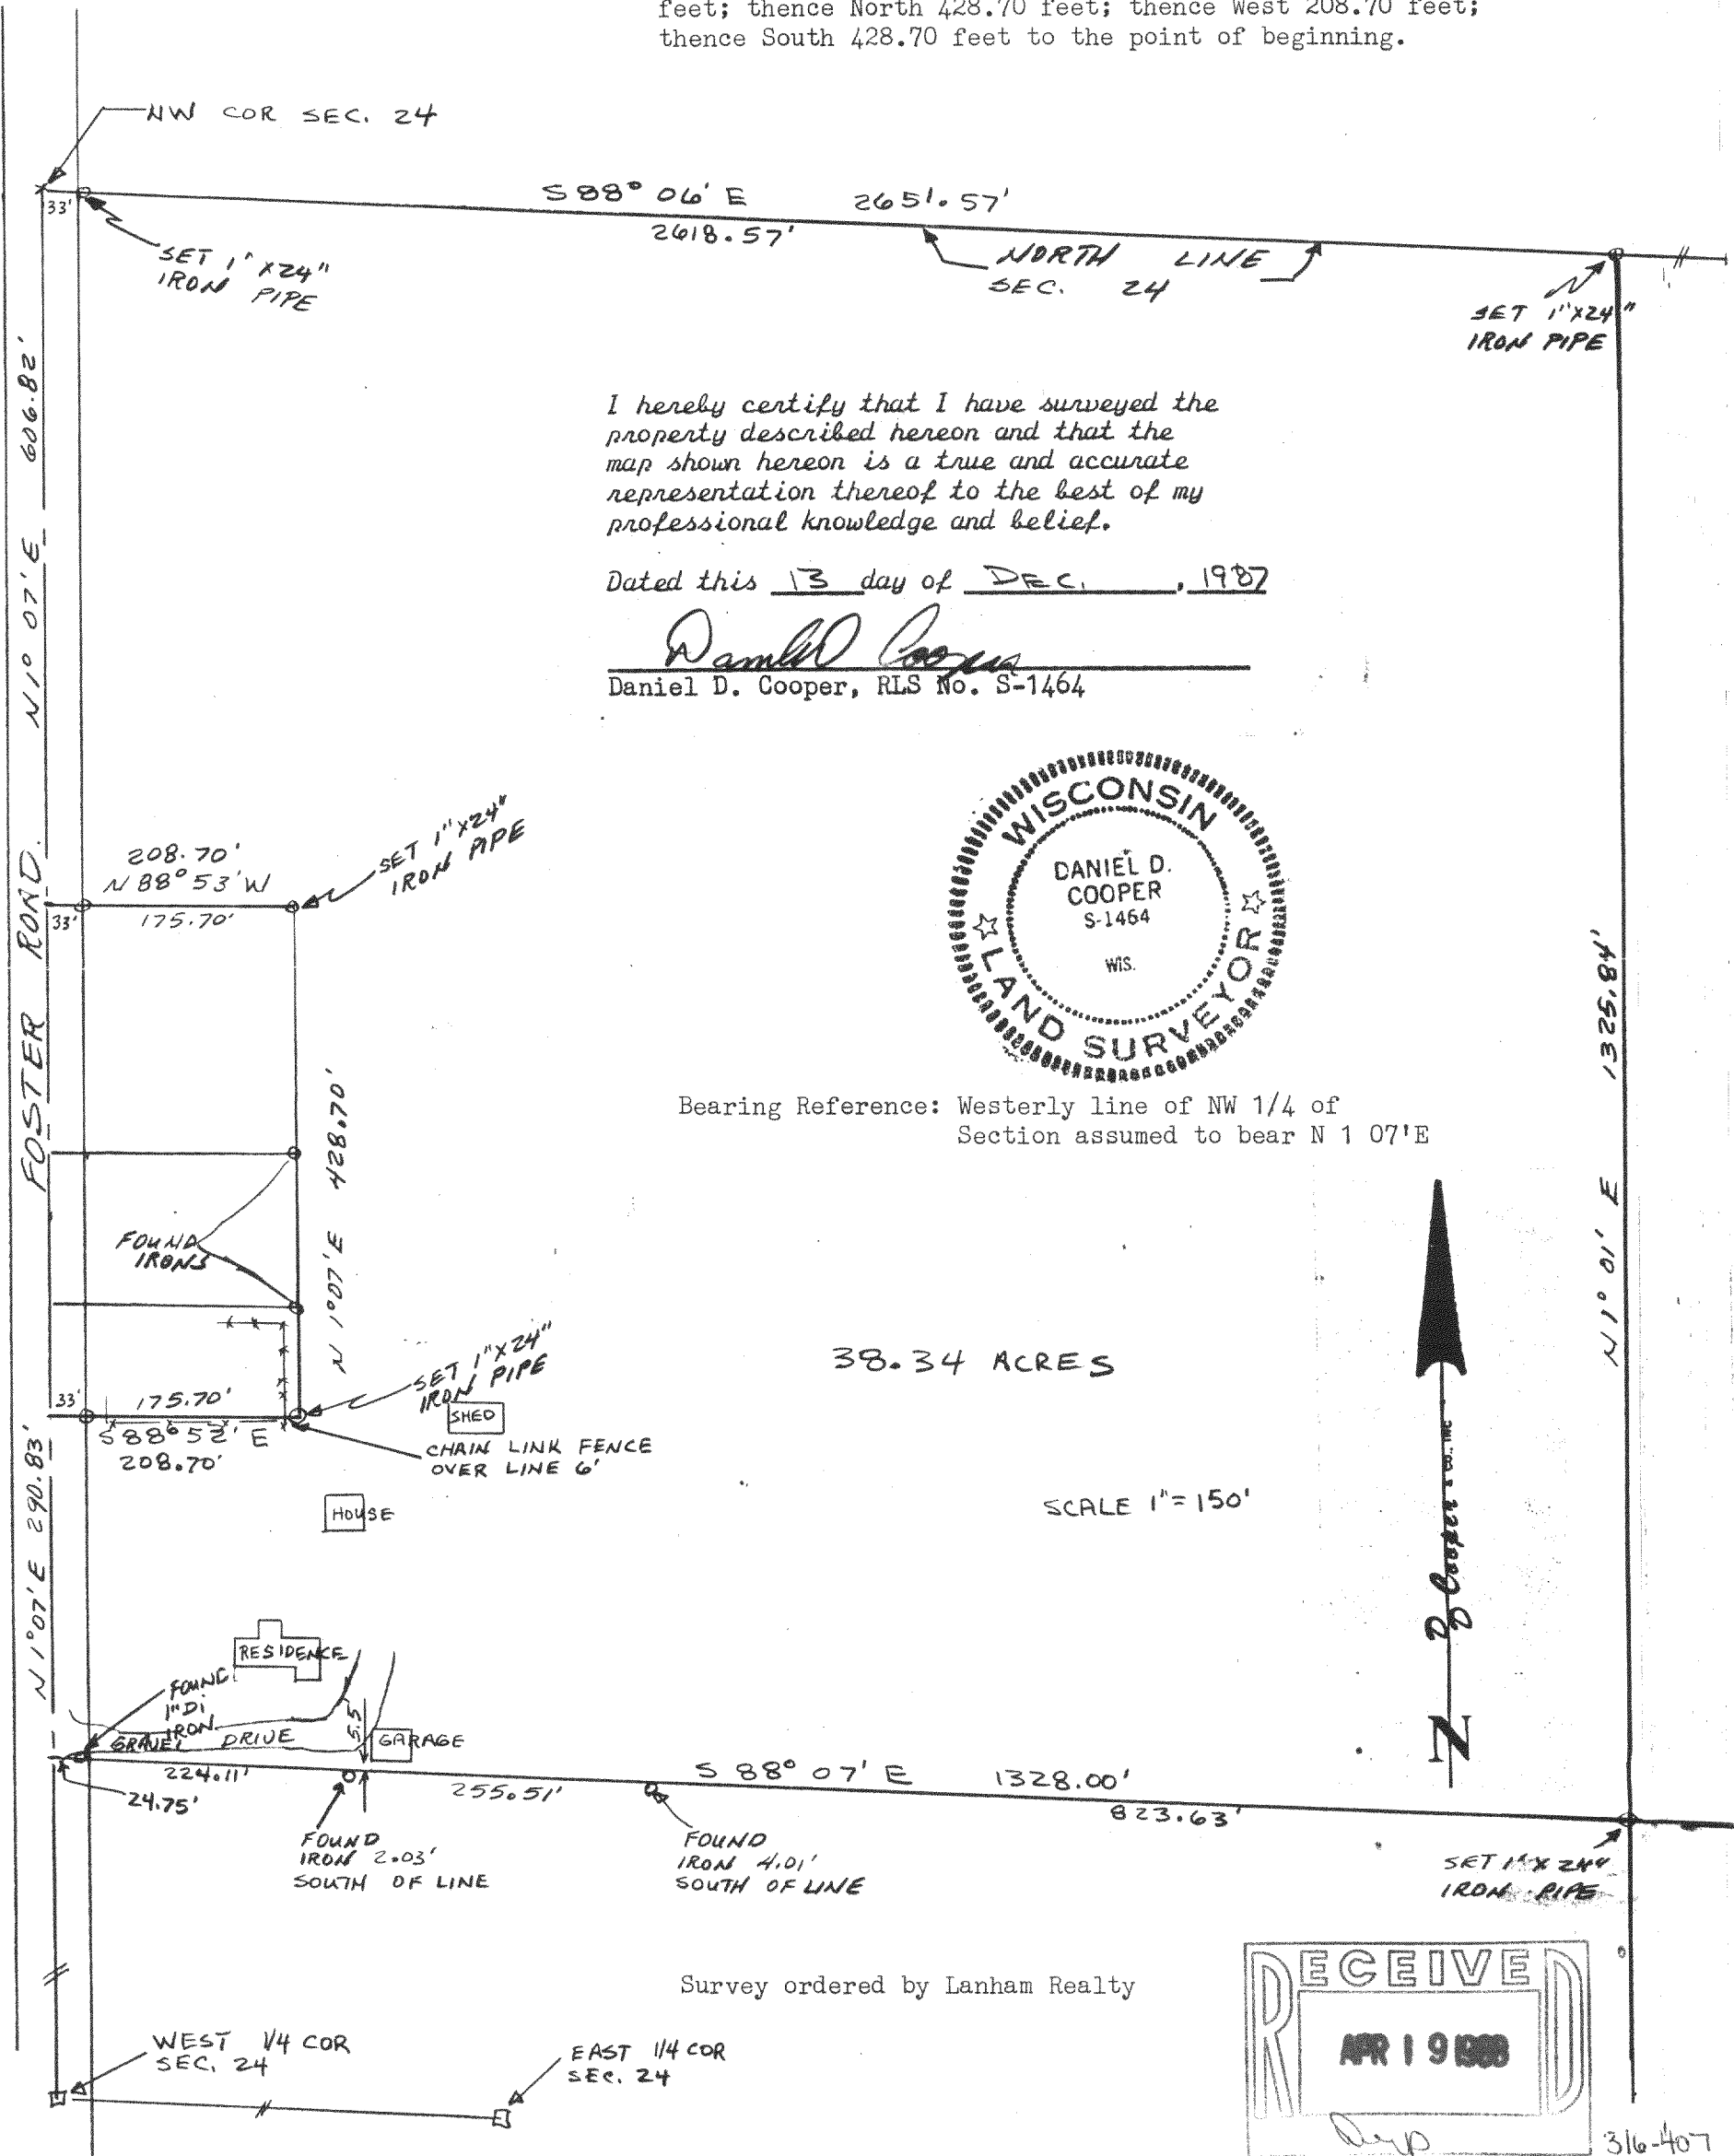

I hereby certify that I have surveyed the property described hereon and that the map shown hereon is a true and accurate representation thereof to the best of my professional knowledge and belief.

Dated this 13 day of DEC., 1987

Daniel D. Cooper
Daniel D. Cooper, RLS No. S-1464

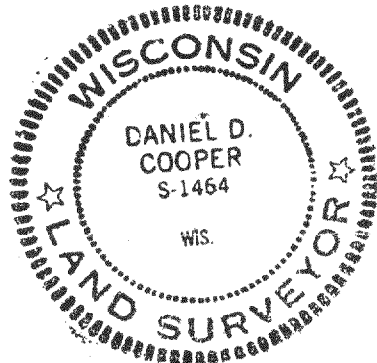

Bearing Reference: Westerly line of NW 1/4 of Section assumed to bear N 1 07'E

38.34 ACRES

SCALE 1" = 150'

