


PLAT OF SURVEY OF LOTS 22 & 23 BLOCK
62 OF THE 4TH MAP OF INTERLAKEN
SUBDIVISIONS LOCATED IN THE TOWN
OF SUGAR CREEK WALWORTH COUNTY
WISCONSIN

ELSIE WEBER ESTATE

SURVEY ORDERED BY LANHAM REALTY


SCALE 1" = 20'

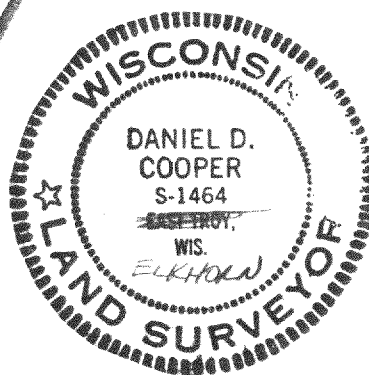

I, DANIEL D. COOPER, REGISTERED SURVEYOR, DO HEREBY CERTIFY THAT
I HAVE SURVEYED THE PROPERTY DESCRIBED HEREON AND THAT THE MAP
SHOWN HEREON IS A TRUE AND ACCURATE REPRESENTATION THEREOF TO THE
BEST OF MY PROFESSIONAL KNOWLEDGE AND BELIEF.

DATED THIS 15 DAY OF MAR., 1986

Daniel D Cooper
DANIEL D. COOPER, RLS NO. S-1464

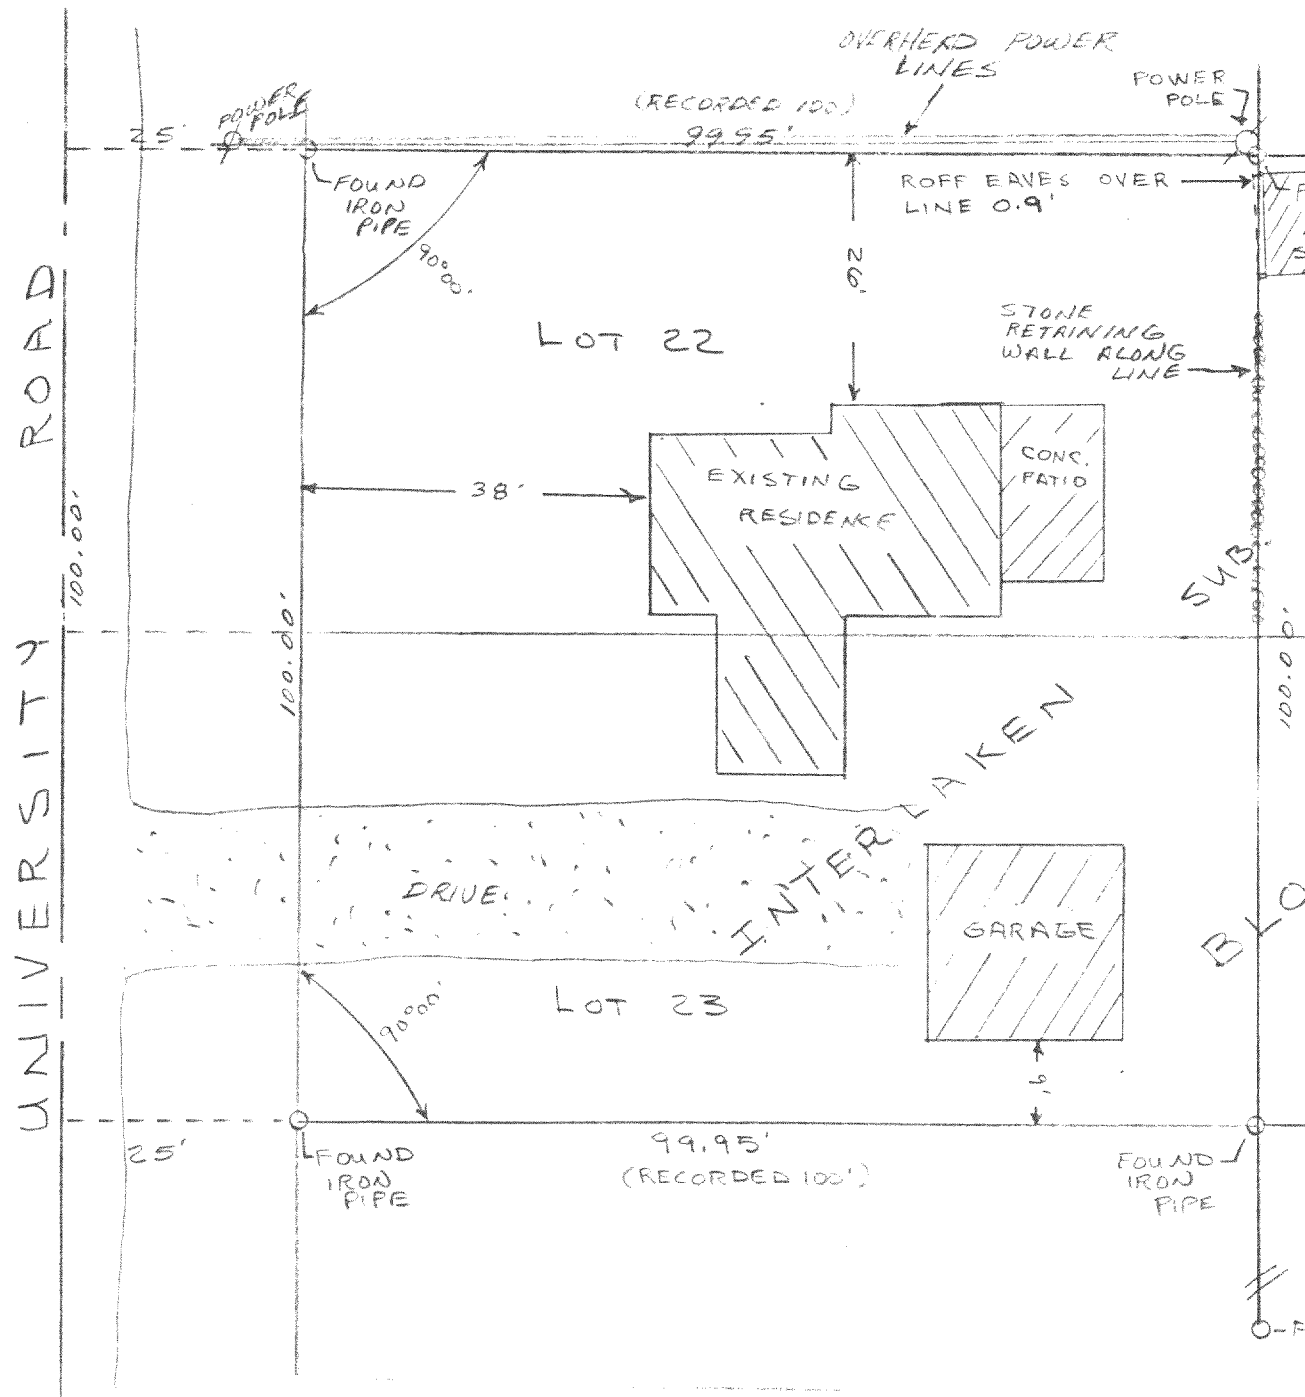

D.D. COOPER & CO. INC.

Route 4 Box 508B
Elkhorn WI 53121
Phone-414-723-6265

DRAWING NO. 21