


GEORGE T. DUNHAM
SURVEYING & SUBDIVIDING
DELAVER, WISCONSIN

N



Scale - 1" = 20'

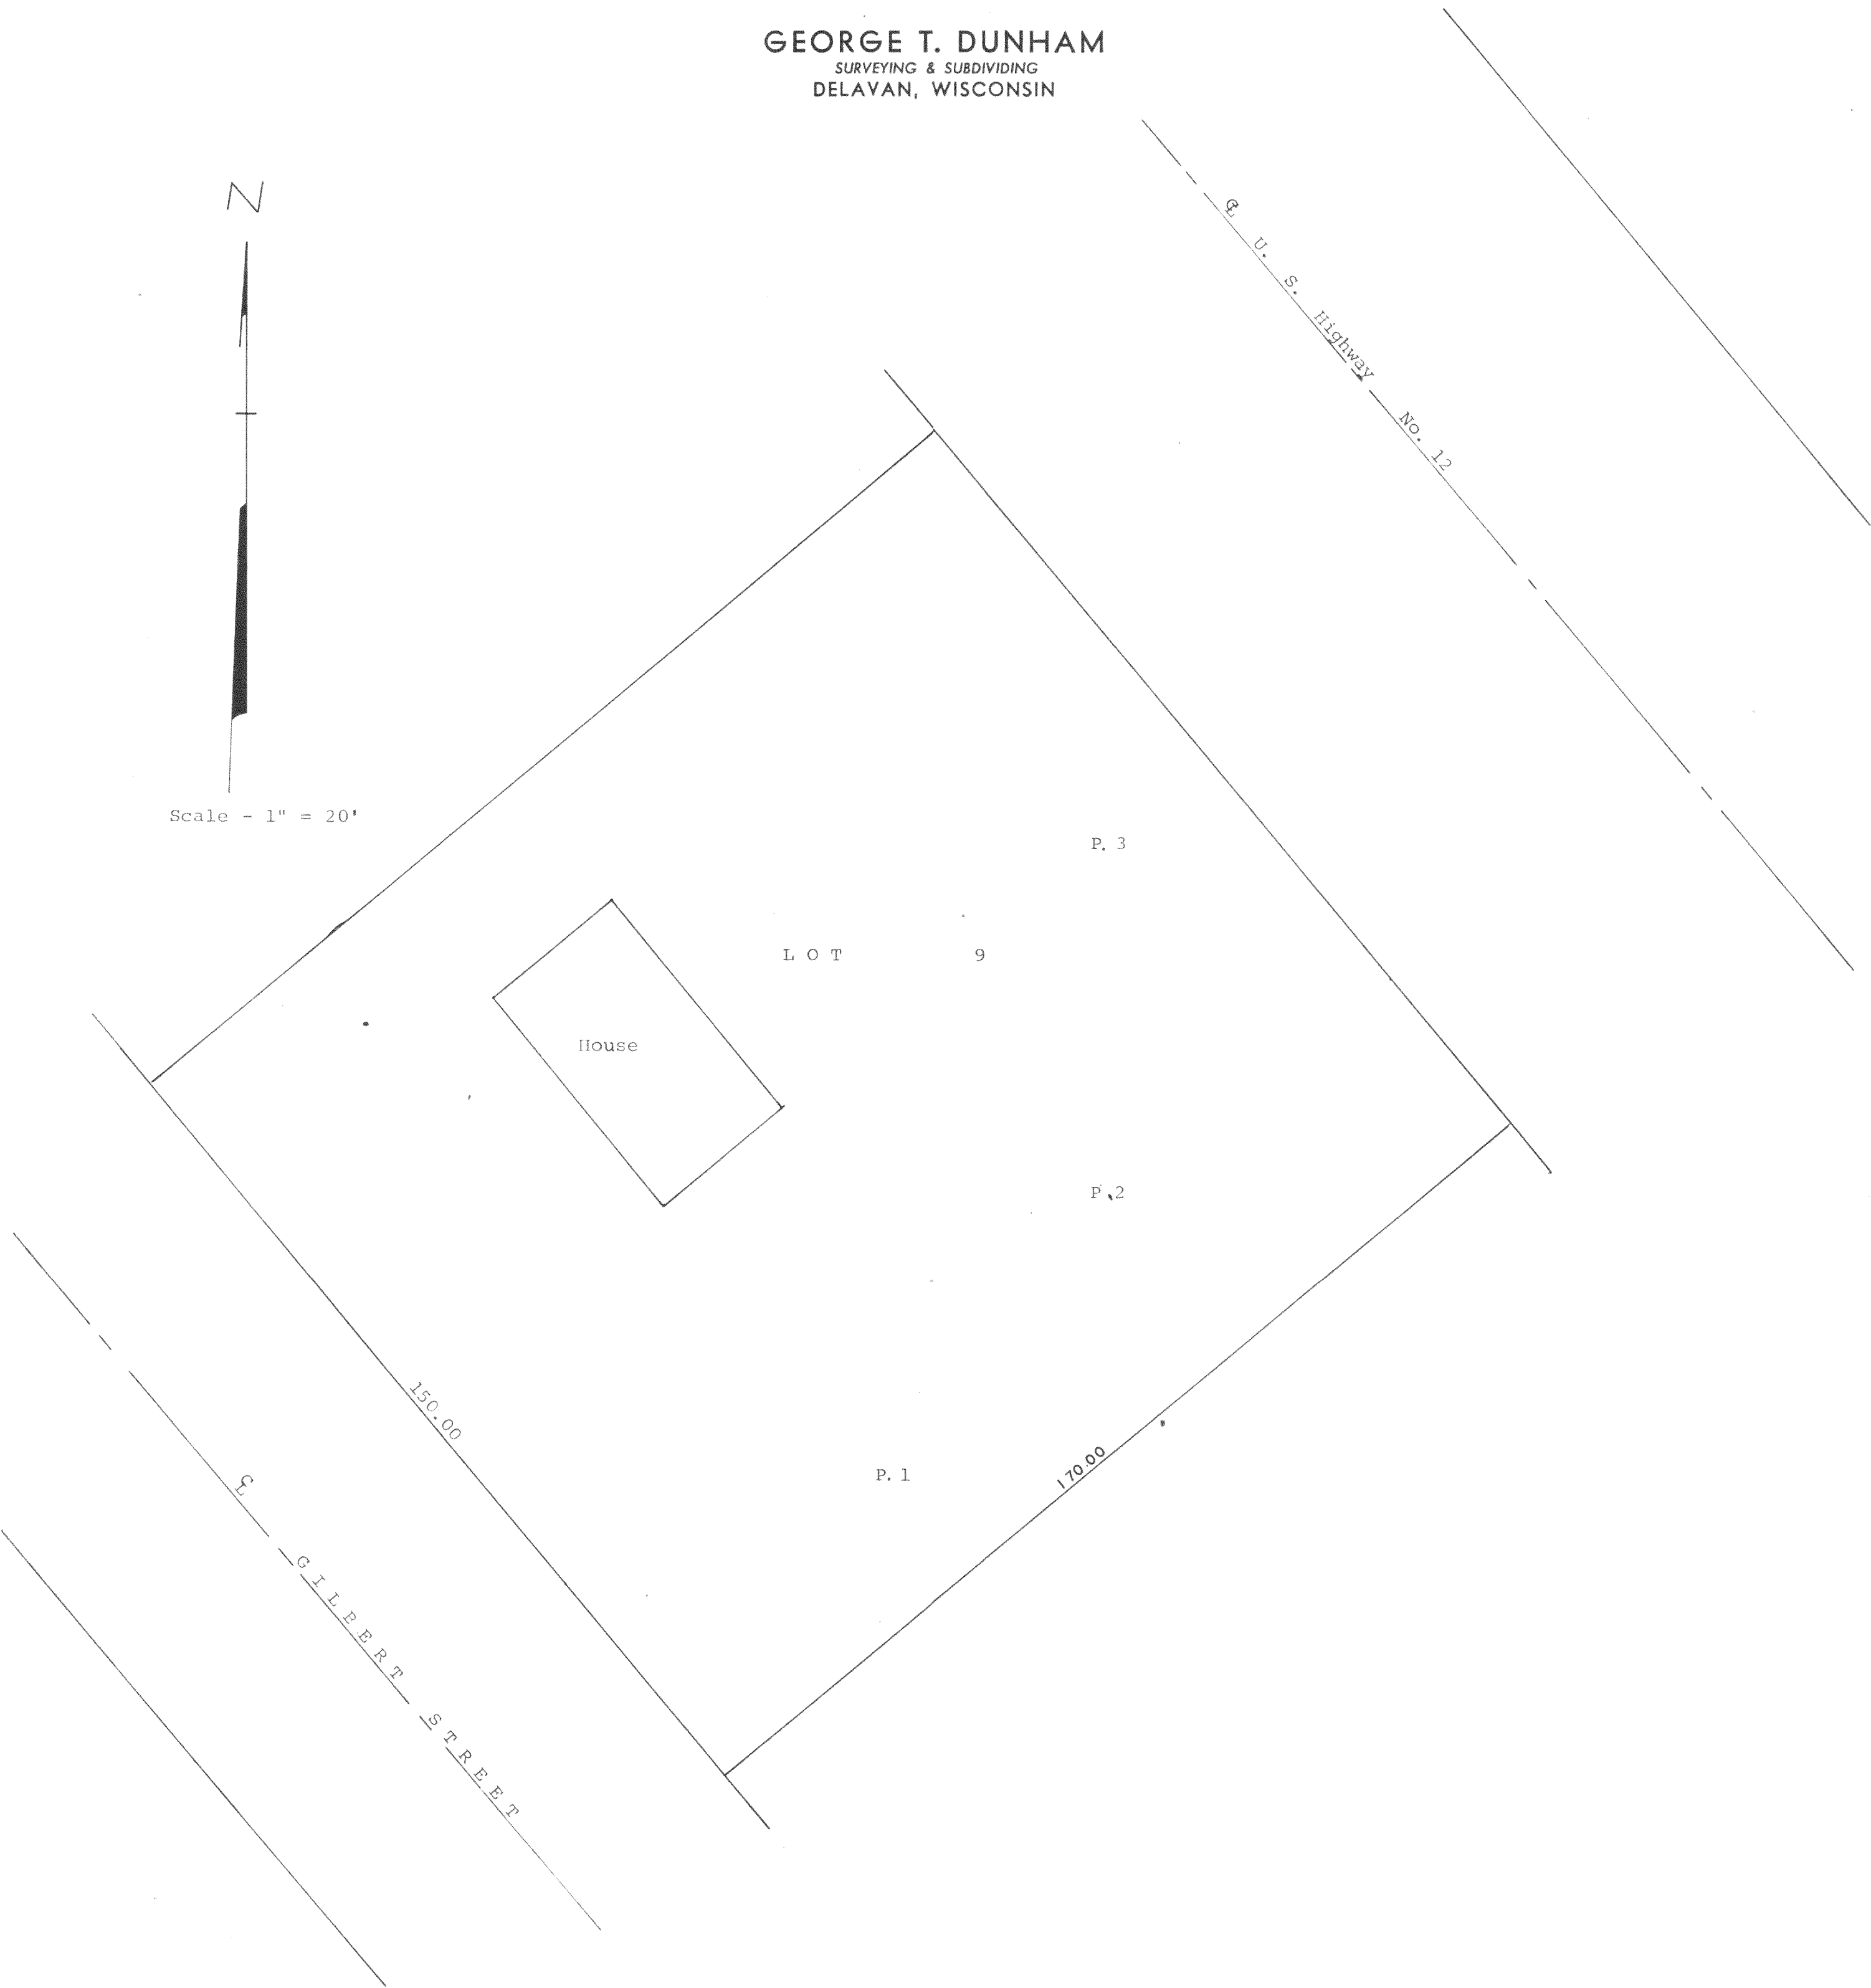

Plat showing location of percolation tests on
Lot 9, Bethel Heights located in Section 12,
T 3 N, R 16 E, Walworth County, Wisconsin.
May 18, 1967

George T. Dunham
George T. Dunham, Surveyor