

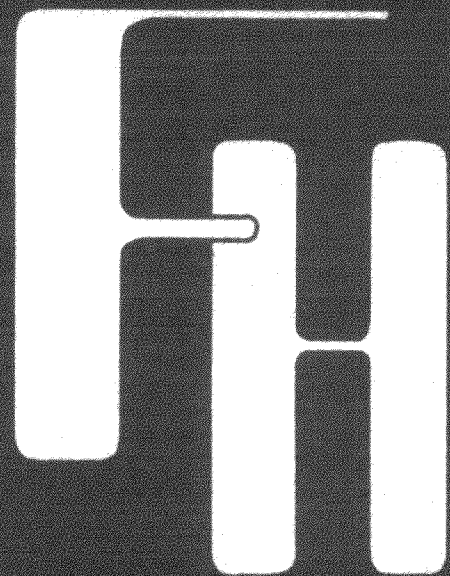


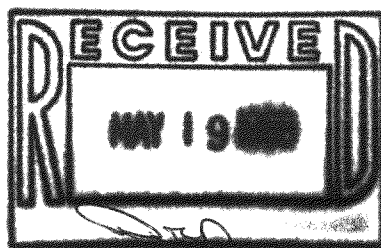

FARRIS, HANSEN & ASSOCIATES, INC.
Engineering, Surveying and Land Planning
715 W. Walworth St. P. O. Box 487
ELKHORN, WISCONSIN 53121
Office: (414) 723-2098

CSM # 287
JOHN & FRANCES HIMSL OWNER

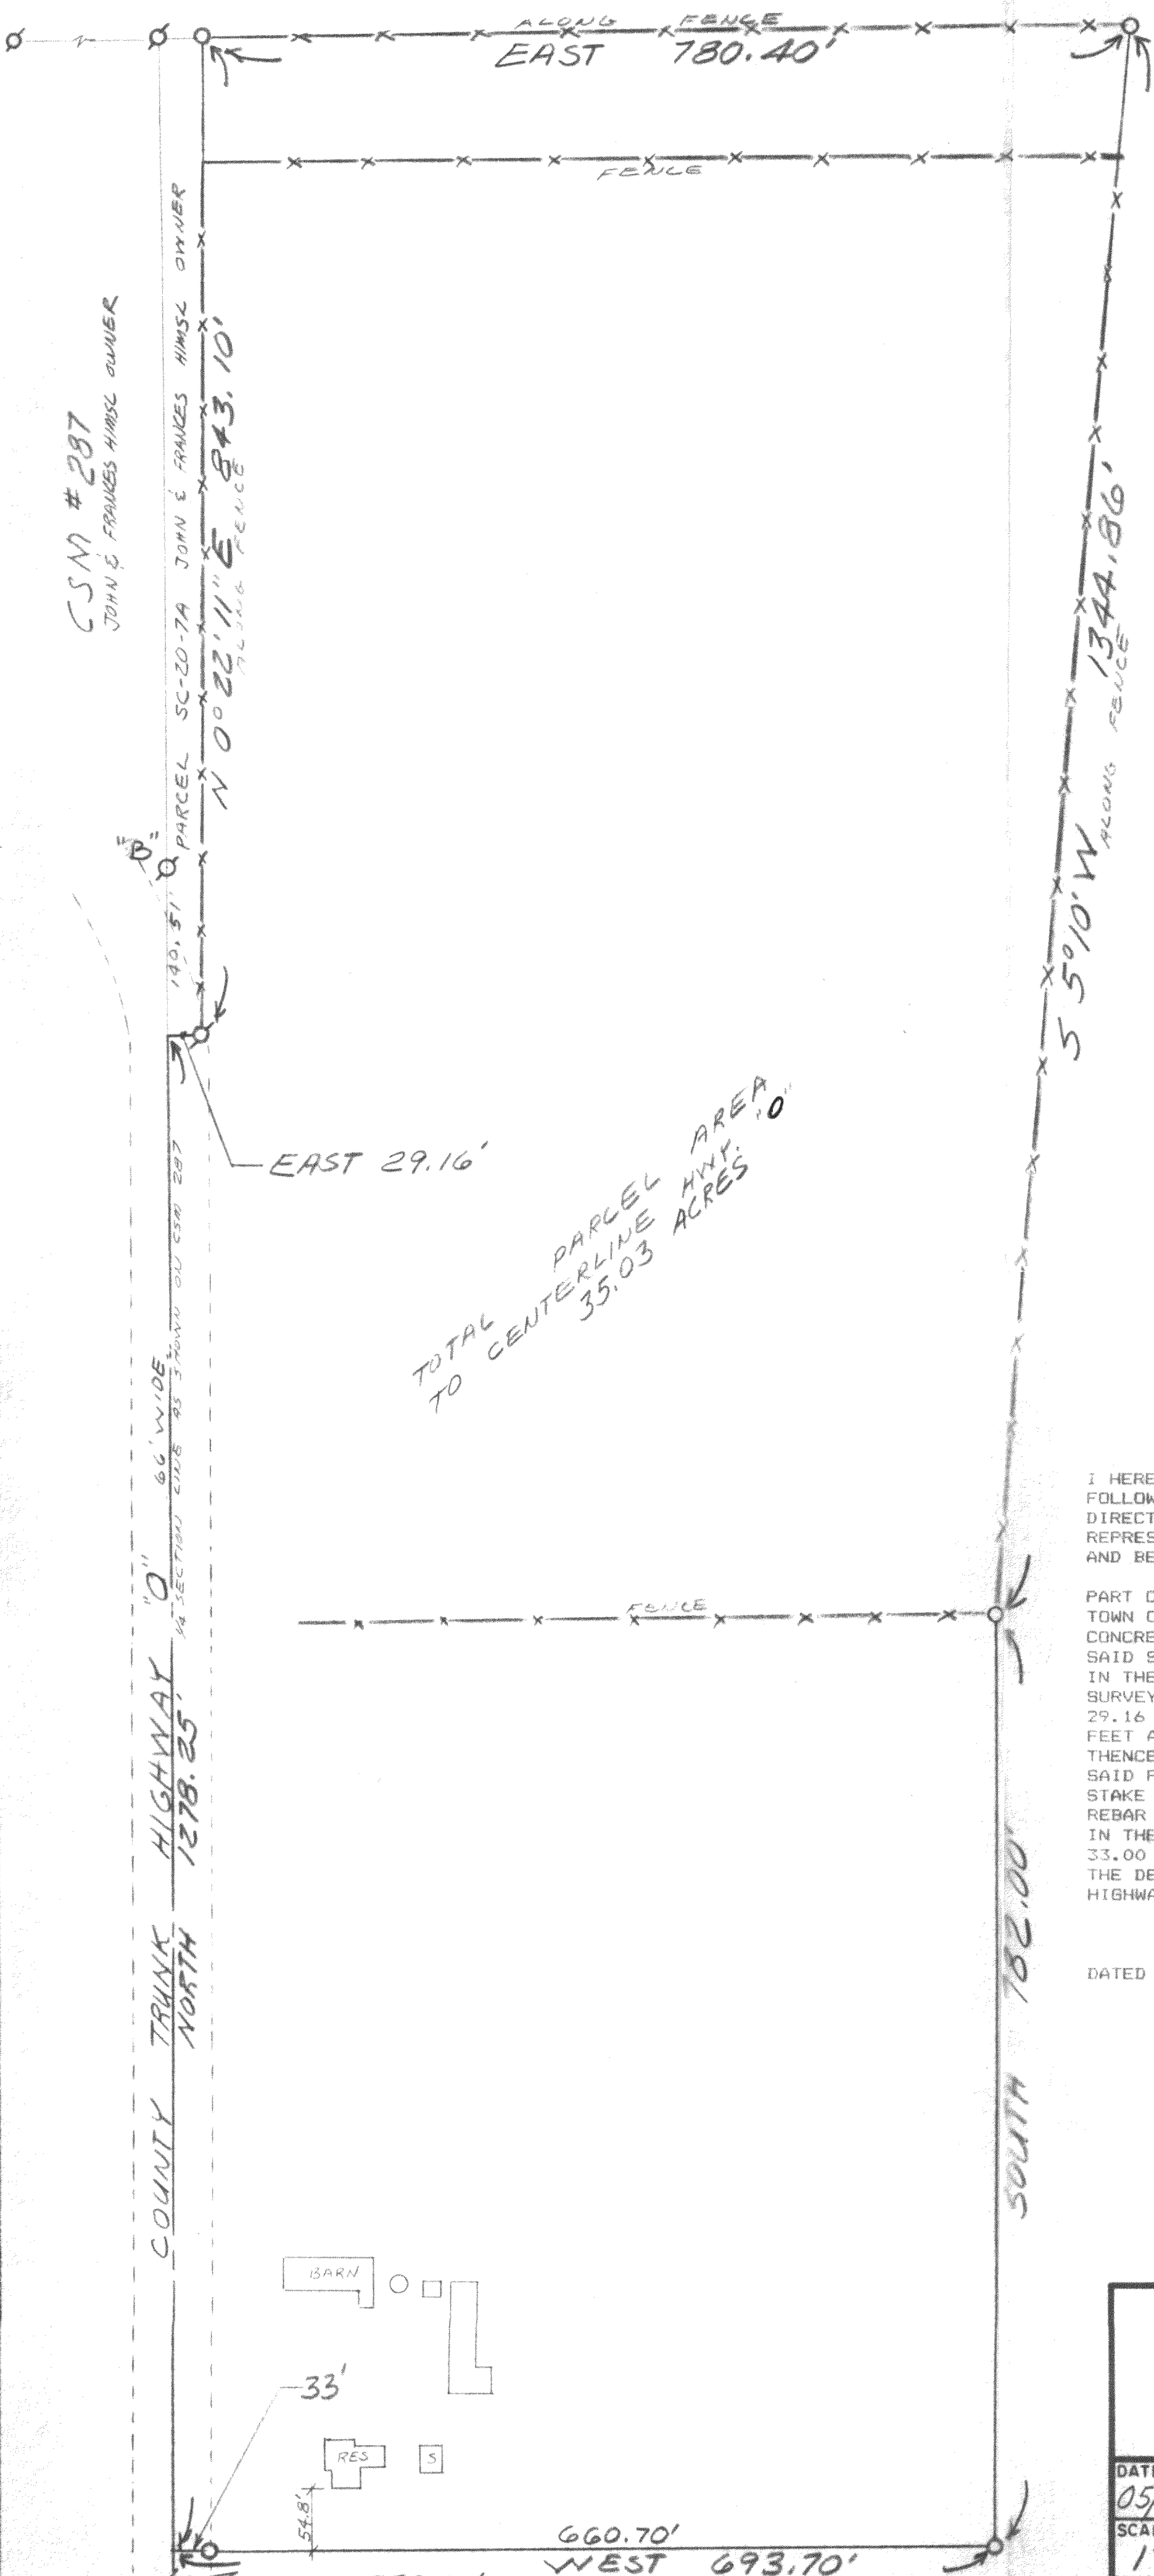

N

LINE A-B
ASSIGNED BRS.
NORTH AS
SHOWN ON
CSM # 287


○ = IRON PIPE SURVEY STAKE FOUND
□ = 3/4" X 24" IRON REBAR STAKE SET

I HEREBY CERTIFY THAT AT THE DIRECTION OF JAMES O. JACOBSEN THE FOLLOWING DESCRIBED LANDS SHOWN HEREON HAVE BEEN SURVEYED UNDER MY DIRECTION AND THAT THIS PLAT OF SURVEY IS A TRUE AND ACCURATE REPRESENTATION OF SAID SURVEY TO THE BEST OF MY PROFESSIONAL KNOWLEDGE AND BELIEF:

PART OF THE SOUTHEAST 1/4 OF SECTION 20, TOWN 3 NORTH, RANGE 16 EAST, TOWN OF SUGAR CREEK, WALWORTH COUNTY, WISCONSIN COMMENCING AT A CONCRETE COUNTY MONUMENT FOUND MARKING THE SOUTH 1/4 SECTION CORNER OF SAID SECTION 20; THENCE NORTH 529.20 FEET TO THE POINT OF BEGINNING IN THE 1/4 SECTION LINE AS SAID LINE WAS MONUMENTED IN CERTIFIED SURVEY MAP # 287; THENCE CONTINUE NORTH 1278.25 FEET; THENCE EAST 29.16 FEET TO AN IRON PIPE FOUND; THENCE N 0DEG 22MIN 11SEC E 843.10 FEET ALONG THE EAST LINE OF LANDS OWNED BY JOHN & FRANCES HIMSL; THENCE EAST 780.40 FEET ALONG A FENCE TO AN IRON REBAR STAKE SET IN SAID FENCE; THENCE S 5DEG 10MIN W 1344.86 FEET TO AN IRON REBAR STAKE SET AT A FENCE CORNER; THENCE SOUTH 782.00 FEET TO AN IRON REBAR STAKE SET; THENCE WEST 660.70 FEET TO AN IRON REBAR STAKE SET IN THE EASTERLY RIGHT OF WAY OF HIGHWAY "0"; THENCE CONTINUE WEST 33.00 FEET TO THE POINT OF BEGINNING, CONTAINING 35.03 ACRES OF LAND. THE DESCRIBED PARCEL IS SUBJECT TO THE RIGHTS OF THE PUBLIC IN AND TO HIGHWAY "0" AND TO ANY OTHER EASEMENTS OF RECORD.

DATED THIS 3RD DAY OF MAY, 1988

Robert A. Farris
ROBERT A. FARRIS RLS

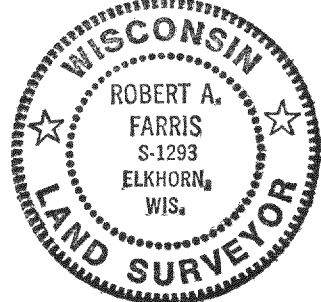

PLAT OF SURVEY IN SE 1/4 20-3-16
FOR
JAMES O. JACOBSEN

DATE 05/03/88	DRAWN BY RF	REVISIONS	BY	DATE	PROJECT NO. 3001
SCALE 1"=100'	CHECKED BY				LAST REVISION
	APPROVED BY				SHEET NO.