



Plat of Survey of Lot 33 of Sylvan Trace Subdivision being located in Section 2, Town 3 North, Range 16 East, Walworth County, Wisconsin.

Bearing reference:
Westerly line of parcel assumed
to bear N00°22'40"E as recorded

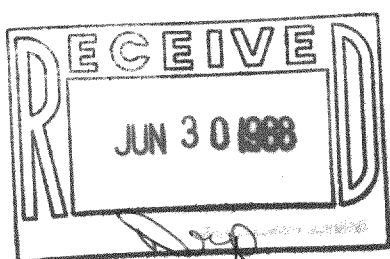

Scale 1"=60'

Survey ordered by Century 21
Elkhorn WI

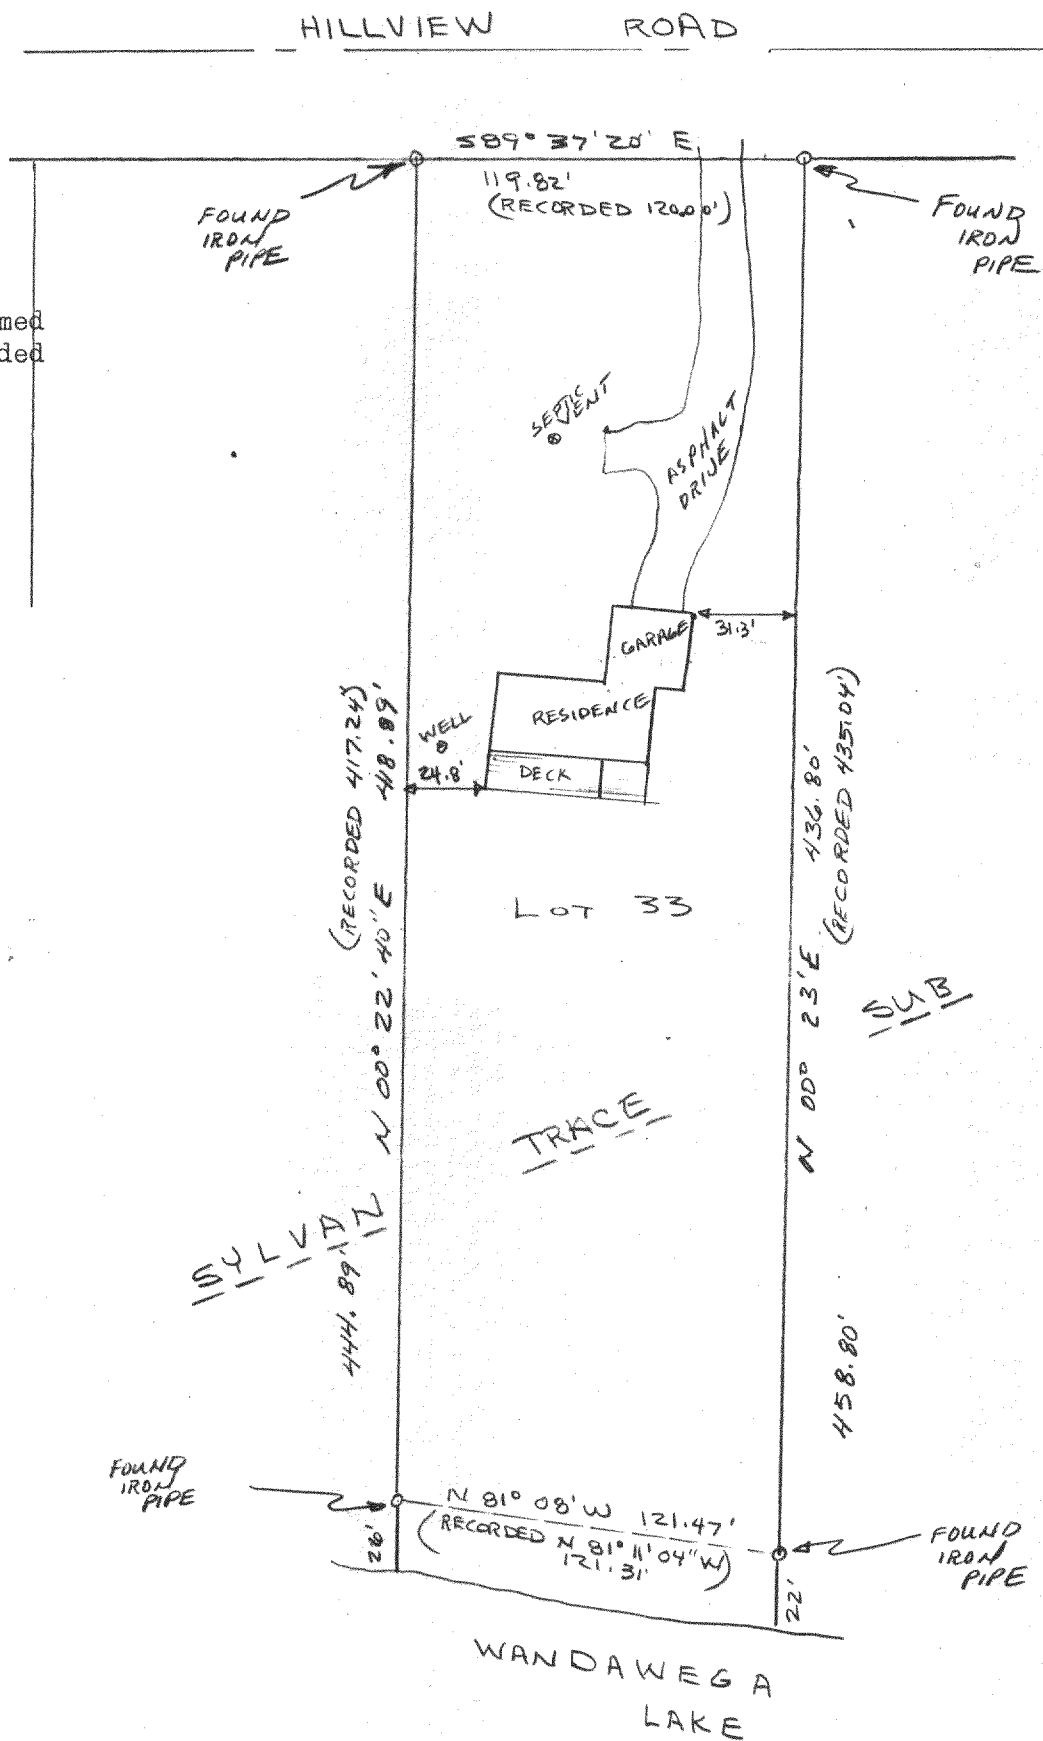

I hereby certify that I have surveyed the
property described hereon and that the
map shown hereon is a true and accurate
representation thereof to the best of my
professional knowledge and belief.

Dated this 19 day of May, 1988

Daniel D. Cooper
Daniel D. Cooper, RLS No. S-1464

