

Farris, Hansen & Associates, Inc.

7 RIDGEWAY COURT, P.O. BOX 487, ELKHORN, WISCONSIN

TEL. 414-723-2098

LOCATION: Lots 1, 2, the West $\frac{1}{2}$ of Lot 3 and all of Lot 15 MAP LEGEND

all in Block 22 of Interlaken, Town of Sugar Creek,
according to the recorded plat thereof.

WORK ORDERED BY:

Realty Executives (Susan Patajan)

MAP SCALE IN FEET

☉ = IRON PIPE STAKE FOUND

- * IRON PIPE STAKE SET

⊙ = IRON ROD STAKE FOUND

● - IRON ROD STAKE SET



■ CONCRETE MONUMENT FOUND

(XXXXX) = RECORD DIMENSION

[RV] : COORDINATE FILE CABLE



Laurel Pond Was Assumed
to bear N 31° 57' W as
shown on Orig. Sub. Plat

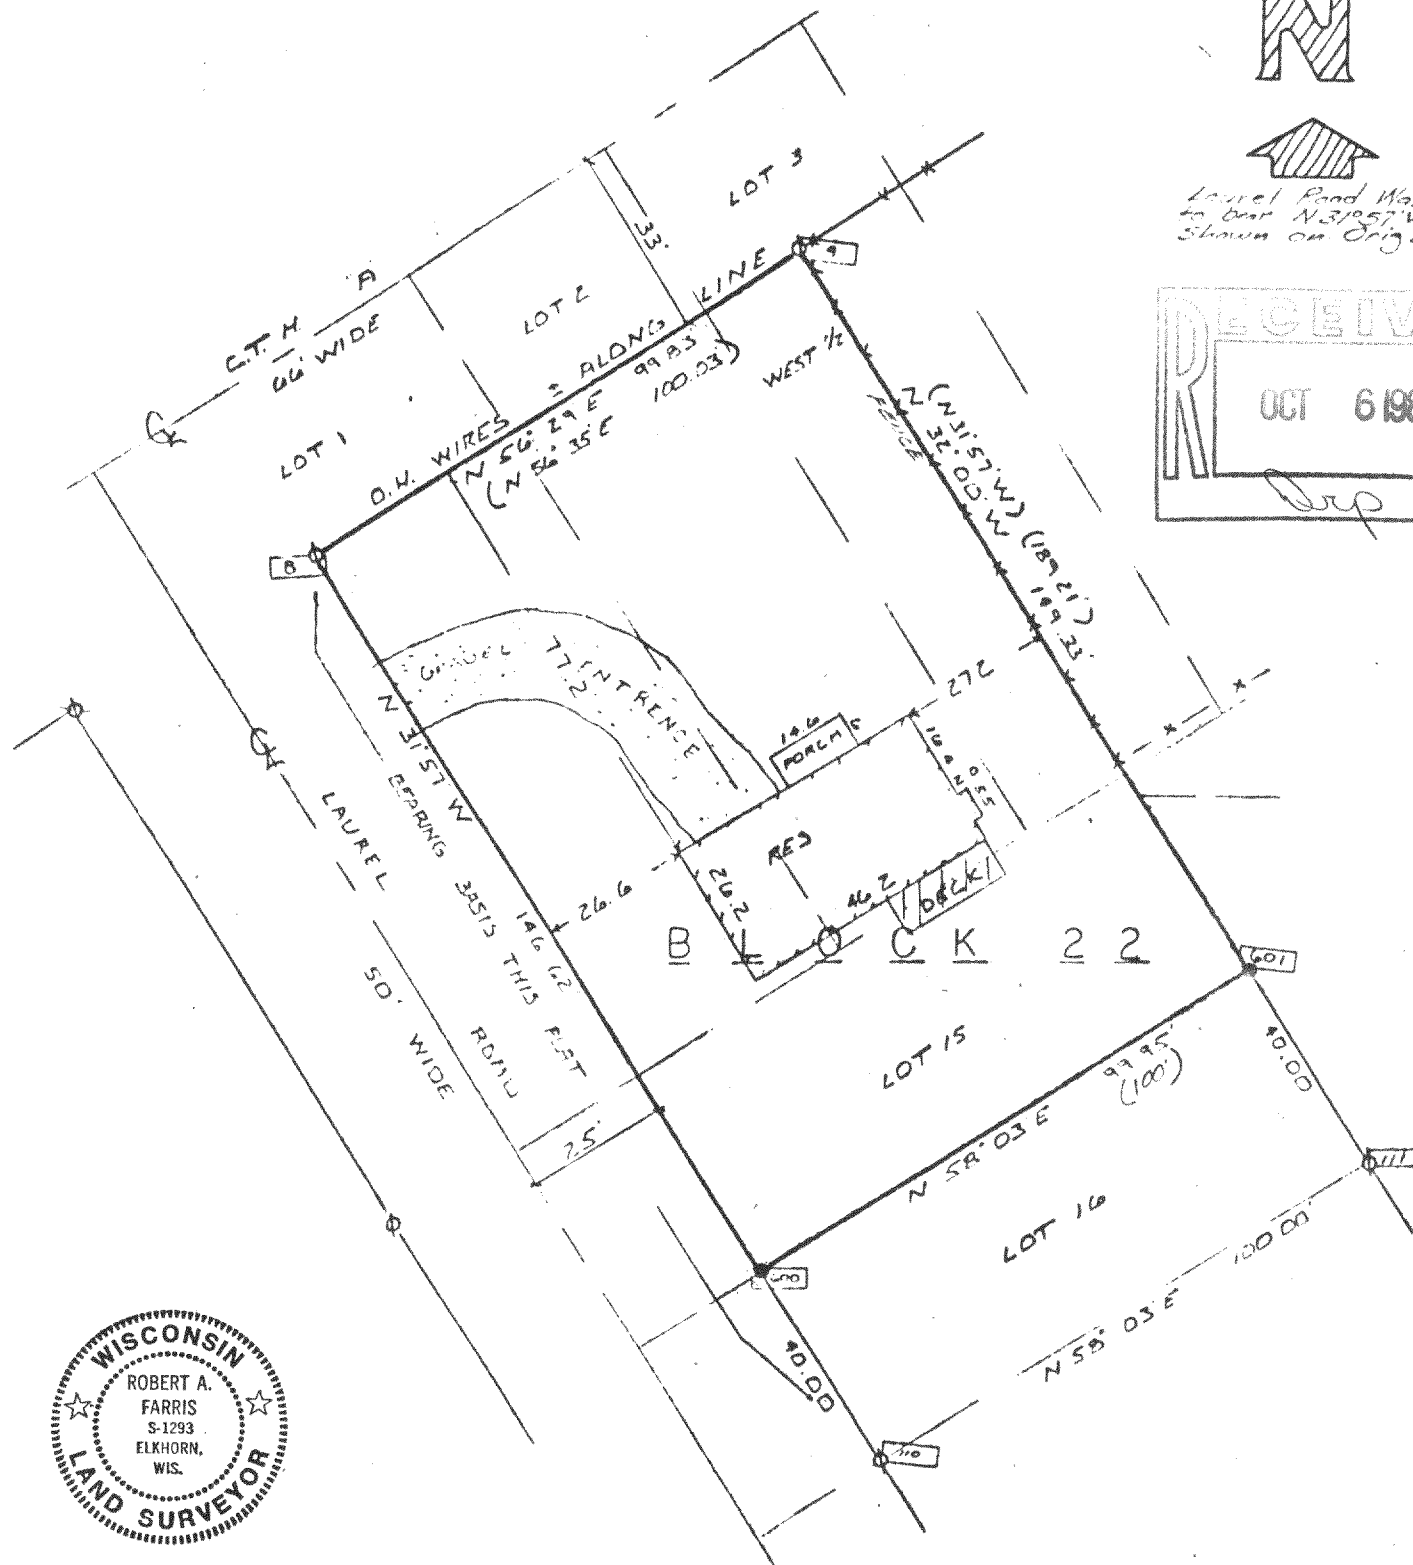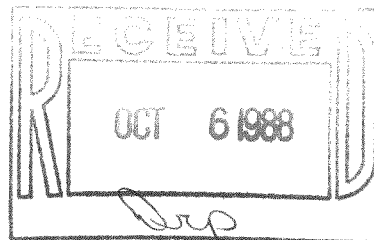

NOTE: COPIES OF THIS MAP TO WHICH THE FOLLOWING CERTIFICATE WILL APPLY ARE BLUE LINE PRINTS SHOWING SURVEYOR'S SEAL AND SIGNATURE IN BLACK INK. COPIES BY ANY OTHER MEANS MAY HAVE ALTERATIONS WHICH DO NOT REPRESENT THE SURVEYOR'S WORK PRODUCT.

I hereby certify that the above described property has been surveyed under my direction and that the above map is a true representation thereof and shows the size and location of the property, its exterior boundaries, the location of all visible structures and dimensions of all principal buildings thereon, boundary fences, apparent easements, roadways and visible encroachments, if any. This survey is made for the use of the present owners of the property, and also those who purchase, mortgage, or guarantee the title thereto within one year from the date hereof.

DATED : JUNE 29, 1988

PROJ. NO. 3051
316-423