

PLAT OF SURVEY

of

The East line of Lot 33 of Baywood Estates 1st Addition,
located in Sections 1 and 2, Town 3 North, Range 16 East,
Walworth County, Wisconsin.

Surveyed for: Kevin Parker
515 Edgewood
Elkhorn, Wisconsin. 53121

Land owned by: Carlo Ippolito

Surveyed by: Jensen Surveying & Mapping S.C.
45 South Wisconsin Street
Elkhorn, Wisconsin. 53121


Mapping date: December 1, 1988

Bearings referenced to the Subdivision
Plat of Baywood Estates 1st Addition.


Scale: 1"=30'

LEGEND

○ ~ Found iron pipe

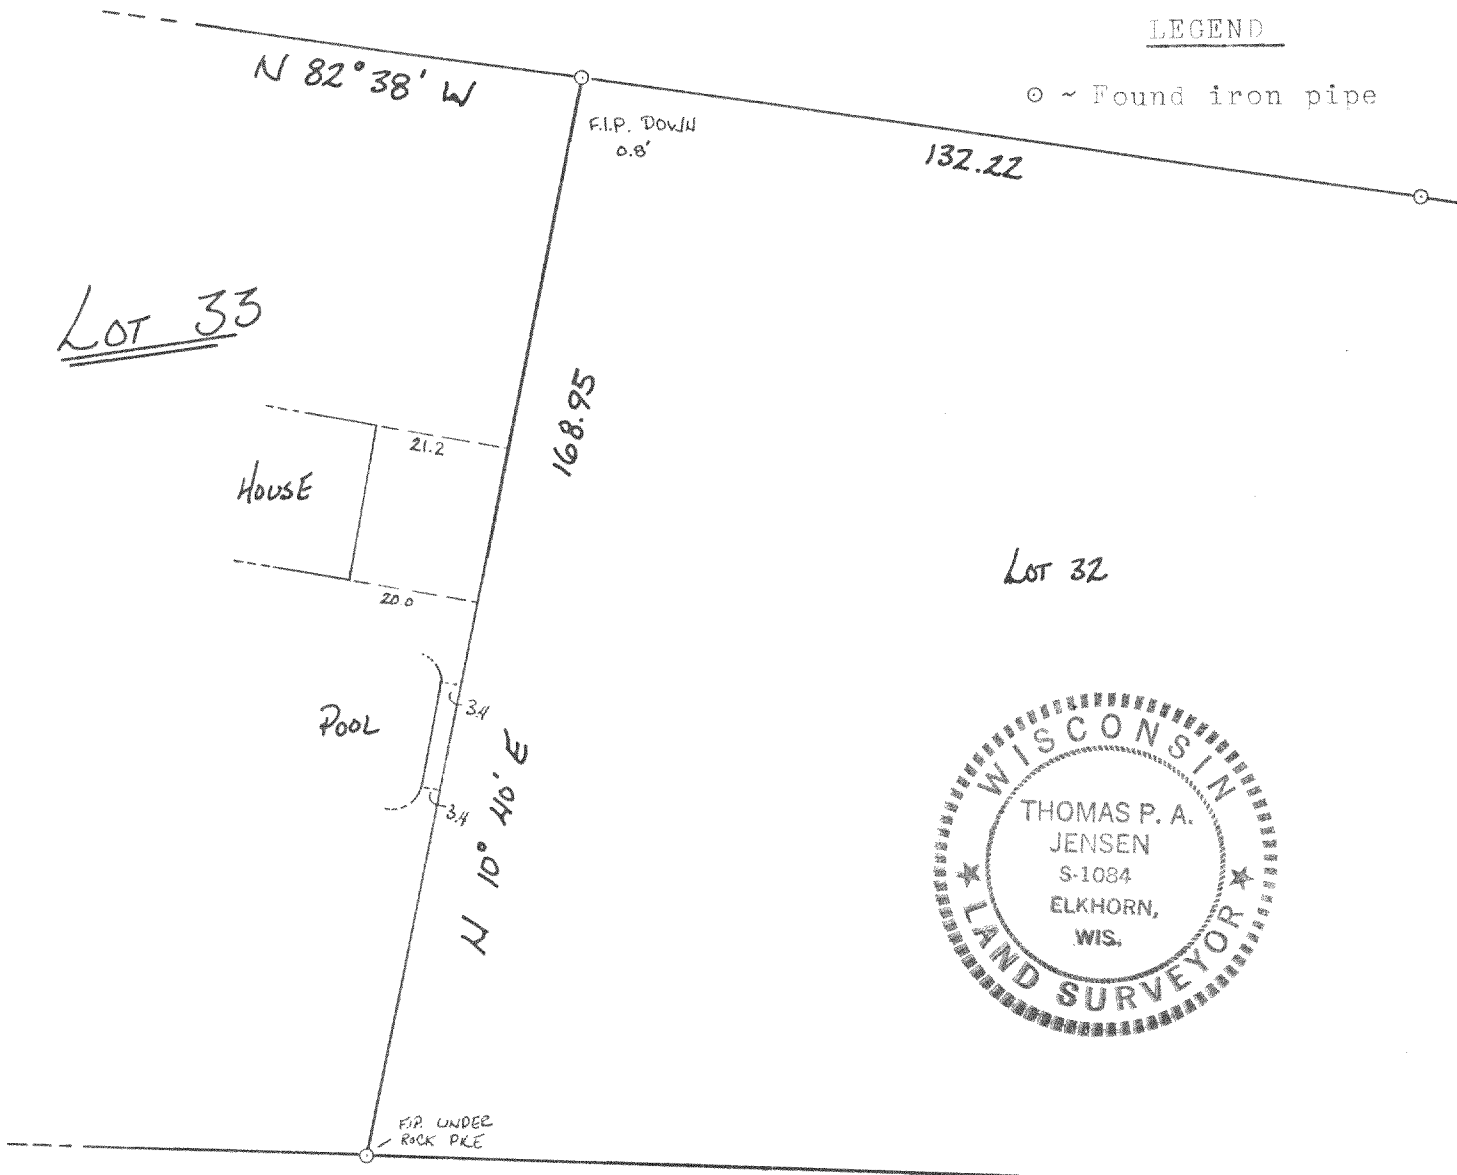

I, Thomas P.A. Jensen, Wisconsin Registered Land Surveyor,
do hereby certify that the East line of said Lot 33 was
surveyed, under my direction, in full compliance with the
owner's/agent's instructions and Chapter A-E 7 of the Wis-
consin Administrative Code "Minimum Standards For Property
Surveys"; and that this map is an accurate representation
thereof to the best of my knowledge and belief.

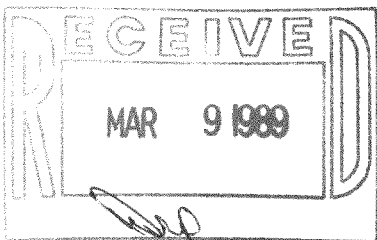

Thomas P.A. Jensen
Thomas P.A. Jensen S-1084

1988.135 X

Copyright © 1988 by Jensen Surveying & Mapping S.C.

All rights reserved. No part of this survey plat may be
reproduced or transmitted in any form by any means - graphic,
electronic, or mechanical, including photocopying, tracing, or
information storage and retrieval systems - without permission in
writing from Thomas P.A. Jensen, Jensen Surveying & Mapping S.C.

Note: This survey plat is not
certified unless signed
and sealed in red ink.