

PLAT OF SURVEY

North Eastern 1/2 of lot 4, and all of Lots 5 & 6, and 24 thru 27 Block 21, of Interlaken Subdivision, located in Section 11, Town 3 North, Range 10 East, Town of Sugar Creek, Walworth County, Wisconsin.



Surveyed for: William A Carl
627 Montrose Drive
Pompeo, Ill. 60441

Surveyed by: Jensen Surveying & Mapping S.C.
45 South Wisconsin Street
Elkhorn, Wisconsin. 53121

Mapping Date, December 8, 1988

LEGEND

- Found Concrete Monument
- Found Iron Pipe
- Set Iron Pipe

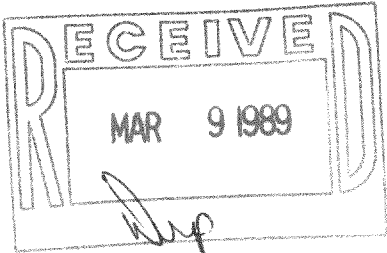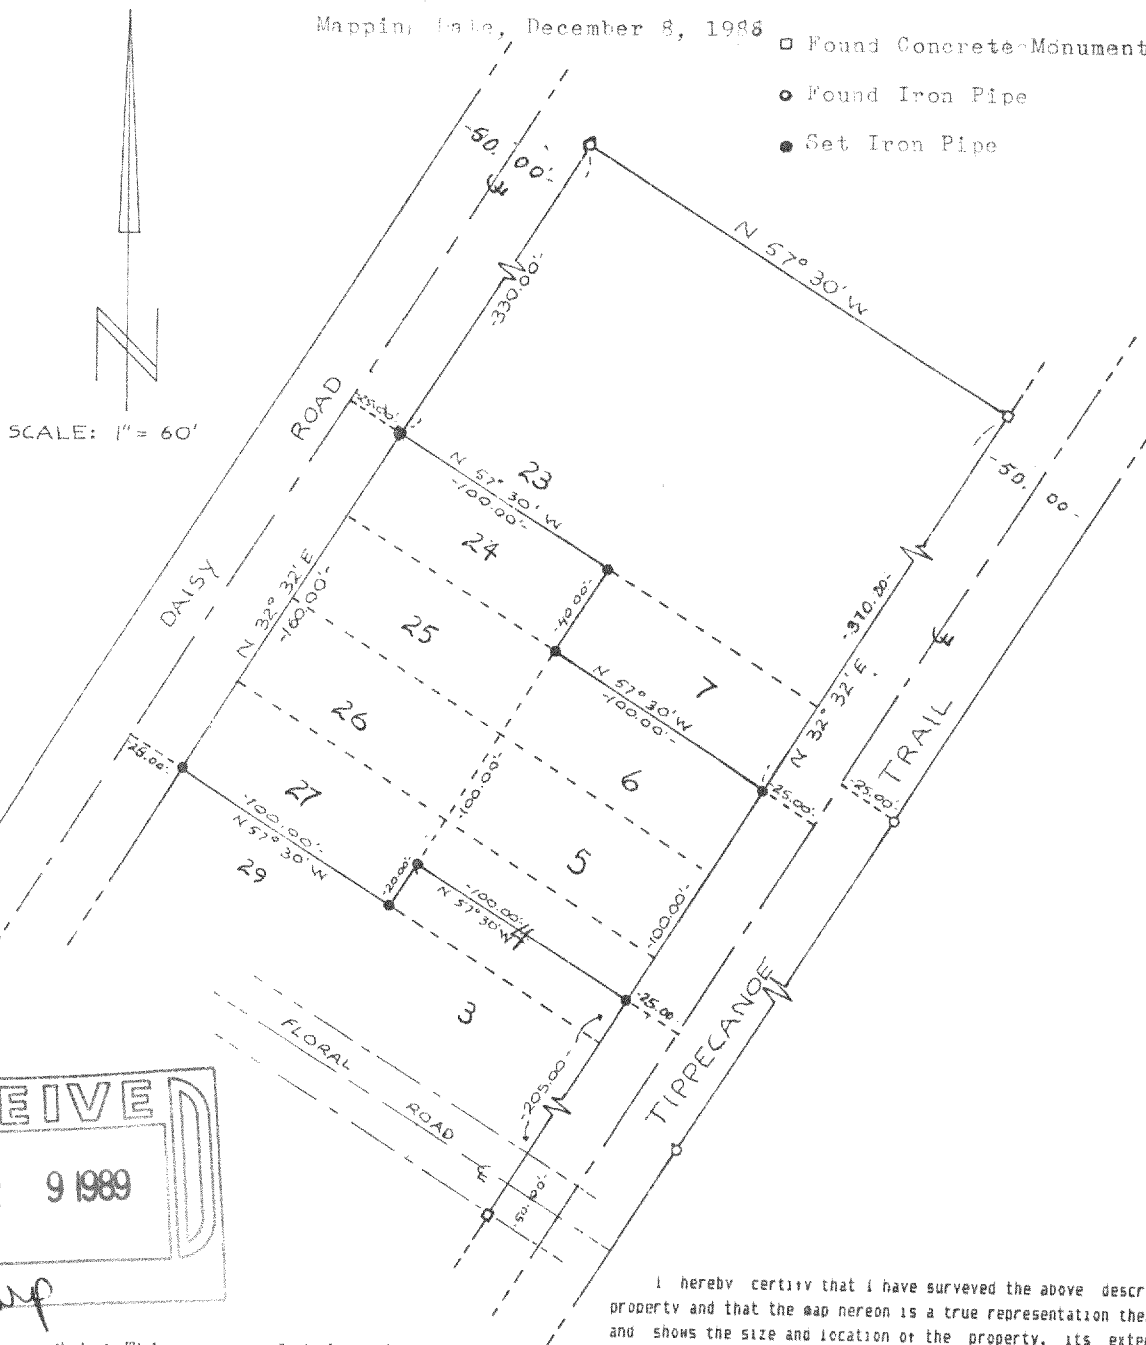

Note: This survey plat is not certified unless signed and sealed in red ink.

I hereby certify that I have surveyed the above described property and that the map hereon is a true representation thereof and shows the size and location of the property, its exterior boundaries, the location of all visible structures and dimensions of all principal buildings thereon, boundary fences, apparent easements, roadways and visible encroachments, if any.

This survey is made for the use of the present owners of the property and also those who purchase, mortgage, or guarantee the title thereto within one year from date hereof.

Copyright © 1988 by Jensen Surveying & Mapping S.C.

All rights reserved. No part of this survey plat may be reproduced or transmitted in any form by any means - graphic, electronic, or mechanical, including photocopying, tracing, or information storage and retrieval systems - without permission in writing from Thomas P.A. Jensen, Jensen Surveying & Mapping S.C.

THOMAS P. A. JENSEN
WISCONSIN REGISTERED LAND SURVEYOR. S-1084

316-431

61-436
61-441A

1988.072

