



PLAT OF SURVEY OF LOT 28, STRAWBERRY BANKE PLANTATION.
ADDITION NO. 1, T3N, R16E, WALWORTH COUNTY, WISCONSIN.

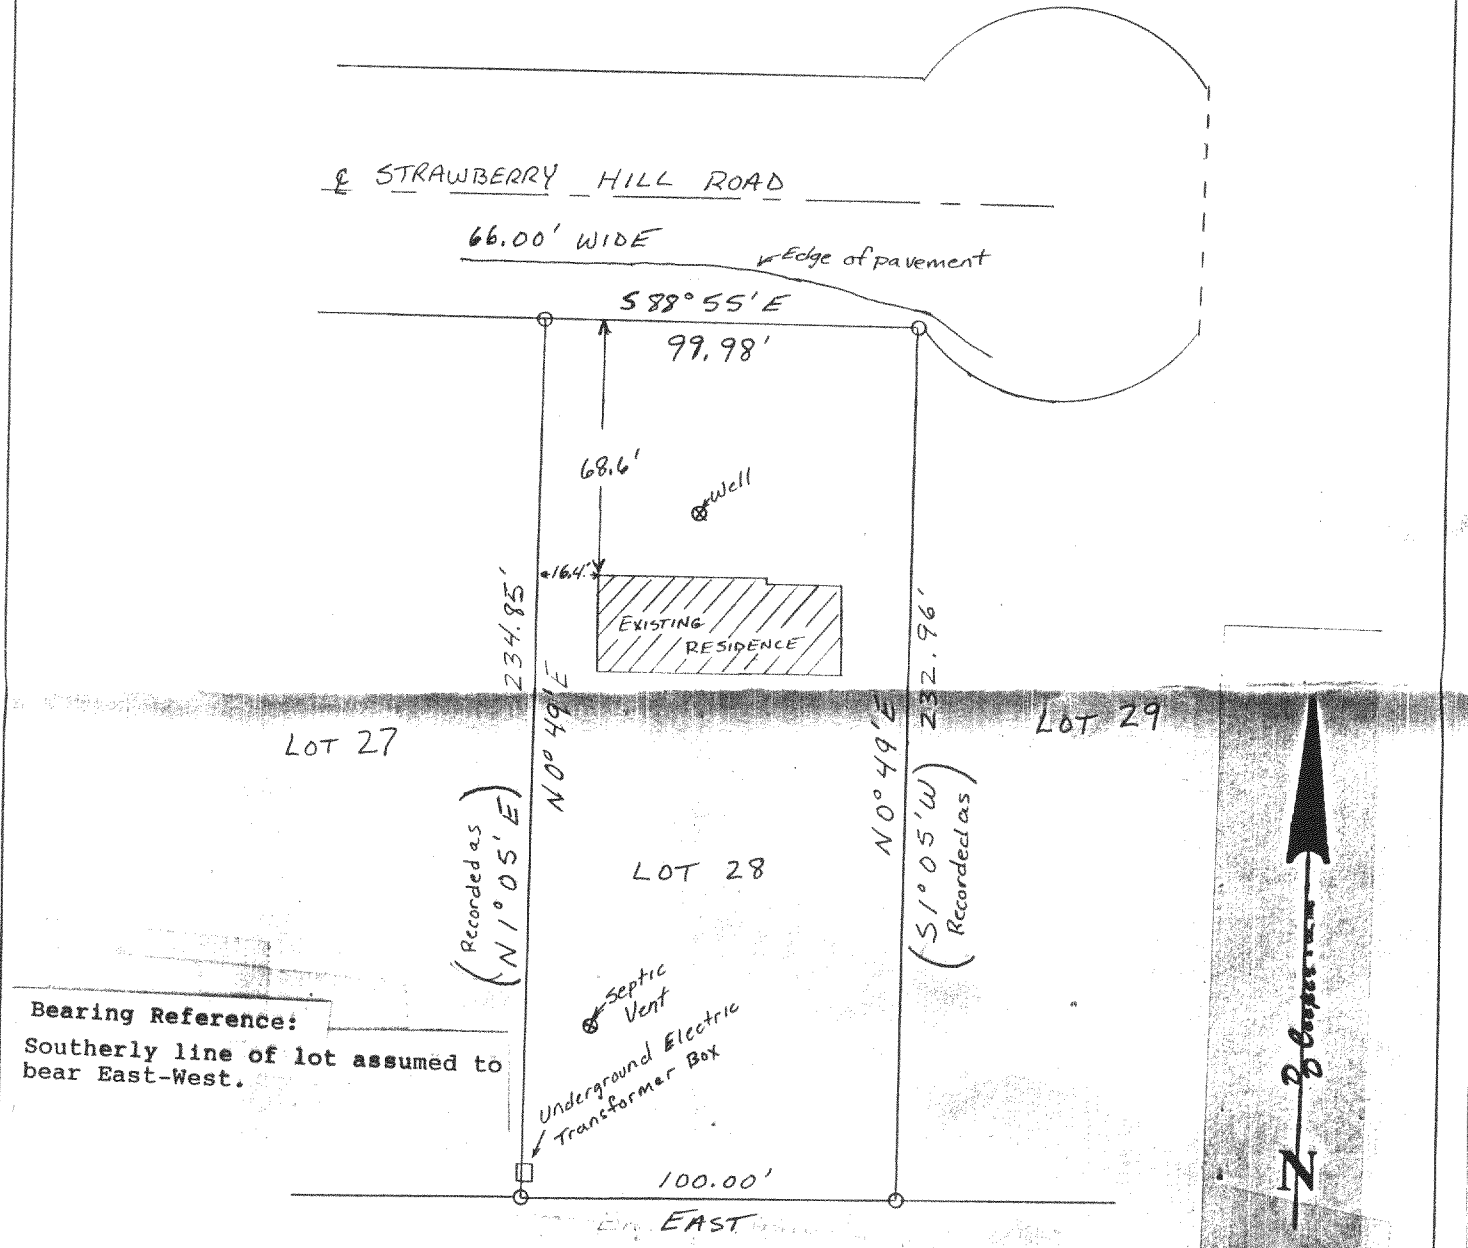

Legend:

- - found iron pipe
- ⊙ - set 3/4"x24" iron rod

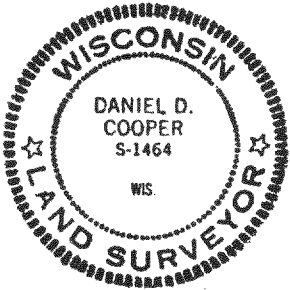


I hereby certify that I have surveyed the property described hereon and that the map shown hereon is a true and accurate representation thereof to the best of my professional knowledge and belief.

Dated this 3rd day of AUGUST, 1989

Daniel D. Cooper
Daniel D. Cooper, RLS No. S-1464

DRAWING NO. 3502

Reduced

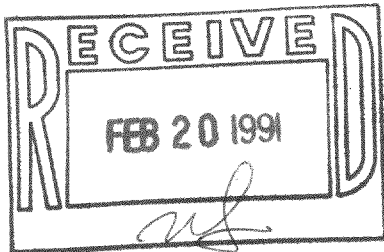

TAX KEY # GSPA 00028