


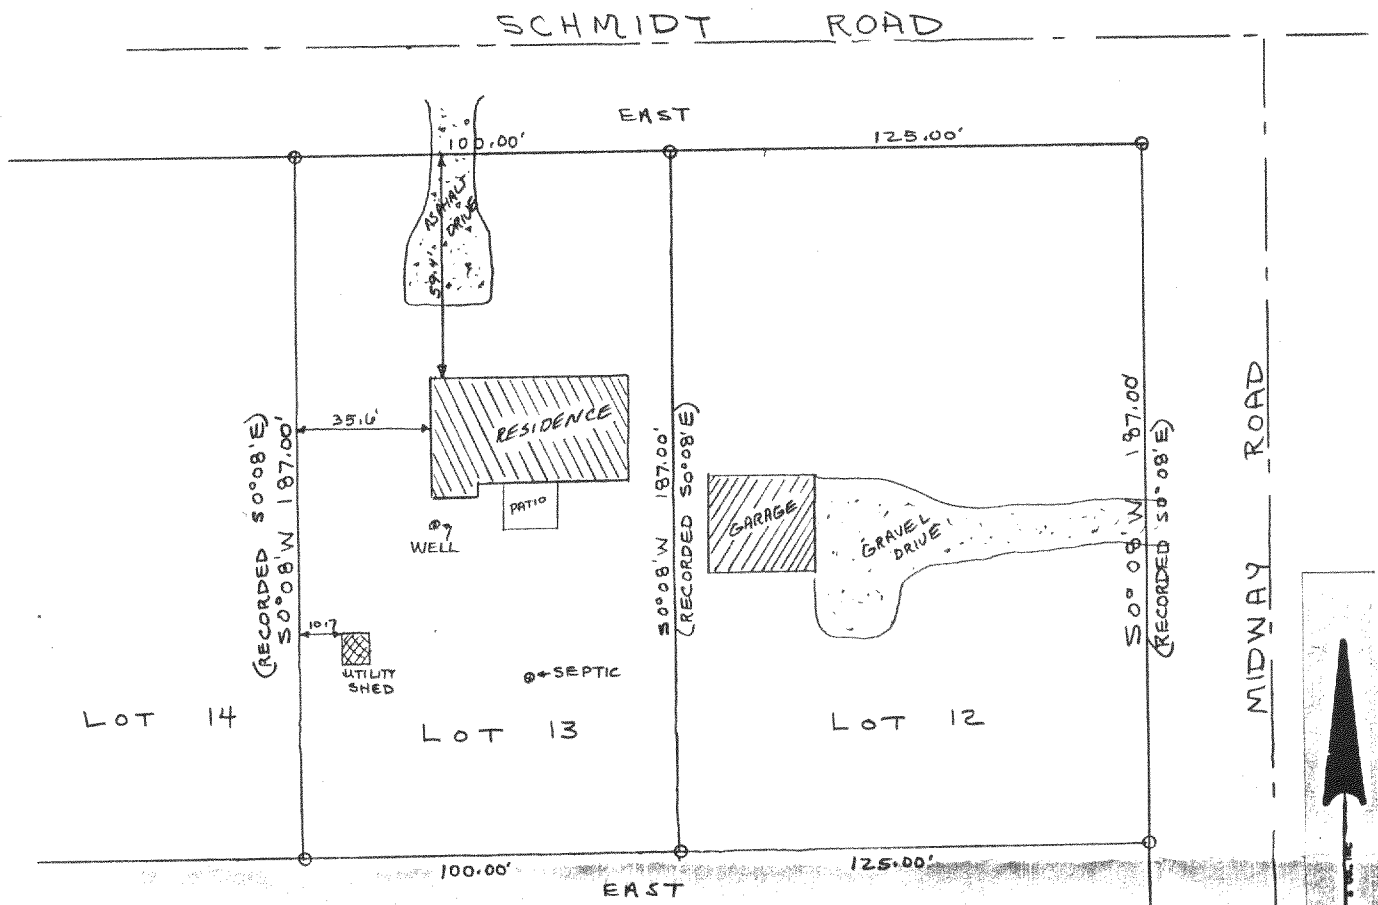

Plat of Survey of Lots 12 and 13 of
 Twin Heights Estates Subdivision,
 Located in Section 23, T3N, R16E,
 Walworth County, Wisconsin.


Survey ordered by Earl Zimmerman
 Rt 2 Elkhorn WI.

Bearing Reference: Northerly line of
 Lot assumed to bear
 East-West

Legend

- Indicates Iron pipe found
- Indicates 1"x24" iron rod set

Scale 1"=40'

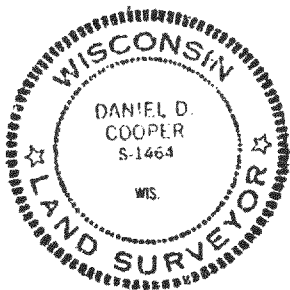


I hereby certify that I have surveyed the
 property described hereon and that the
 map shown hereon is a true and accurate
 representation thereof to the best of my
 professional knowledge and belief.

Dated this 28 day of Sept., 1989

Daniel D. Cooper
 Daniel D. Cooper, RLS No. S-1464

DRAWING NO. 3514

Reduced

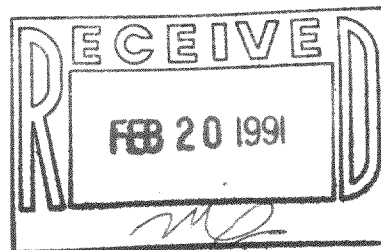

TAX KEY # GTHS 00006 (Lot 12)
 GTHS 00007 (Lot 13)

316-477