

PLAT OF SURVEY OF LOT 20, SYLVAN TRACE SUBDIVISION,
LOCATED IN SECTION 2, T3N, R16E, WALWORTH COUNTY,
WISCONSIN.

Bearing Reference: Westerly
line of Lot assumed to
bear N00°07'10"W as recorded

HILLVIEW
ROAD 66.00' WIDE

S00°07'10"E
(REC. 157.15') 157.10'

LOT 19
RECORDED
(N 89°52'50" E) 1189°52'E
(REC. 156.51') 157.32'

LOT 20

LOT 21

258.13'
N00°19'20"E

RECORDED
(S 05°32'00" E)
(REC. 100.30')
S 0°20' E 100.26'


S 89°23' E 144.38'
(REC. 145.00')
(S 89°40'40" E)
RECORDED

PIN OAK ROAD
66.00' WIDE

Legend:

- o - found iron pipe
- ⊙ - set 3/4"x24" iron rod

Scale 1"=40'

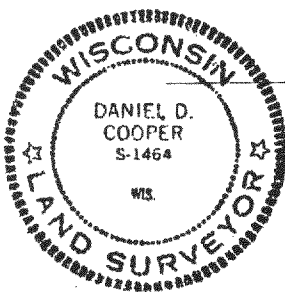


I hereby certify that I have surveyed the
property described hereon and that the
map shown hereon is a true and accurate
representation thereof to the best of my
professional knowledge and belief.

Dated this 13th day of October, 1989

Daniel D. Cooper
Daniel D. Cooper, RLS No. S-1464

DRAWING NO. 3535-19-52

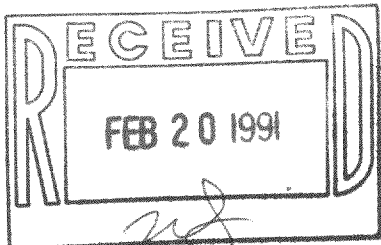

Reduced

Tax Key # GST 00020