


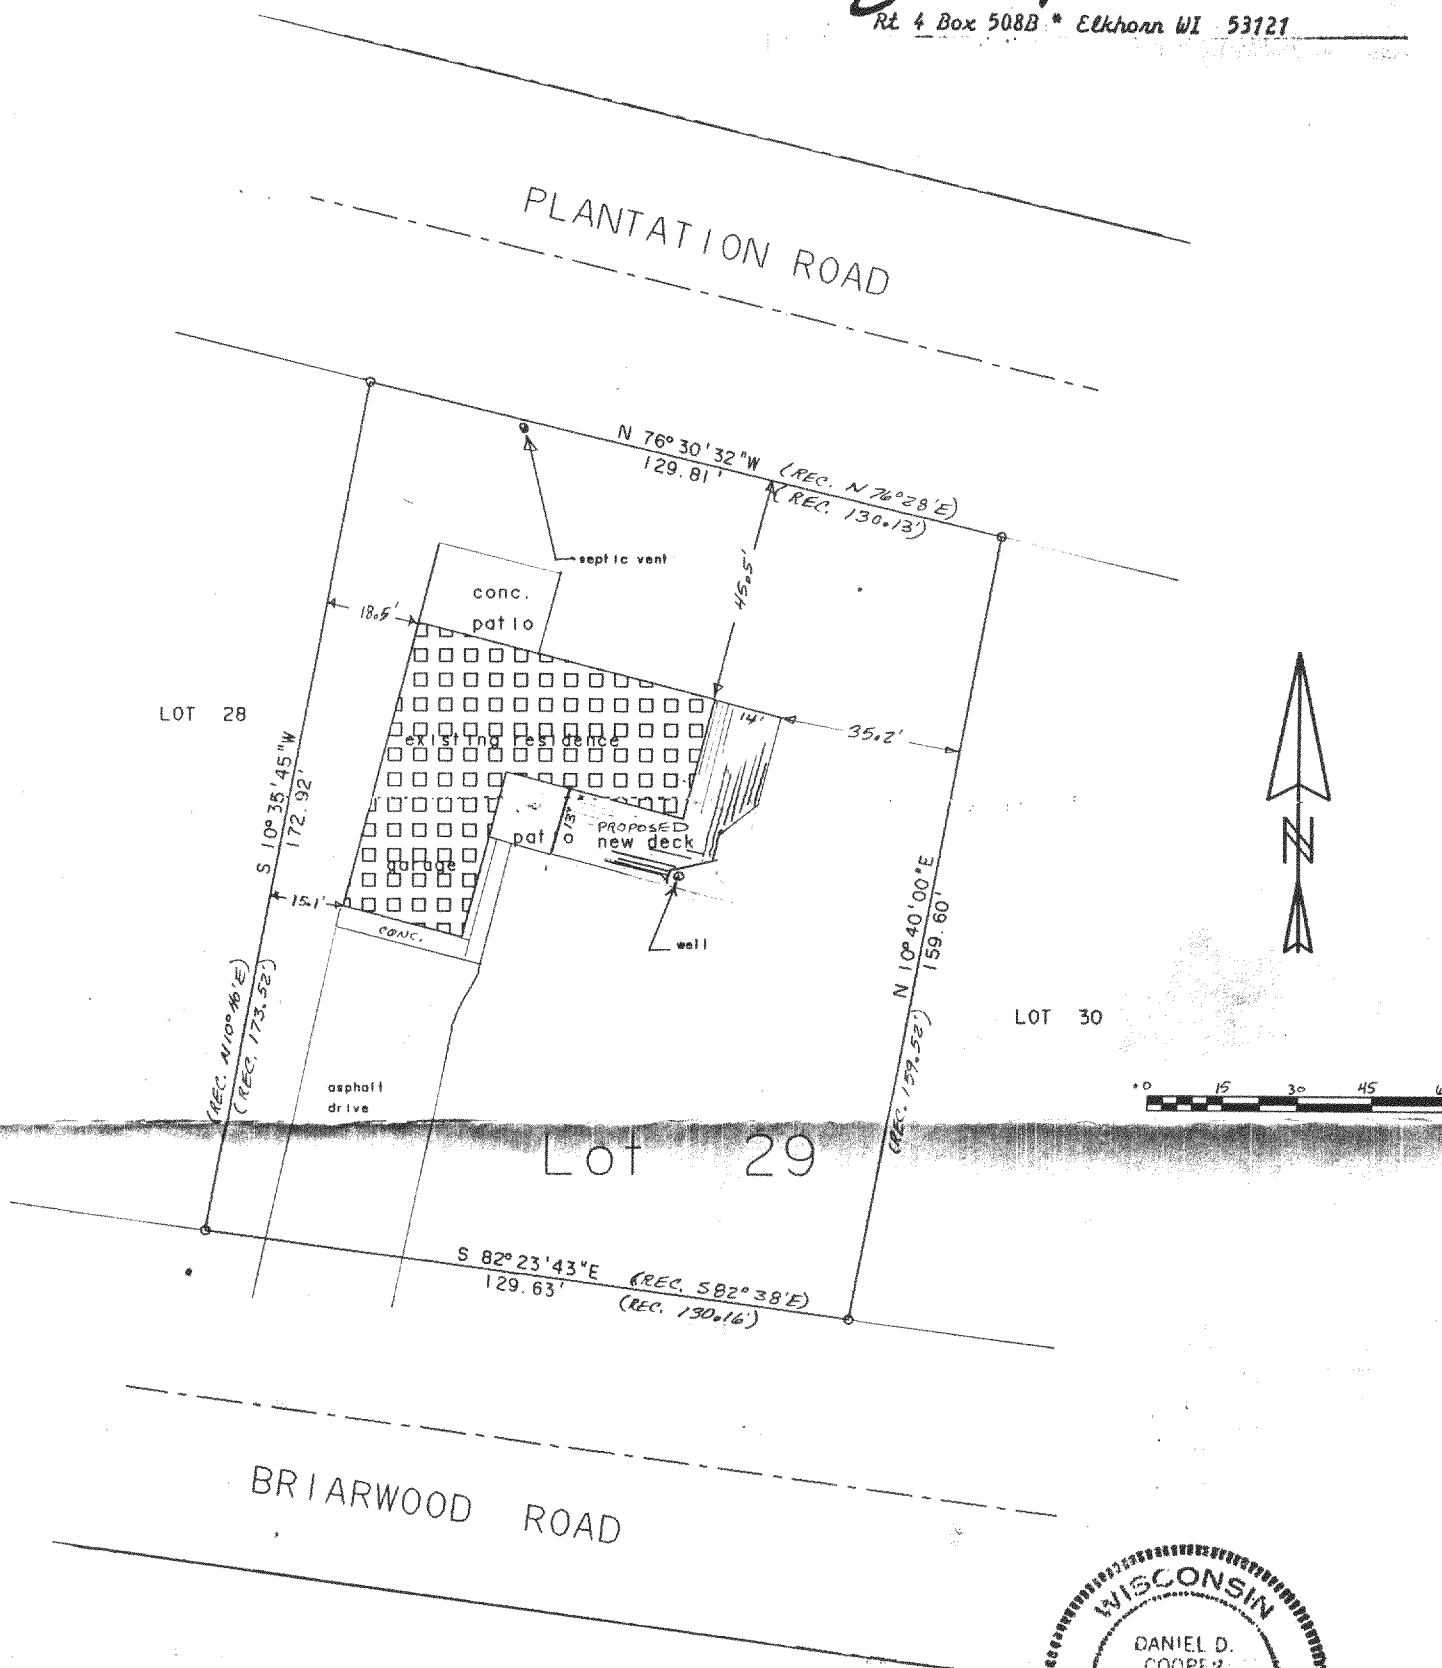


Plat of Survey of Lot 29 of Baywood 1st Addition, being a subdivision located in the Town of Sugar Creek, Walworth County Wisconsin.

- indicates iron pipe found
- indicates iron rod set

Scale 1"=30'

Survey ordered by LaVerne Kamenick-builder
 Elkhorn Wisconsin

Bearing Reference: Easterly line of Lot assumed
 to bear N10°40'00"E

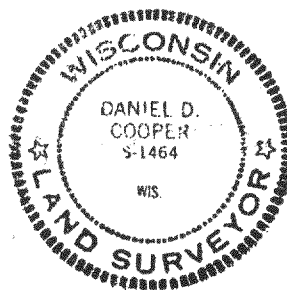


I hereby certify that I have surveyed the property described hereon and that the map shown hereon is a true and accurate representation thereof to the best of my professional knowledge and belief.

Dated this 24 day of April, 1990

Daniel D. Cooper
 Daniel D. Cooper, RLS No. S-1464

Reduced

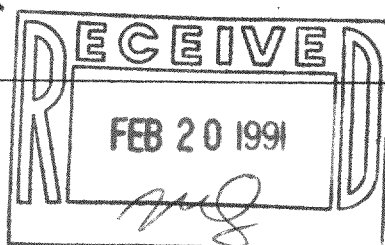

DRAWING NO. 3624-20-87

TAX KEY # GBEA 00006

316-479