


PLAT OF SURVEY OF LOT 24, SYLVAN TRACE
SUBDIVISION, BEING LOCATED IN SECTION 2,
T3N, R16E, WALWORTH COUNTY, WISCONSIN.

PIN OAK ROAD
66.00' WIDE

Survey ordered by Modern Realty-Elkhorn

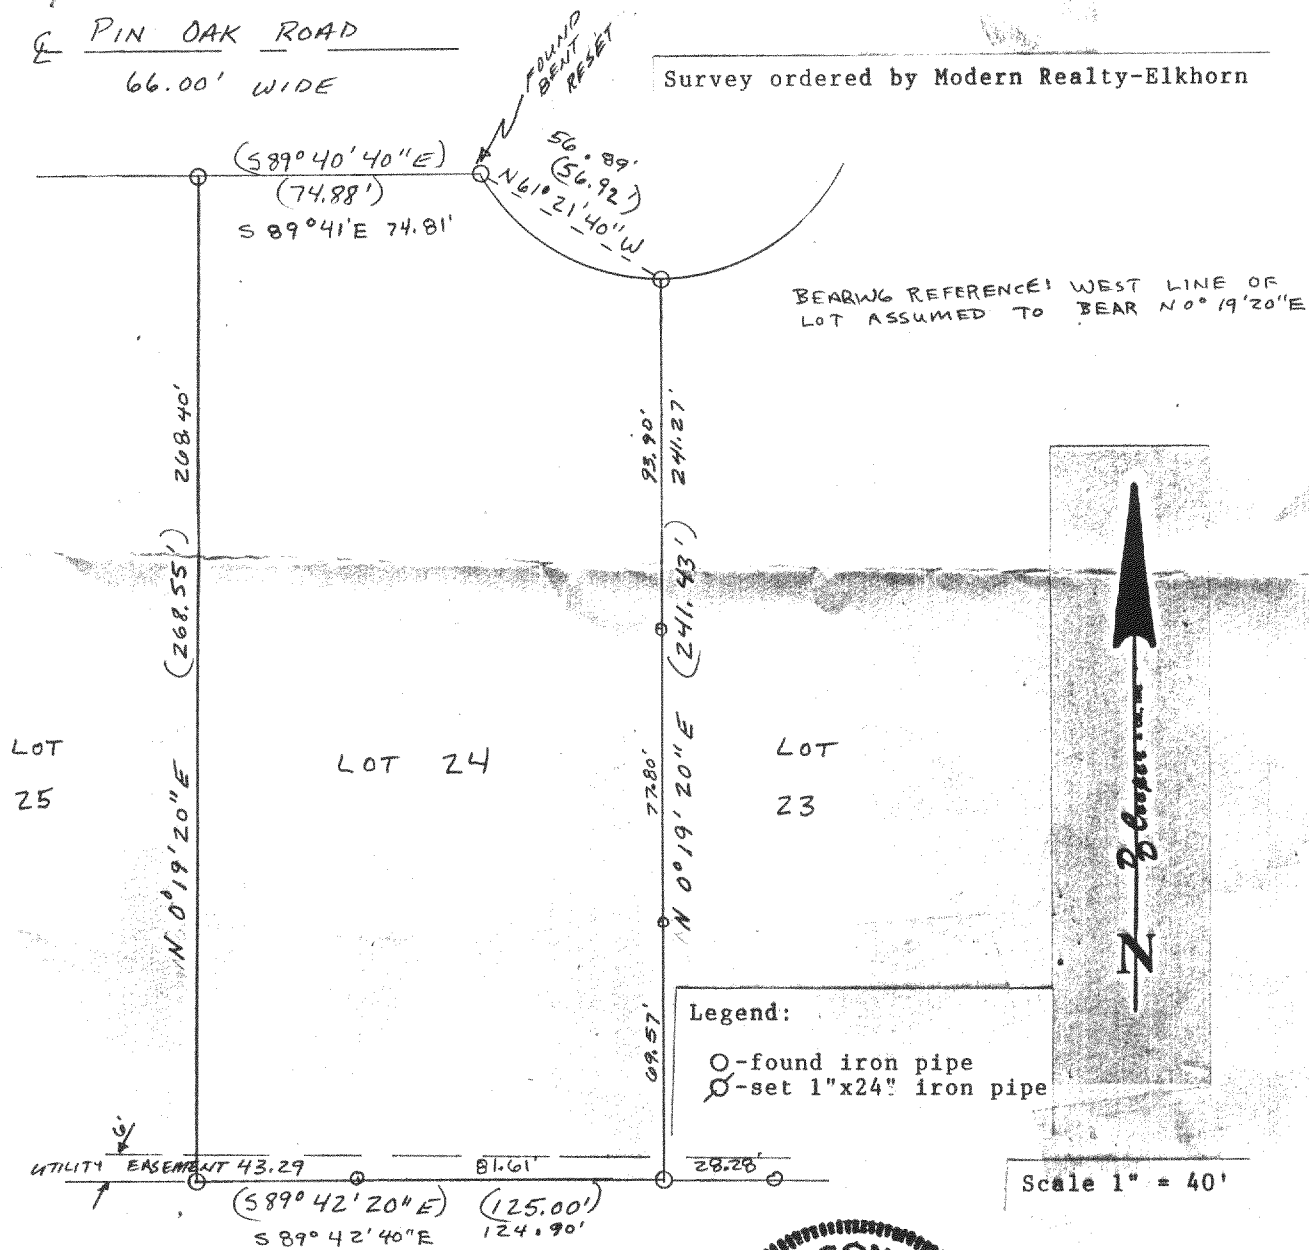

I hereby certify that I have surveyed the property described hereon and that the map shown hereon is a true and accurate representation thereof to the best of my professional knowledge and belief.


Dated this 12th day of JUNE, 1990

Daniel D. Cooper

Daniel D. Cooper, RLS No. S-1464



DRAWING NO. 3642

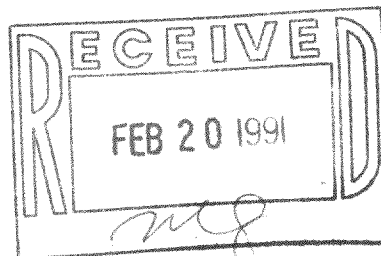

Reduced

TAX KEY # GST 00024