


Wisconsin Registered Land Surveyor S-1594



Rt. 3, Box 273
Elkhorn, Wisconsin 53121
Phone: (414) 723-4260 (office)
(414) 723-4813 (residence)

LOTS 12 AND 13 OF BLOCK 65 OF THE FIFTH MAP OF
INTERLAKEN. A SUBDIVISION LOCATED IN THE
NORTHWEST 1/4 OF SECTION 14, T.3 N., R 16 E.,
WALWORTH COUNTY, WISCONSIN

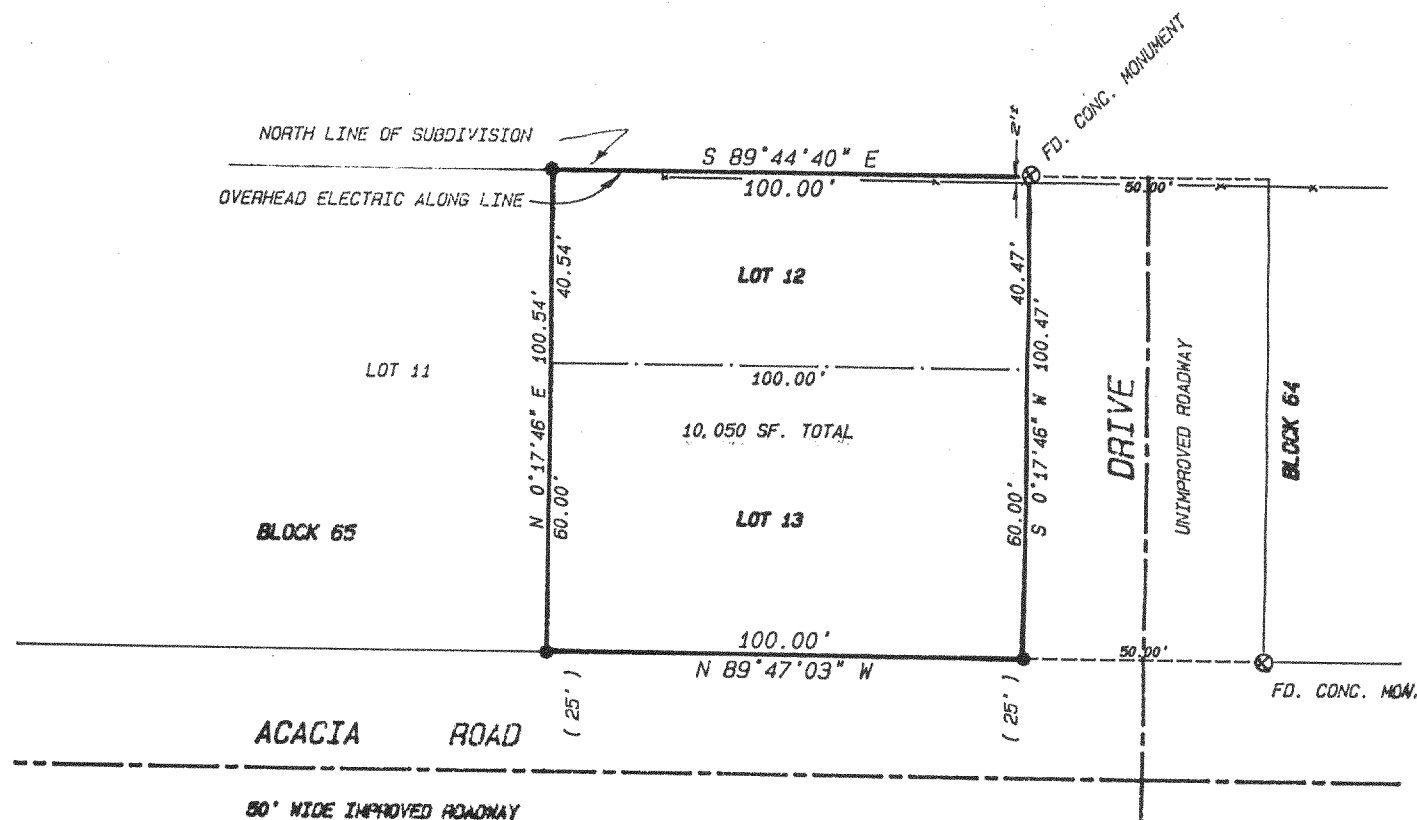

ORDERED BY: TLC REALTY
AT. 5 BOX 5
ELKHORN, WIS. 53121

- FOUND IRON PIPE
FOUND IRON ROD
FOUND BRASS CAPPED MONUMENT
FOUND CONCRETE MONUMENT
CHISEL CUT IN CONCRETE
SET IRON ROD, 24" LONG, WEIGHING
1.5 LBS./LINEAL FT., 3/4" DIA.
SET IRON ROD, 30" LONG, WEIGHING
4.5 LBS./LINEAL FT., 1-11/16" DIA.
RECORDED AS DIMENSION
EXISTING FENCE

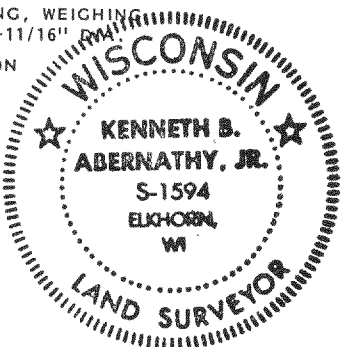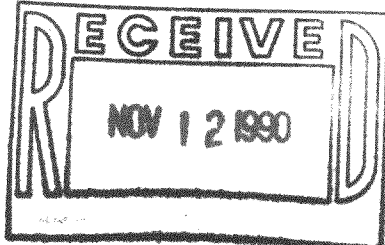

LOCUST

50' WIDE

SCALE: 1" = 30 FEET

"I hereby certify that I have surveyed the above described property and that the above map is a true representation thereof and shows the size and location of the property, its exterior boundaries, the location of all visible structures and dimensions of all principal buildings thereon, boundary fences, apparent easements, roadways and visible encroachments, if any."

"This survey is made for the use of the present owners of the property, and also those who purchase, mortgage, or guarantee the title thereto within one year from date hereof."

Kenneth B. Abernathy, Jr.
KENNETH B. ABERNATHY, JR.
WISCONSIN REGISTERED LAND SURVEYOR,
S-1594

Date: MAY 7, 1990 Job No. 199a503

316-487

TAX KEY# GI 00596