


GEORGE T. DUNHAM
SURVEYING & SUBDIVIDING
DELAVAN, WISCONSIN

N



Scale - 1" = 20'
● = Iron Pipe

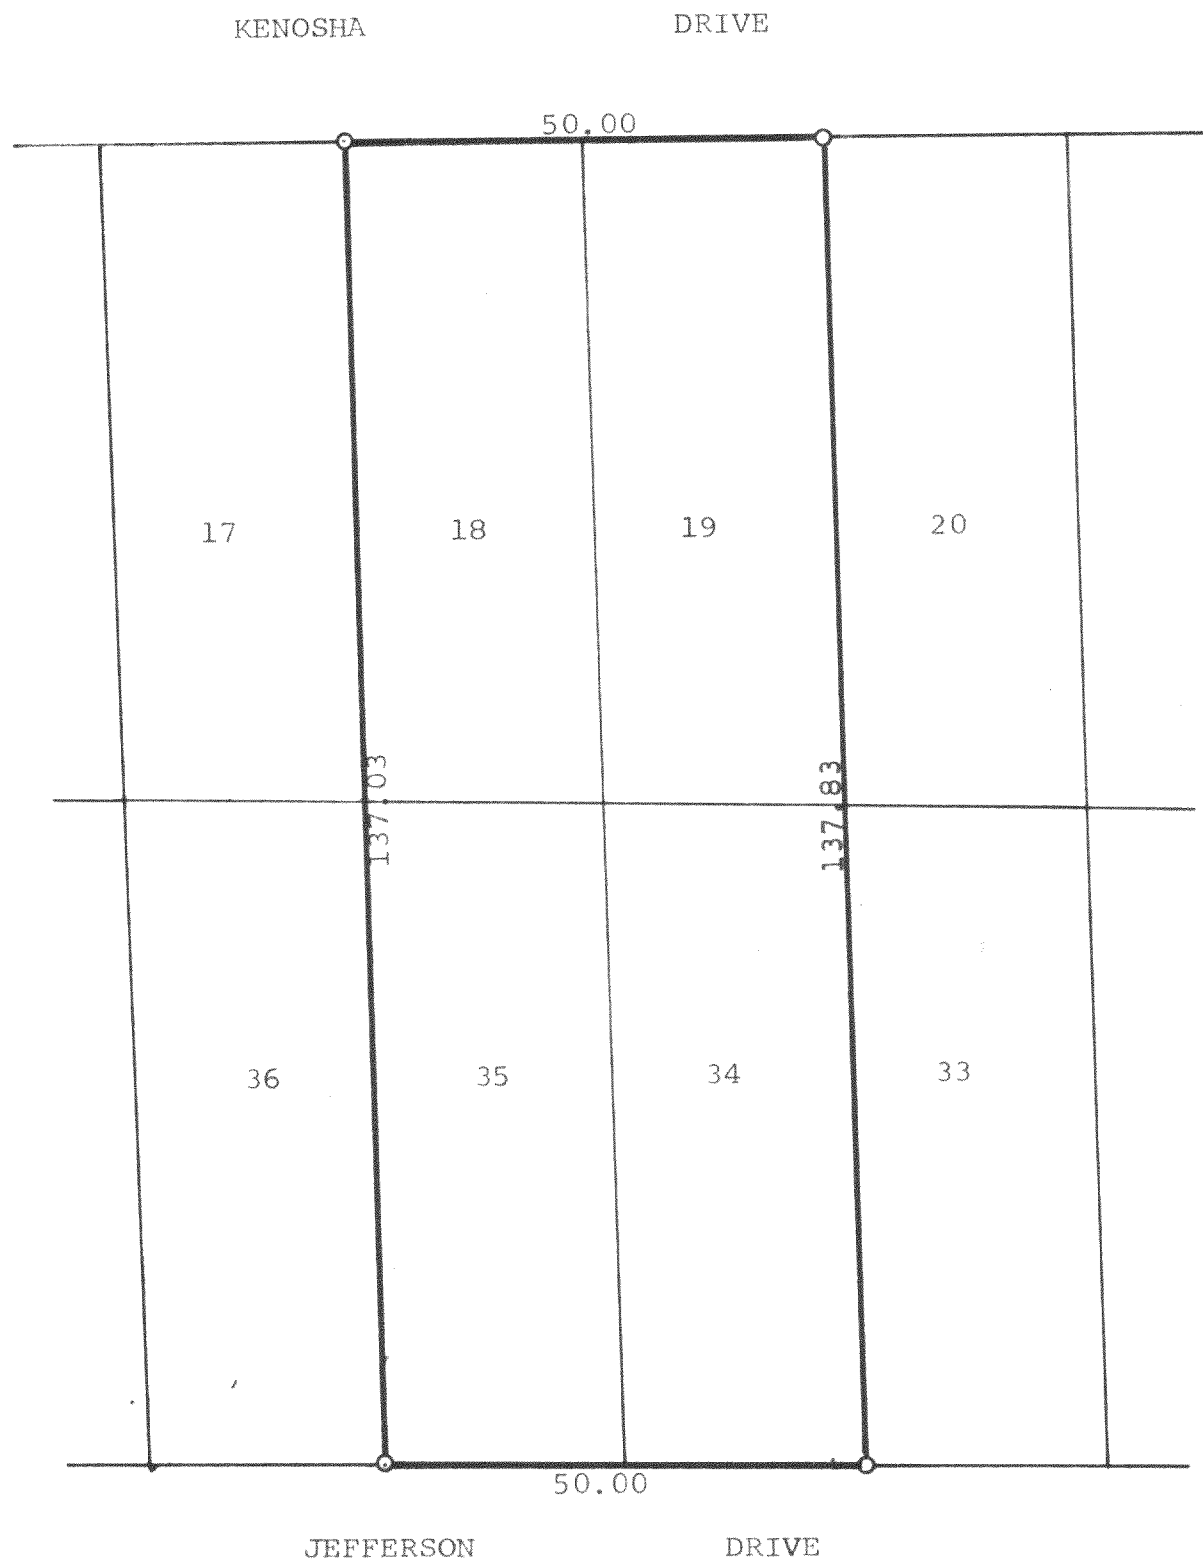

Plat of survey of Lots 18, 19, 34, and 35 in Block 51 of
Lake Wandawega Subdivision located in the Southeast $\frac{1}{4}$ of
Section 2, T 3 N, R 16 E, Walworth County, Wisconsin.
September 12, 1969

GLW-63,68

George T. Dunham
George T. Dunham, Surveyor

316-49