


**ABELL
SURVEYING & MAPPING
DELAN, WISCONSIN 53115
414-728-6737**



PLAT OF SURVEY OF

644528 THIS DEED, made between JOHN D. DEE, and PEGGY LYNN WRIGHT, a single woman Witnesseth, That the said Grantor for a valuable consideration conveys to Grantee the following described real estate in Walworth County, State of Wisconsin: (a) Lots 20, 21, 22, 27, 28, 29 and 30, Block 49, of Lake Waukegan Subdivision, Town 3 North, Range 16 East, Walworth County, Wisconsin. (b) Commencing at the West 1/4 section corner of Section 1, Town 3 North, Range 16 East of Walworth County, Wisconsin, thence East on the East-West 1/4 section line of said section 42.2 feet; thence South 0° 25' East 77 feet to the place of beginning; thence North 86° 07' 45" West 50 feet; thence South 0° 35' East 140.6 feet; thence South 86° 07' 45" East 50 feet; thence North 0° 35' West 140.6 feet to the place of beginning.	WARRANTY DEED THIS SPACE RESERVED FOR RECORDING DATA RECORDED IN 61 PAGE 317 71 DEC 17 AM 11 11 W.C. REICHMAN REG. OF DEEDS WALWORTH COUNTY, WIS. RETURN TO: J. D. DEE, JR. 222 E. Main St. Elkhorn, Wis. For Key Map, see page 318
--	--

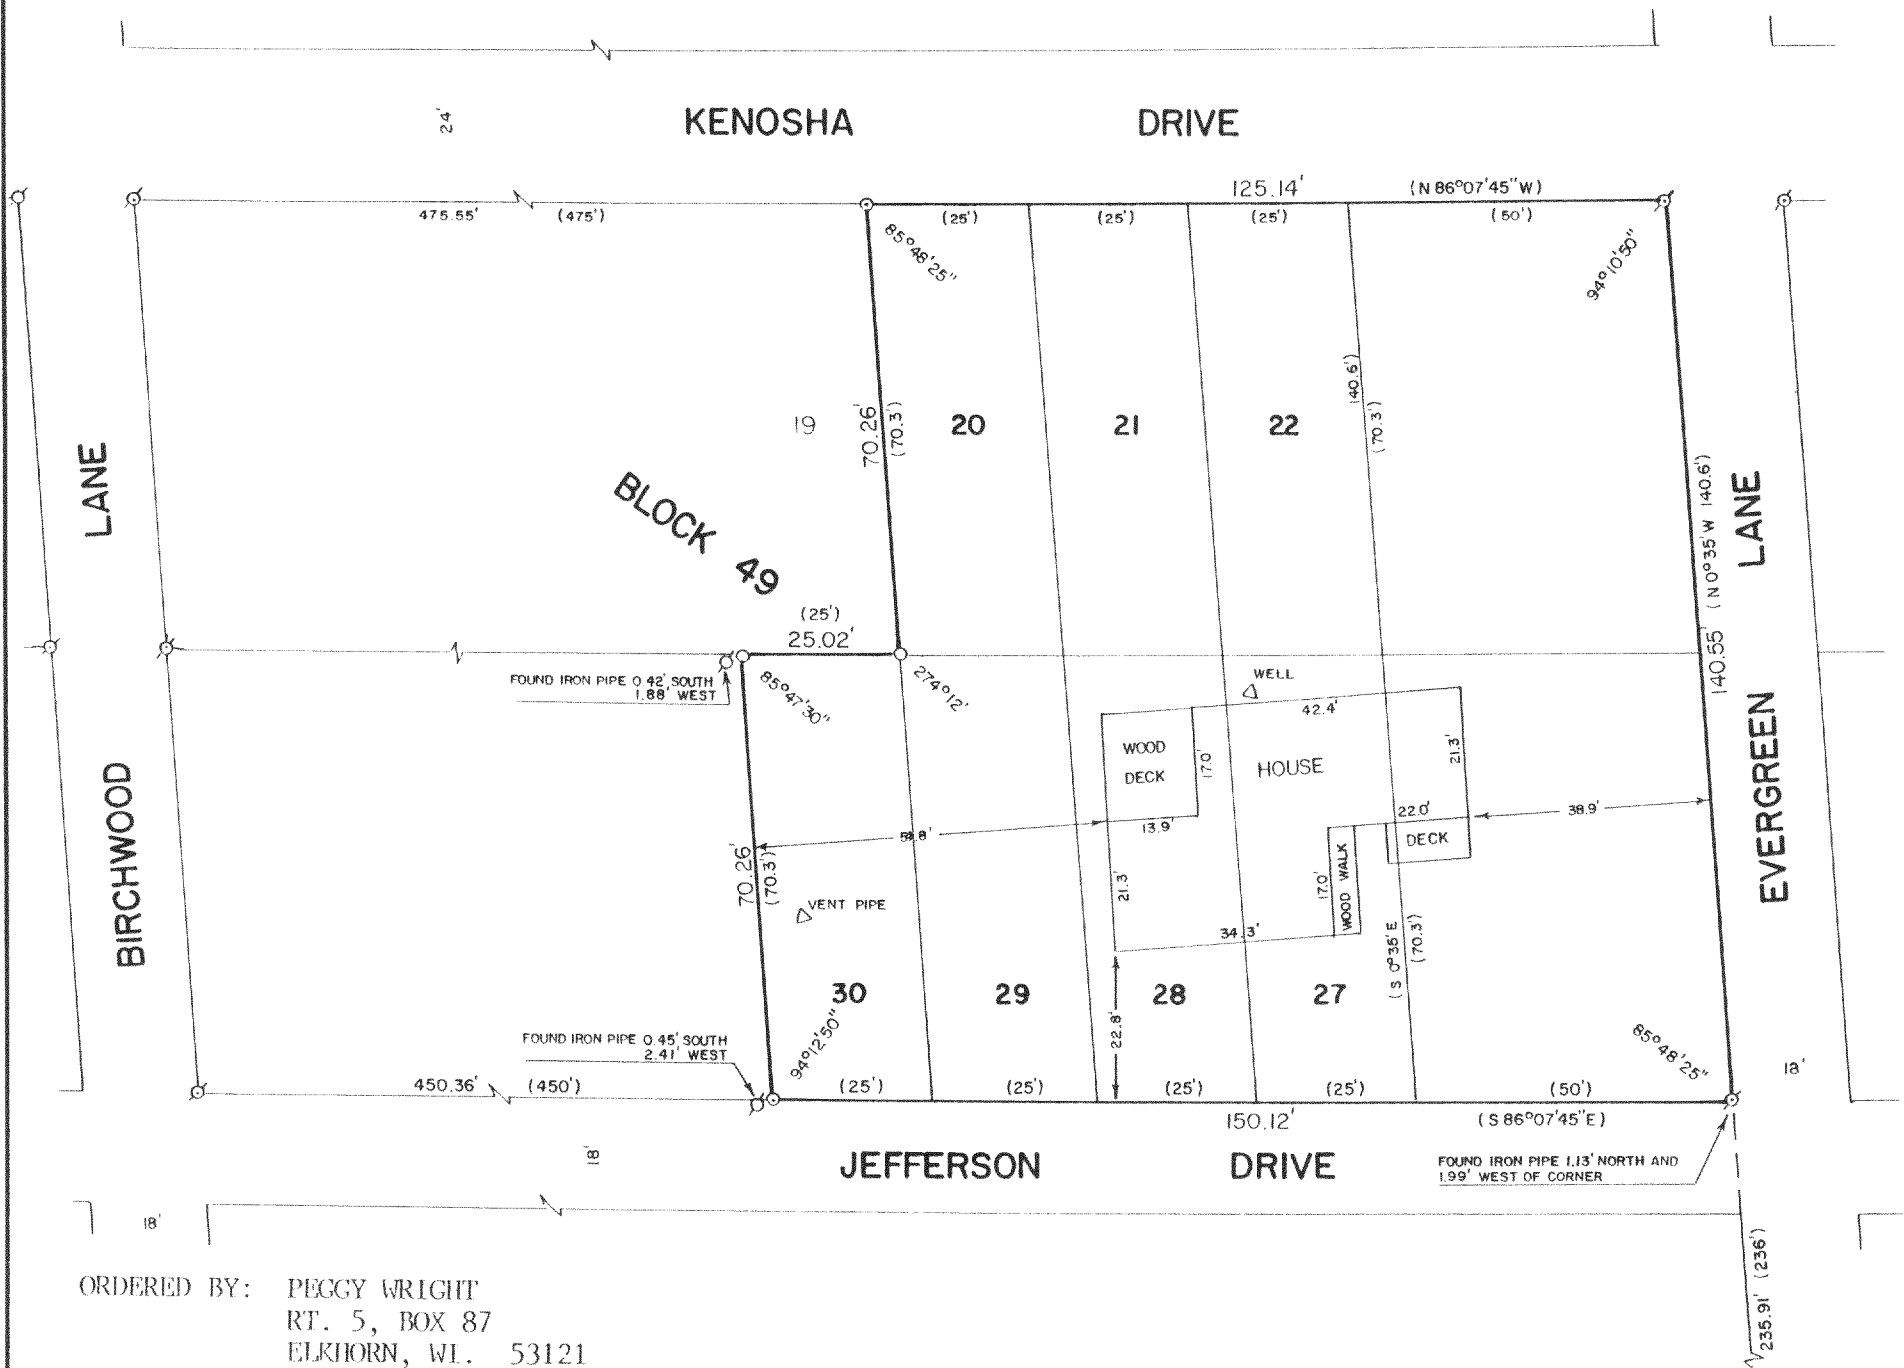

SCALE - 1"=30'

LEGEND
 ∅ - IRON PIPE FOUND
 ○ - IRON ROD SET
 () - RECORDED AS


I, DAVID F. ABELL, DO HEREBY CERTIFY THAT I HAVE SURVEYED THE PROPERTY HEREON DESCRIBED ACCORDING TO THE OFFICIAL RECORDS AND THAT THE PLAT HEREON IS A CORRECT REPRESENTATION OF THE PROPERTY LINES TO THE BEST OF MY KNOWLEDGE AND BELIEF.

David F. Abell

DAVID F. ABELL
WISCONSIN REGISTERED LAND SURVEYOR, S-1596

November 9, 1990

DATE: November 9, 1990 JOB NUMBER - 90202
NOTE: THIS IS NOT A CERTIFIED COPY UNLESS SEALED.

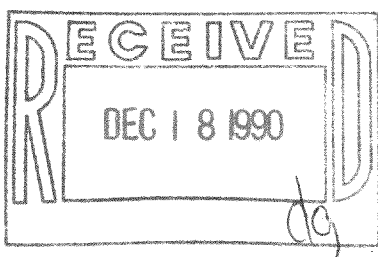

316-497

G.W. 86044