


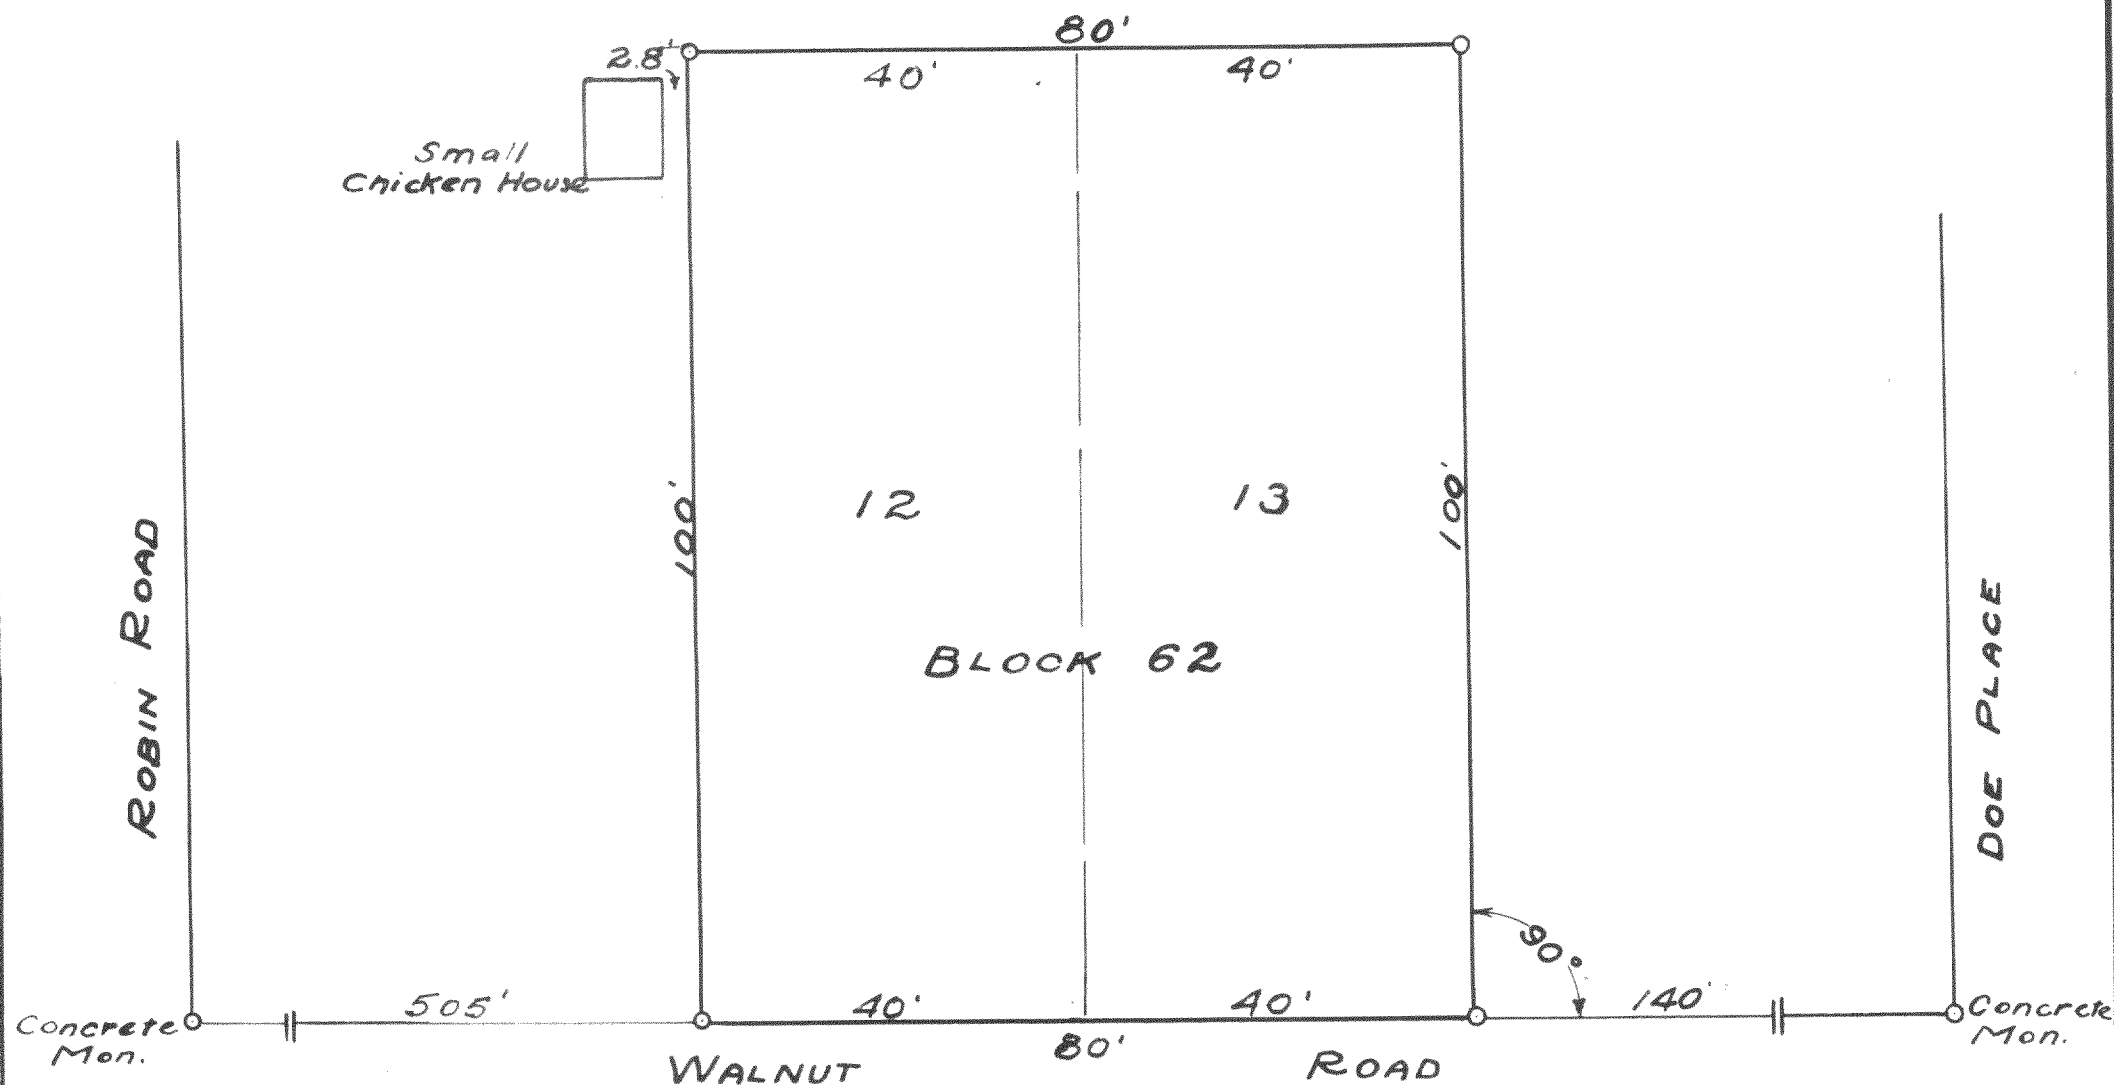

Plat of a survey of Lots 12 and 13
 of Block 62 of INTERLAKEN SUB.,
 Walworth County, Wisconsin
 Scale 1"=20' Surveyed by Lloyd S. Jensen
 Feb. 6, 1935 County Surveyor
 0-Iron pipe Drawn by W.F.M.

