

From: Jerry Kropp
Century 21 Walton Realty





Survey for: GREAT AMERICAN FUNDING CORP.
Buyer: DAVID YARDLEY and PAM YARDLEY, his wife

PLAT OF SURVEY

-of-

Lots 88, 89 and 90 in Block A of North Lake Beach Tract 3, Town of Sugar Creek, according to the recorded plat thereof.

NORTH LAKE

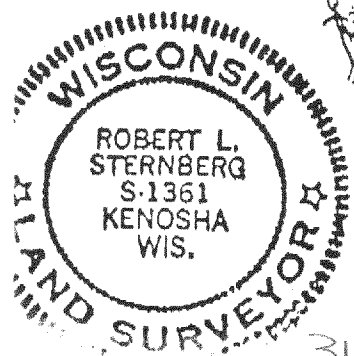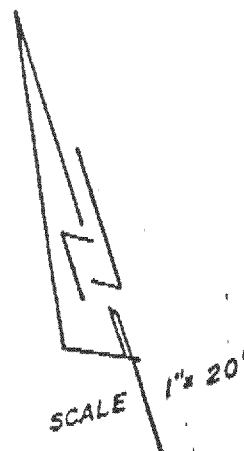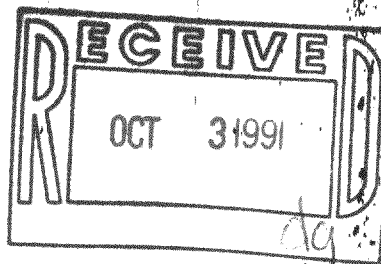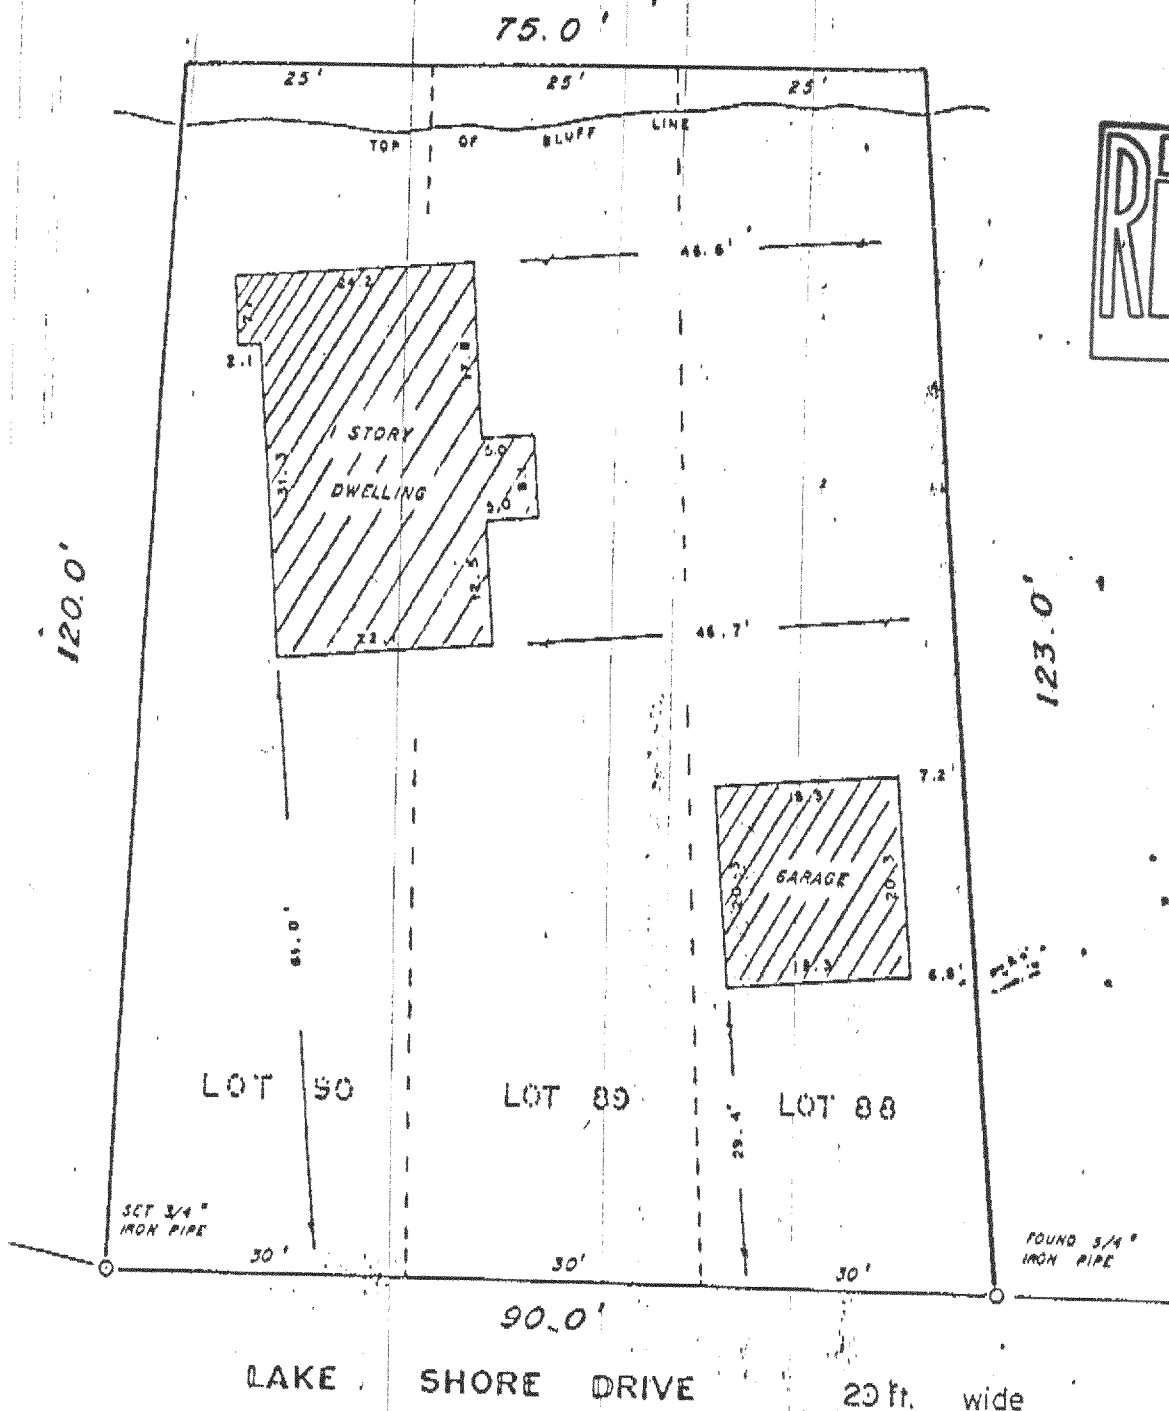

I Certify that I have surveyed the described property and the above map is a true representation thereof and shows the size and location of the property, its exterior boundaries, the location and dimensions of all visible structures thereon, fences, apparent easements and roadways and visible encroachments, if any.

This survey is made for the exclusive use of present owners of property, and also those who purchase, mortgage or guaranty the title thereto within one (1) year from date hereof.

Robert L. Sternberg
Registered Land Surveyor

April 24, 1979
Date

79015
Job No.

316-505

GNLB3 00327