



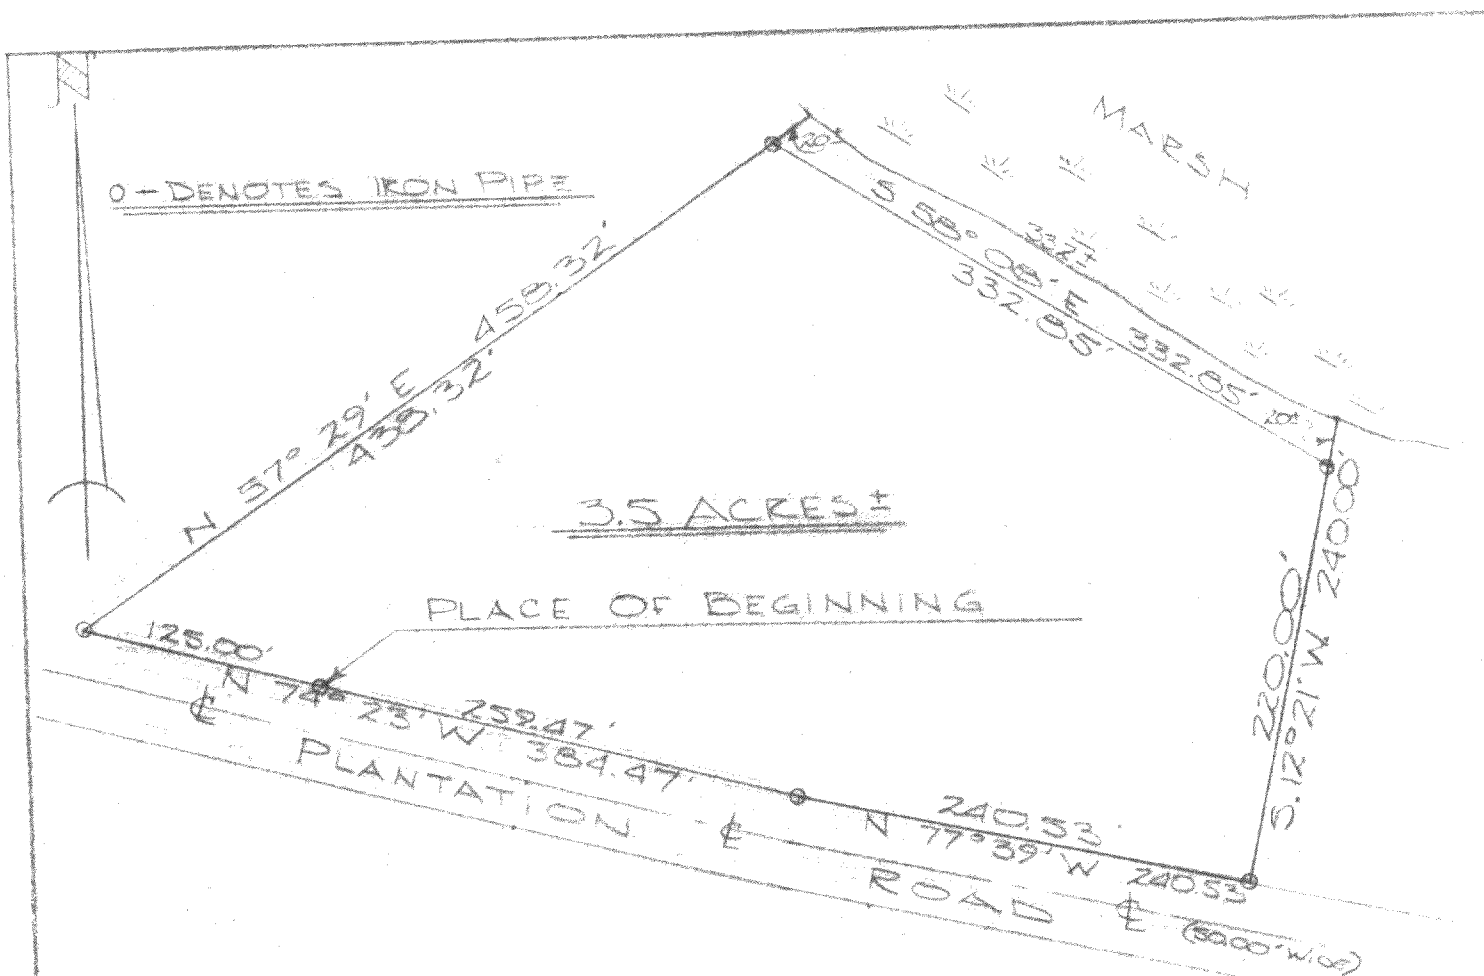

DESCRIPTION: Commencing at the NW corner of Section 2, T. 3 N., R. 16 E. Walworth County, Wisconsin; thence N. 89° 04' E. along the North line of said Section 2, 1855.58 feet, thence S. 01° 09' 10" E. 478.89 feet, thence S. 74° 23' 10" E. 285.79 feet, thence N. 14° 34' E. 50.01 feet to the place of beginning of the lands hereinafter described, to wit: thence N. 74° 23' W. 125.00 feet, thence N. 57° 29' E. 438.32 feet to an iron pipe, thence continue N. 57° 29' E. 20 feet more or less to the edge of a marsh, thence Southeasterly along the edge of the marsh 332 feet more or less to a point, thence S. 12° 21' W. 20 feet more or less to an iron pipe, said iron pipe being 332.85 feet S. 58° 08' E. of the aforementioned iron pipe, thence continue S. 12° 21' W. 220.00 feet to an iron pipe, thence N. 77° 39' W. 240.53 feet, thence N. 74° 23' W. 259.47 feet to the place of beginning, containing 3.5 acres of land more or less.

CERTIFICATE: I, James F. Blagi, surveyor, do hereby certify that I have surveyed the property hereon described.

November 9, 1970.

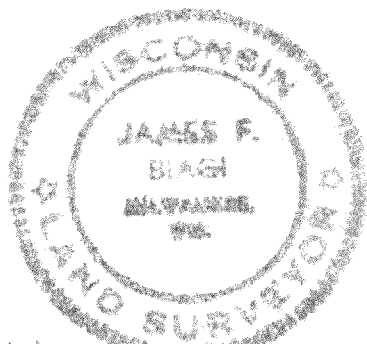

James F. Blagi
James F. Blagi, R.L.S. 272

Cert. Survey No. 355

316-52