


28

DESCRIPTION: The southwest one quarter of the southwest one quarter of Section 28, Town 3, north, Range 16 east of the Principal Meridian, the East one half of the southeast one quarter of Section 29, Town 3, north, Range 16 east of the 4th Principal Meridian.

CERTIFICATE: I, Joseph M. Biagi, hereby certify that I, have on this the 24th day of November 1953, surveyed the above described property and that the above plat is a true and accurate portrayal of said survey.

SIGNED AND SEALED ON THIS THE 1ST DAY OF DECEMBER 1953.

Joseph M. Biagi
Joseph M. Biagi, Professional Engineer.
Elkhorn Wisconsin.

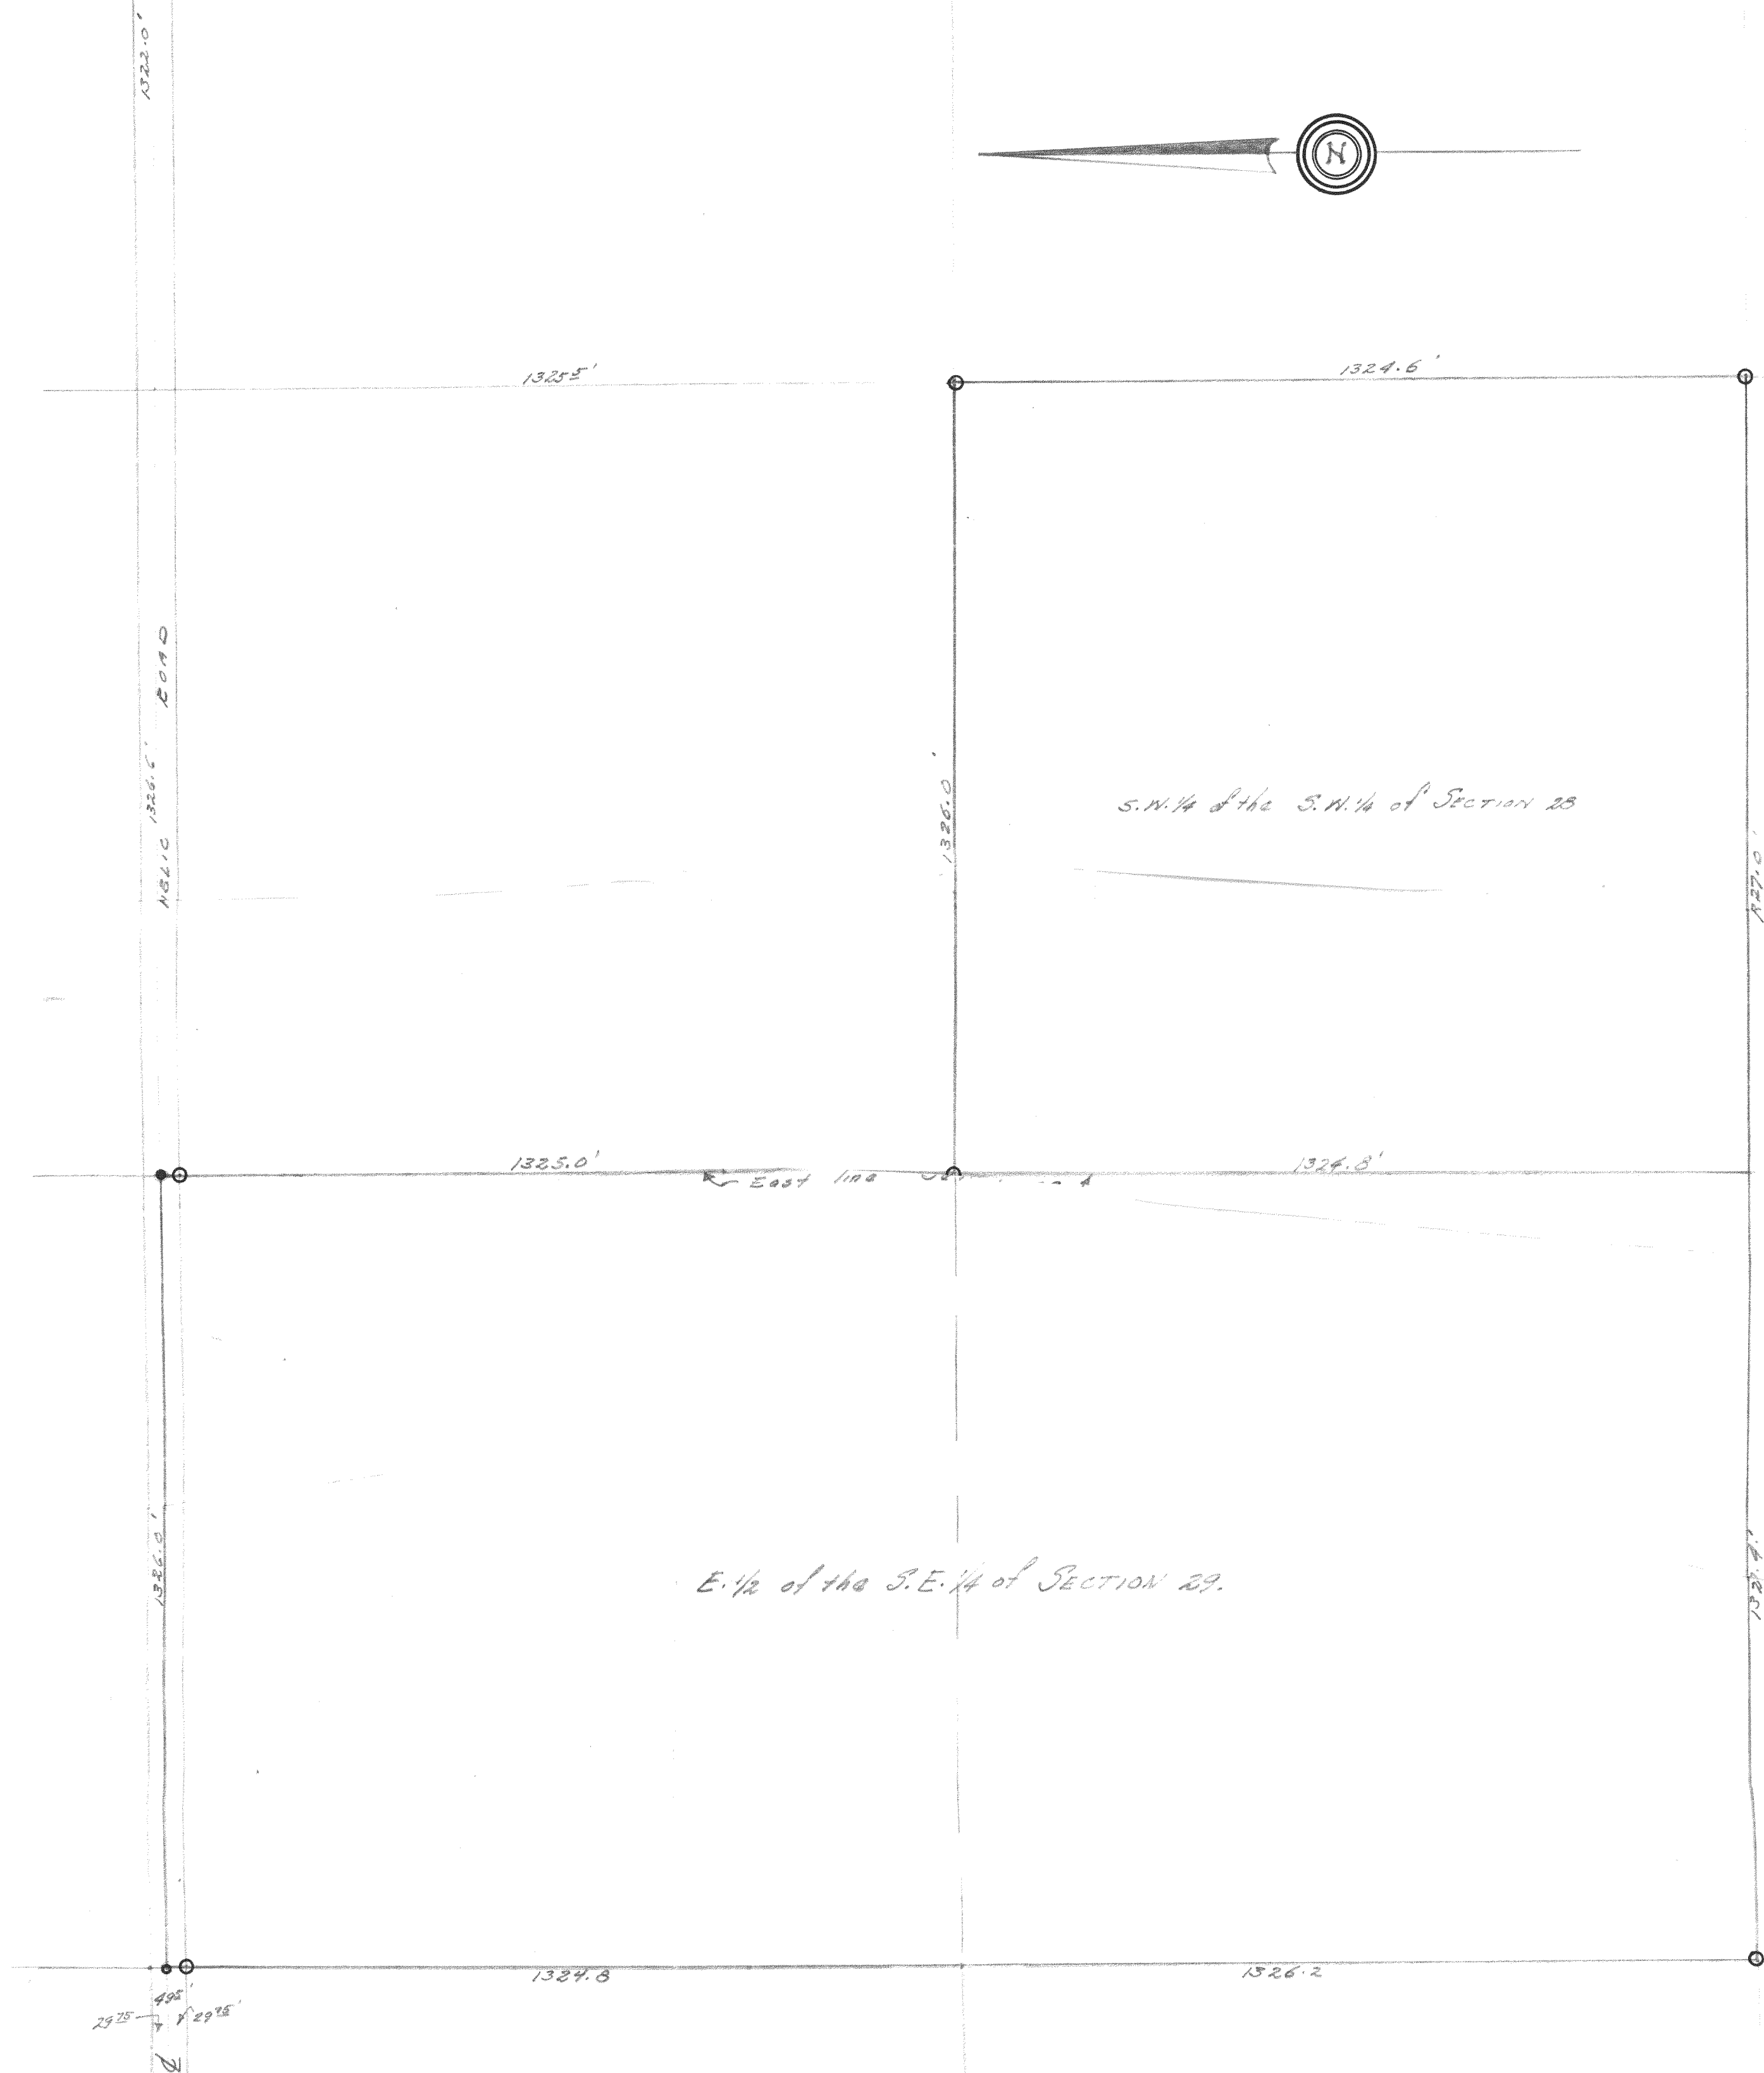

SC-28-14

SC-29-5