
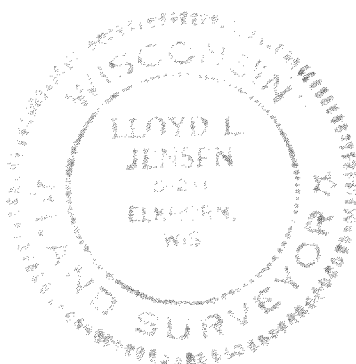


PLAT OF SURVEY

OF

LOTS 5, 6, 7, 8, IN BLOCK 89, LAKE WANDAWEGA
SUBDIVISION, LOCATED IN SECTION 2, T3N R16E,
WALWORTH COUNTY, WISCONSIN.

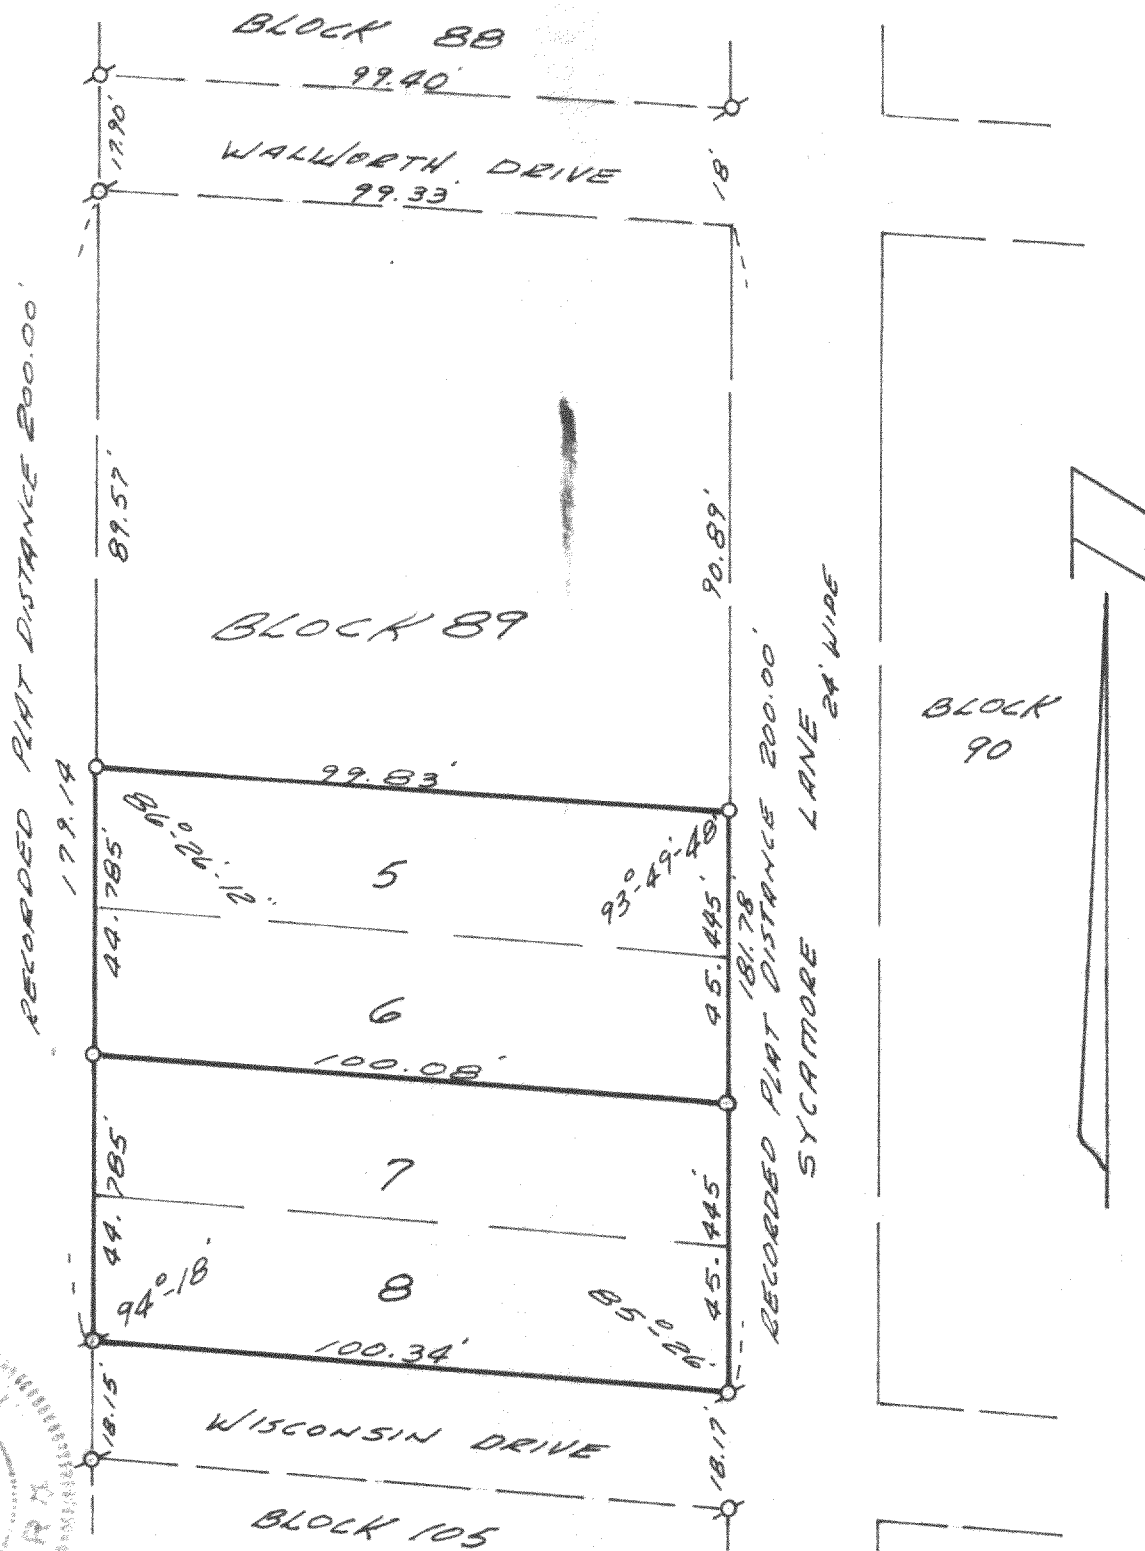

LEGEND

- — Iron Pipe SET
- — Concrete Monument

Scale 1" =

○ — IRON PIPE FOUND

WE CERTIFY: That we have surveyed the above described property and that the plat shown hereon is an accurate survey and a true representation thereof and correctly shows the exterior boundary lines and all divisions of said property.

Date SEPT 1972

Lloyd L. Jensen
LLOYD L. JENSEN,

Wisconsin Registered Land Surveyor, No. S-211

6LW-148

316-54.1