


PLAT OF SURVEY

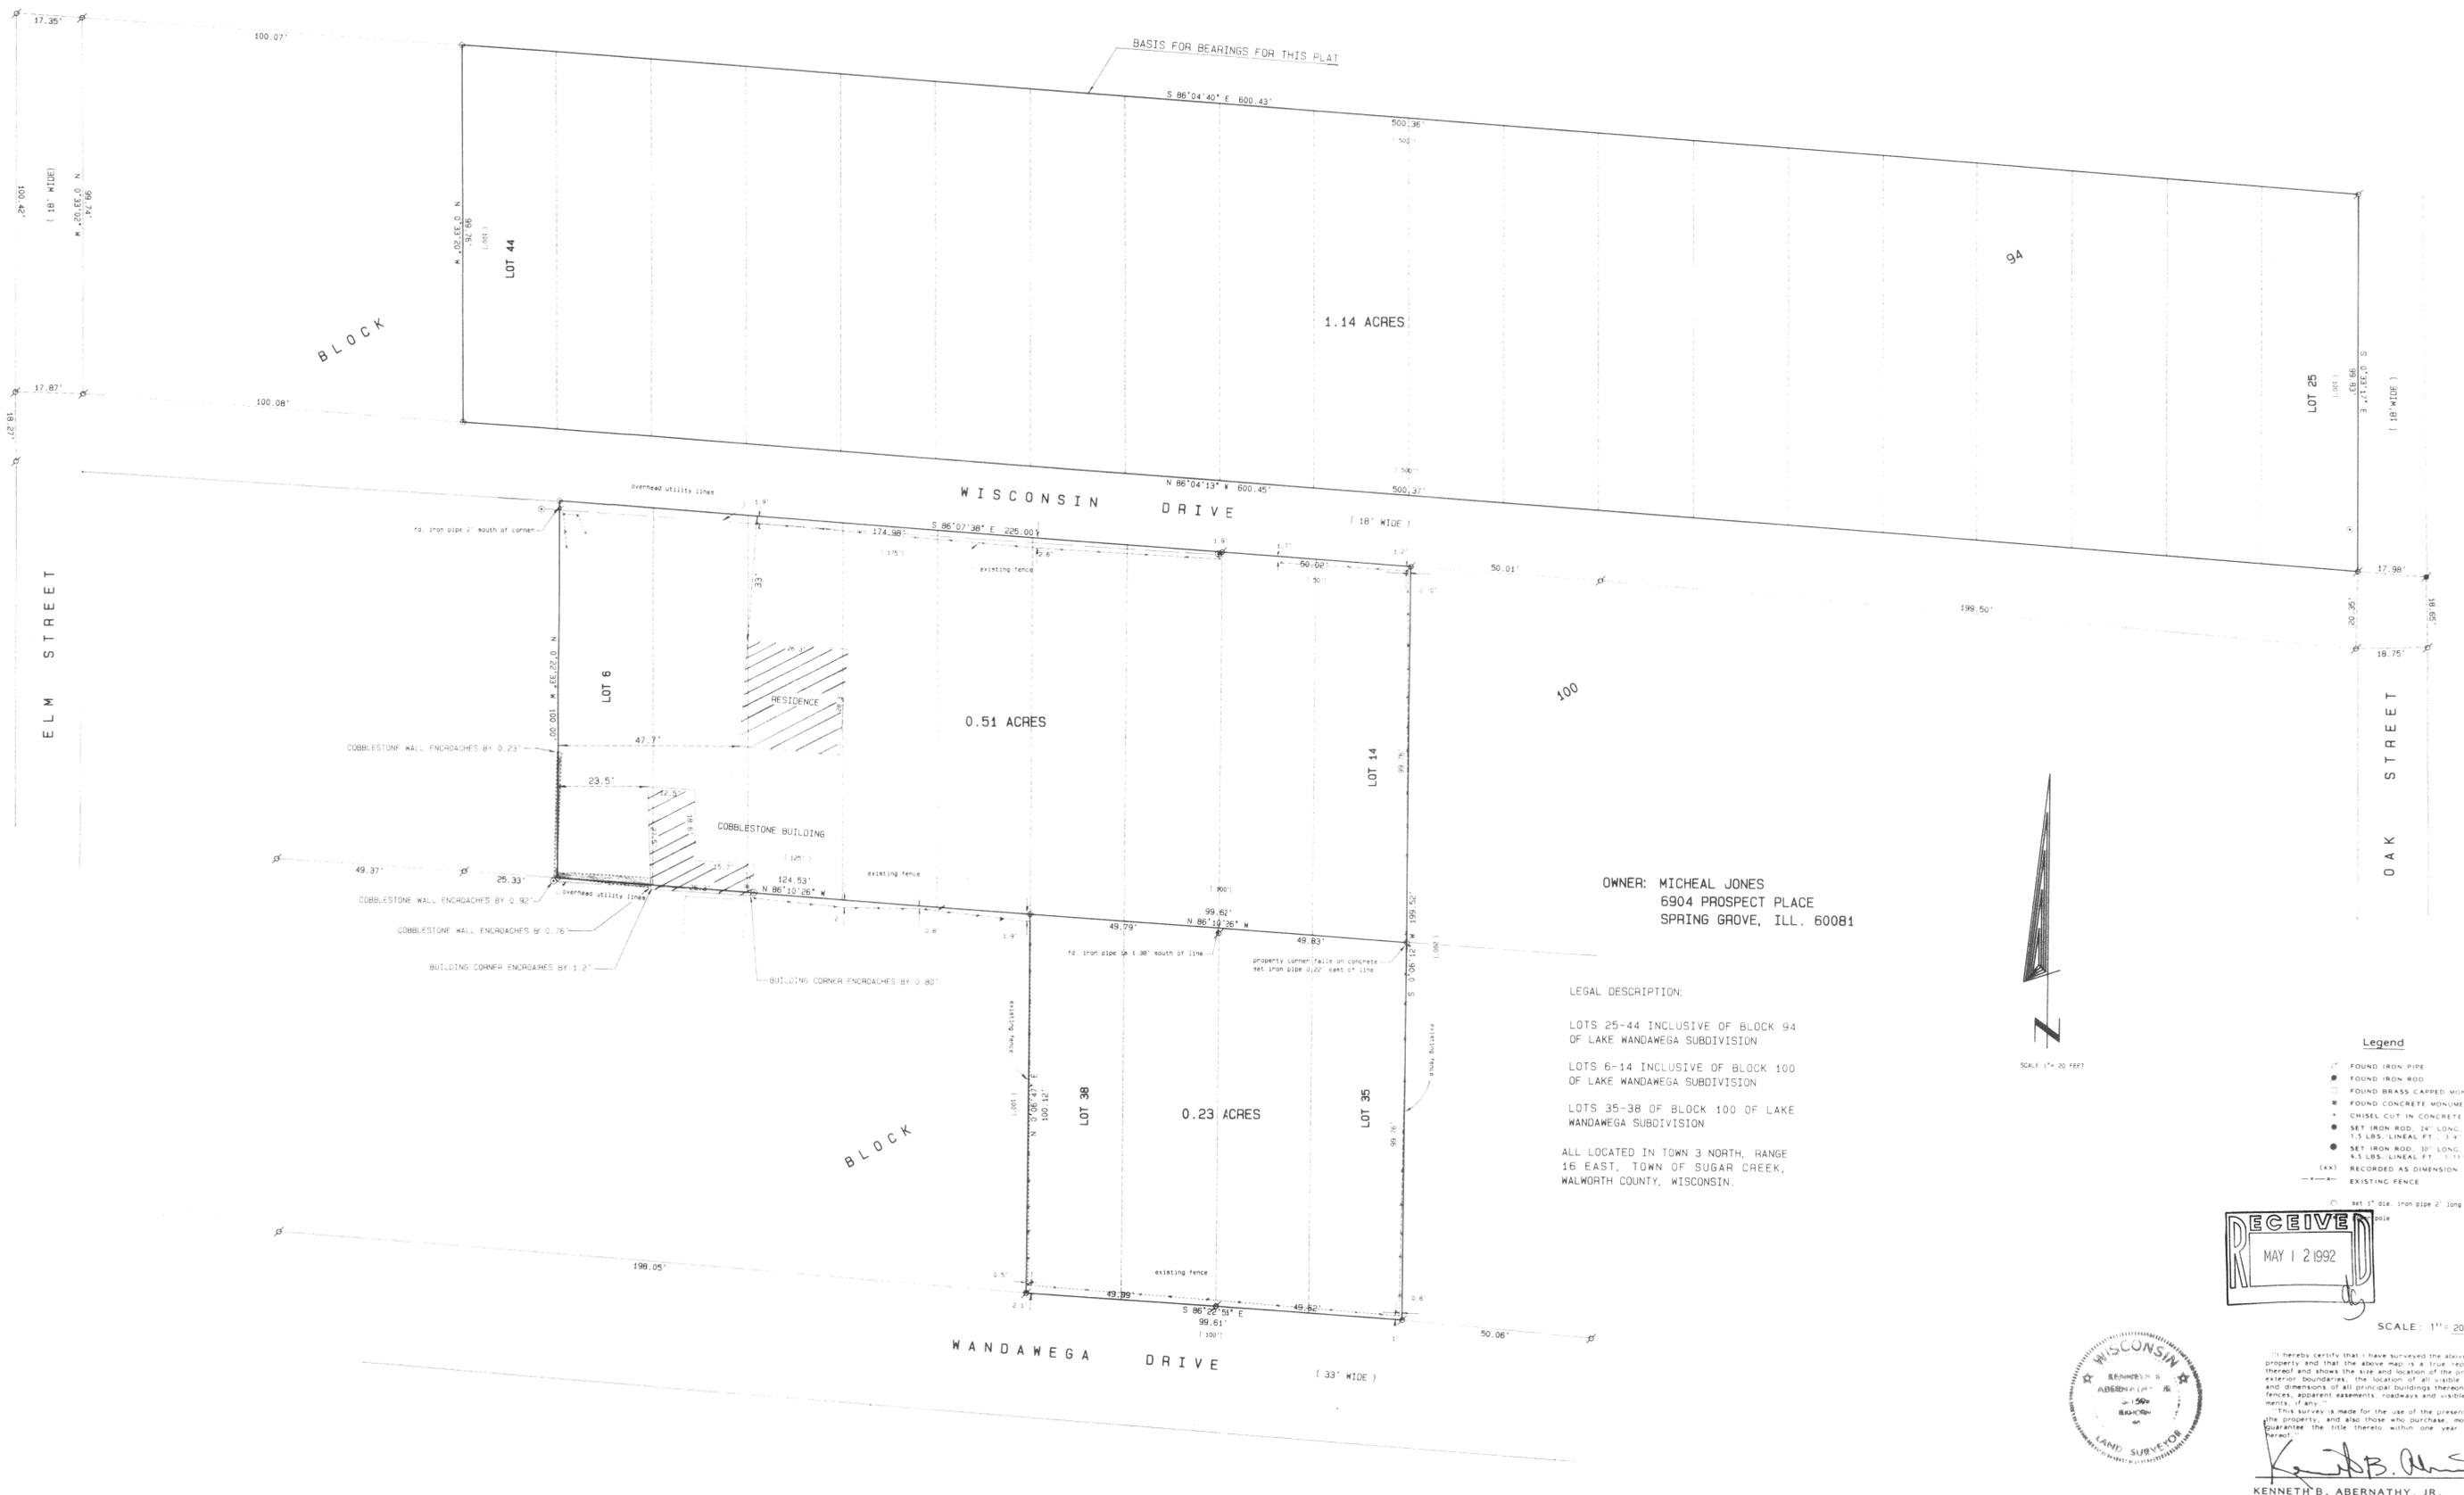

OWNER: MICHEAL JONES
 6904 PROSPECT PLACE
 SPRING GROVE, ILL. 60081

LEGAL DESCRIPTION:
 LOTS 25-44 INCLUSIVE OF BLOCK 94
 OF LAKE WANDAUEGA SUBDIVISION
 LOTS 6-14 INCLUSIVE OF BLOCK 100
 OF LAKE WANDAUEGA SUBDIVISION
 LOTS 35-38 OF BLOCK 100 OF LAKE
 WANDAUEGA SUBDIVISION
 ALL LOCATED IN TOWN 3 NORTH, RANGE
 16 EAST, TOWN OF SUGAR CREEK,
 WALWORTH COUNTY, WISCONSIN.



- Legend**
- ⊙ FOUND IRON PIPE
 - ⊙ FOUND IRON ROD
 - ⊙ FOUND BRASS CAPPED MONUMENT
 - ⊙ FOUND CONCRETE MONUMENT
 - ⊙ CHISEL CUT IN CONCRETE
 - ⊙ SET IRON ROD, 24" LONG, WEIGHING 1.5 LBS., LINEAL FT., 3/4" DIA.
 - ⊙ SET IRON ROD, 30" LONG, WEIGHING 4.5 LBS., LINEAL FT., 1 1/8" DIA.
 - (xx) RECORDED AS DIMENSION
 - - - EXISTING FENCE
 - ⊙ 1 1/2" dia. iron pipe 2" long



I hereby certify that I have surveyed the above described property and that the above map is a true representation thereof and shows the size and location of the property, its exterior boundaries, the location of all visible structures and dimensions of all principal buildings thereon, boundary fences, apparent easements, roadways and visible encroachments, if any.

This survey is made for the use of the present owners of the property, and also those who purchase, mortgage, or guarantee the title thereto within one year from the date hereof.

Kenneth B. Abernathy Jr.
 KENNETH B. ABERNATHY, JR.
 WISCONSIN REGISTERED LAND SURVEYOR,
 S-1594

Date: April 2, 1992 Job No. 1992.205