

ABERNATHY and ASSOCIATES


Kenneth B. Abernathy Jr.

Wisconsin Registered Land Surveyor S-1594

Rt. 3, Box 273
Elkhorn, Wisconsin 53121
Phone: (414) 723-4260 (office)
(414) 723-4813 (residence)

PLAT OF SURVEY

LOTS 7-11 AND LOTS 38-42 OF BLOCK
109 OF LAKE WANDAWEGA SUBDIVISION,
LOCATED IN THE SOUTHWEST 1/4 OF
SECTION 1, TOWN 3 NORTH, RANGE 16
EAST, WALWORTH COUNTY, WISCONSIN.

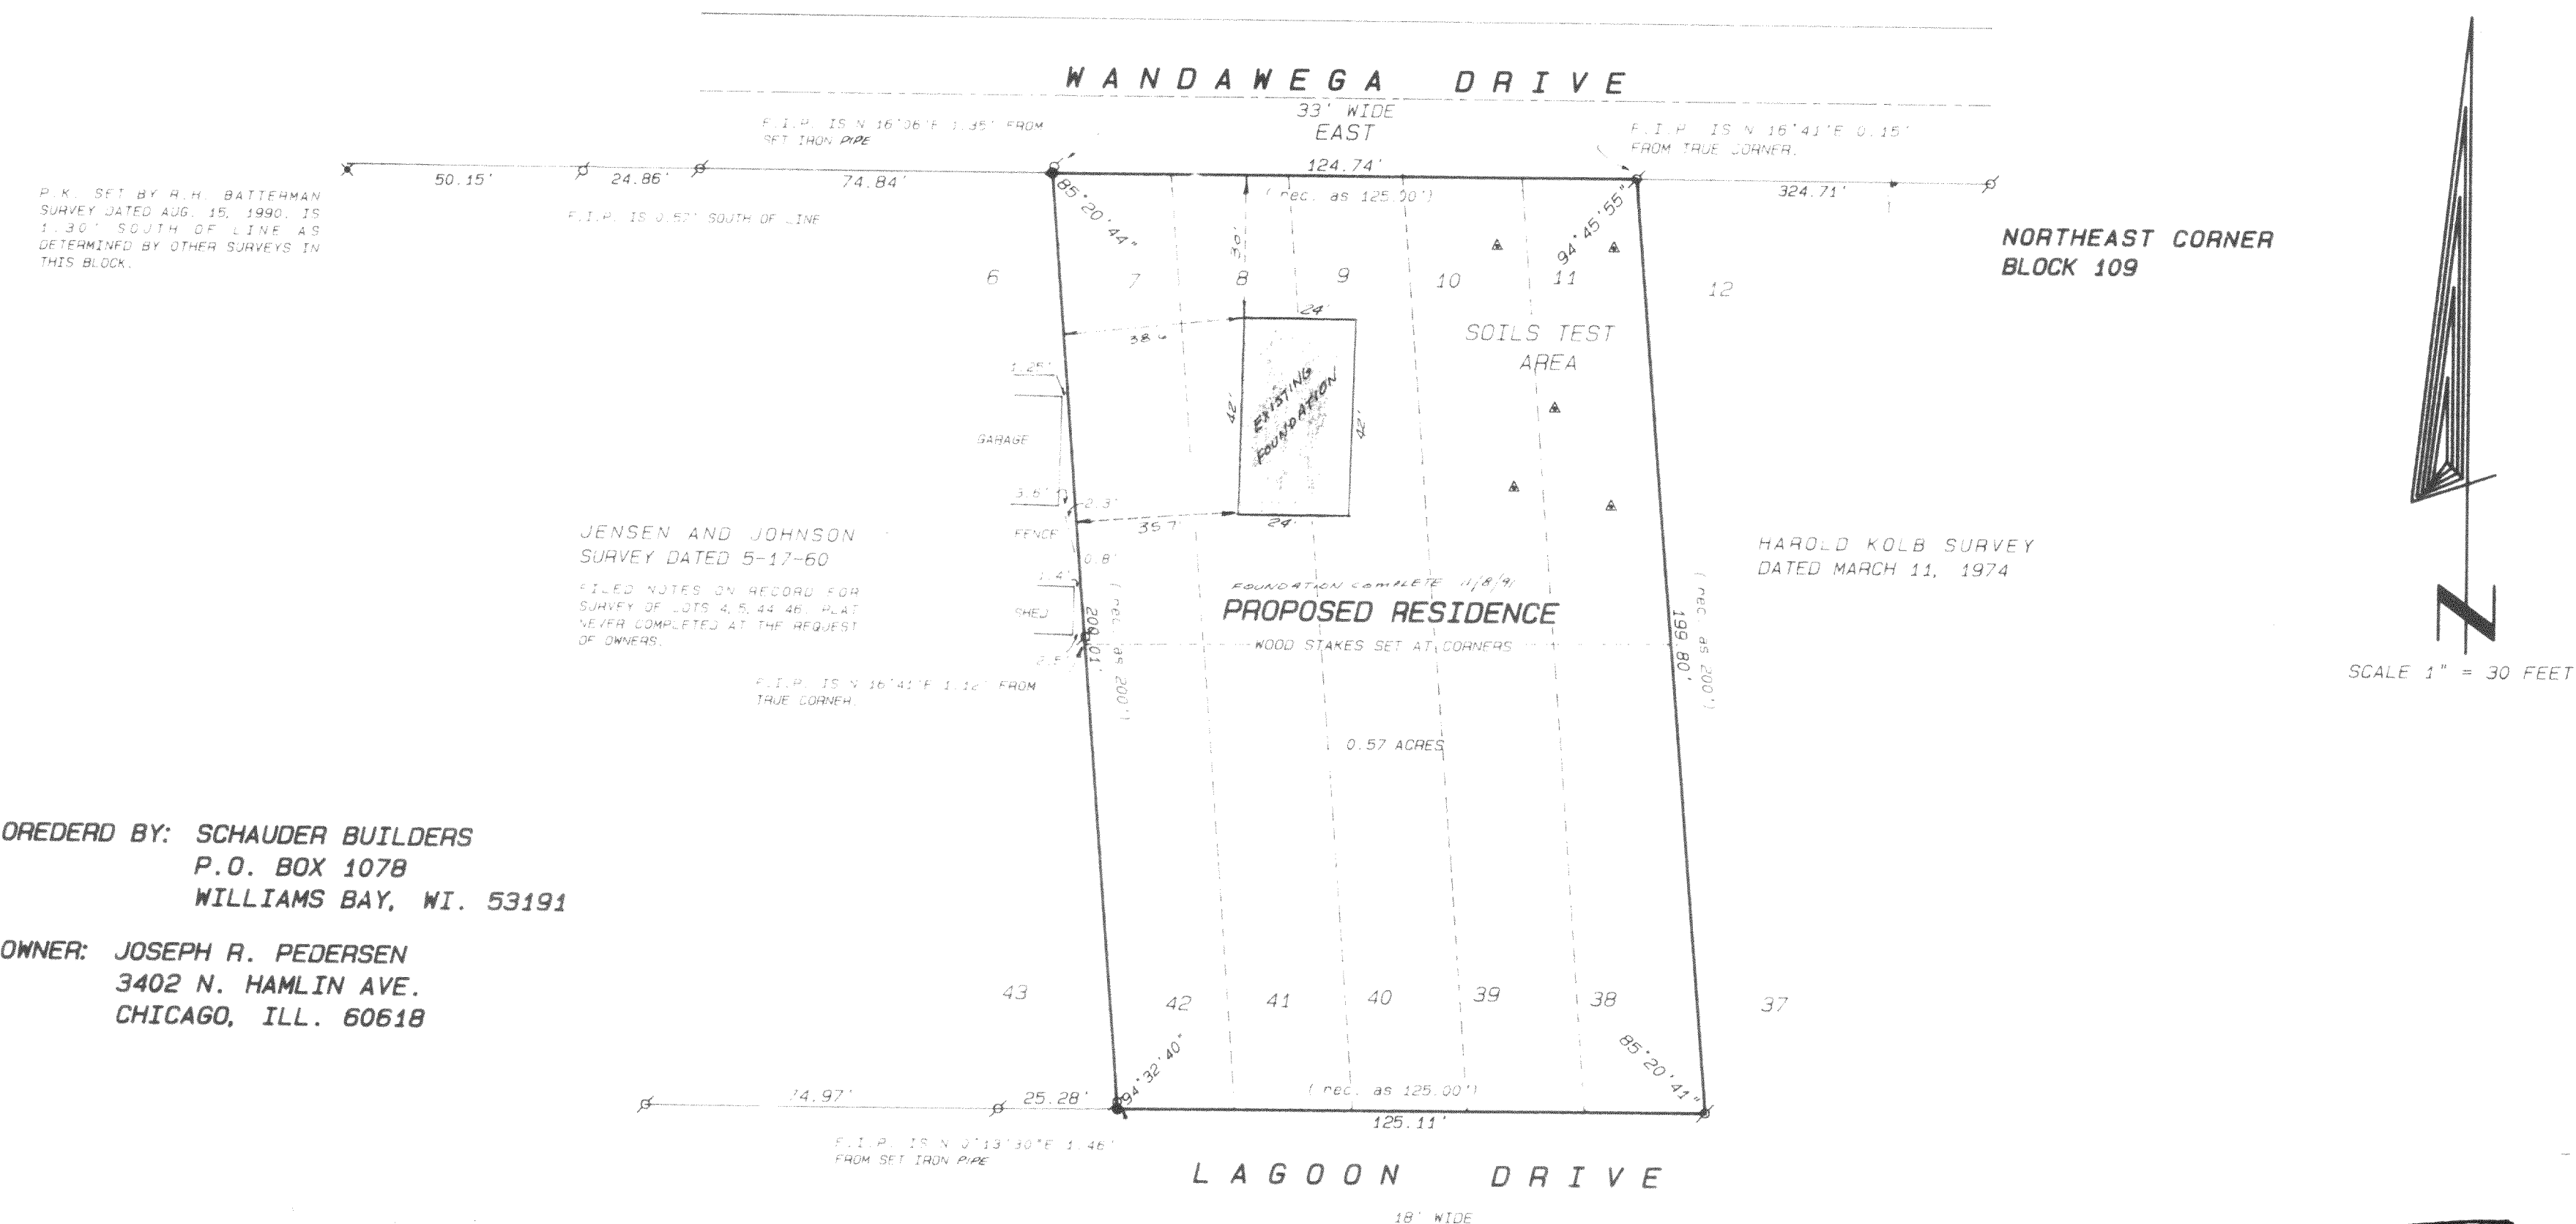


ORDERED BY: SCHAUDER BUILDERS
P.O. BOX 1078
WILLIAMS BAY, WI. 53191

OWNER: JOSEPH R. PEDERSEN
3402 N. HAMLIN AVE.
CHICAGO, ILL. 60618


NOTE:
THIS SURVEY RETRACES PREVIOUS SURVEYS BY
JENSEN AND JOHNSON AND HAROLD KOLB AS
INDICATED.

Legend

- FOUND IRON PIPE
- FOUND IRON ROD
- FOUND BRASS CAPPED MONUMENT
- FOUND CONCRETE MONUMENT
- CHISEL CUT IN CONCRETE
- SET IRON ROD, 24" LONG, WEIGHING 1.5 LBS. LINEAL FT., 3/4" DIA.
- SET IRON ROD, 30" LONG, WEIGHING 4.5 LBS. LINEAL FT., 1 1/4" DIA.
- (XX) RECORDED AS DIMENSION
- EXISTING FENCE

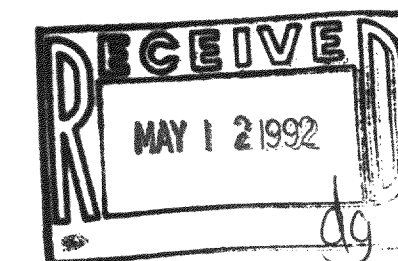

SCALE: 1" = 30 FEET

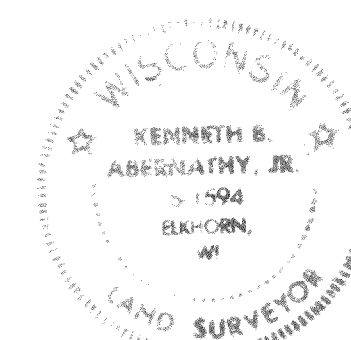

I hereby certify that I have surveyed the above described property and that the above map is a true representation thereof and shows the size and location of the property, its exterior boundaries, the location of all visible structures and dimensions of all principal buildings thereon, boundary fences, apparent easements, roadways and visible encroachments, if any.

This survey is made for the use of the present owners of the property, and also those who purchase, mortgage, or guarantee the title thereto within one year from date hereof.

Kenneth B. Abernathy, Jr.
KENNETH B. ABERNATHY, JR.
WISCONSIN REGISTERED LAND SURVEYOR,
S-1594

Date: OCTOBER 2, 1991 Job No. 9-94
REVISED 11/8/91 "AS BUILT"

ABERNATHY and ASSOCIATES




Kenneth B. Abernathy Jr.

Wisconsin Registered Land Surveyor S-1594

Rt. 3, Box 273
Elkhorn, Wisconsin 53121
Phone: (414) 723-4260 (office)
(414) 723-4813 (residence)

PLAT OF SURVEY

LOTS 7-11 AND LOTS 38-42 OF BLOCK
109 OF LAKE WANDAWEGA SUBDIVISION,
LOCATED IN THE SOUTHWEST 1/4 OF
SECTION 1, TOWN 3 NORTH, RANGE 16
EAST, WALWORTH COUNTY, WISCONSIN.

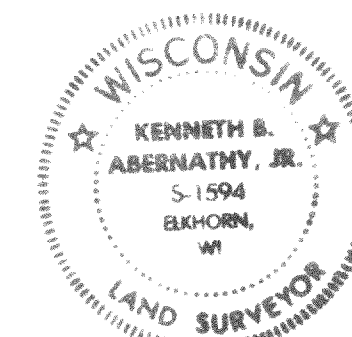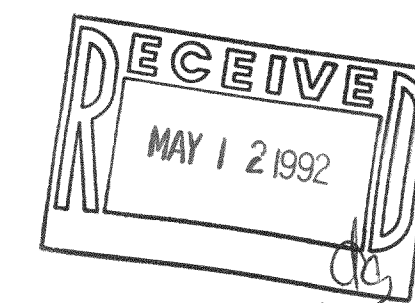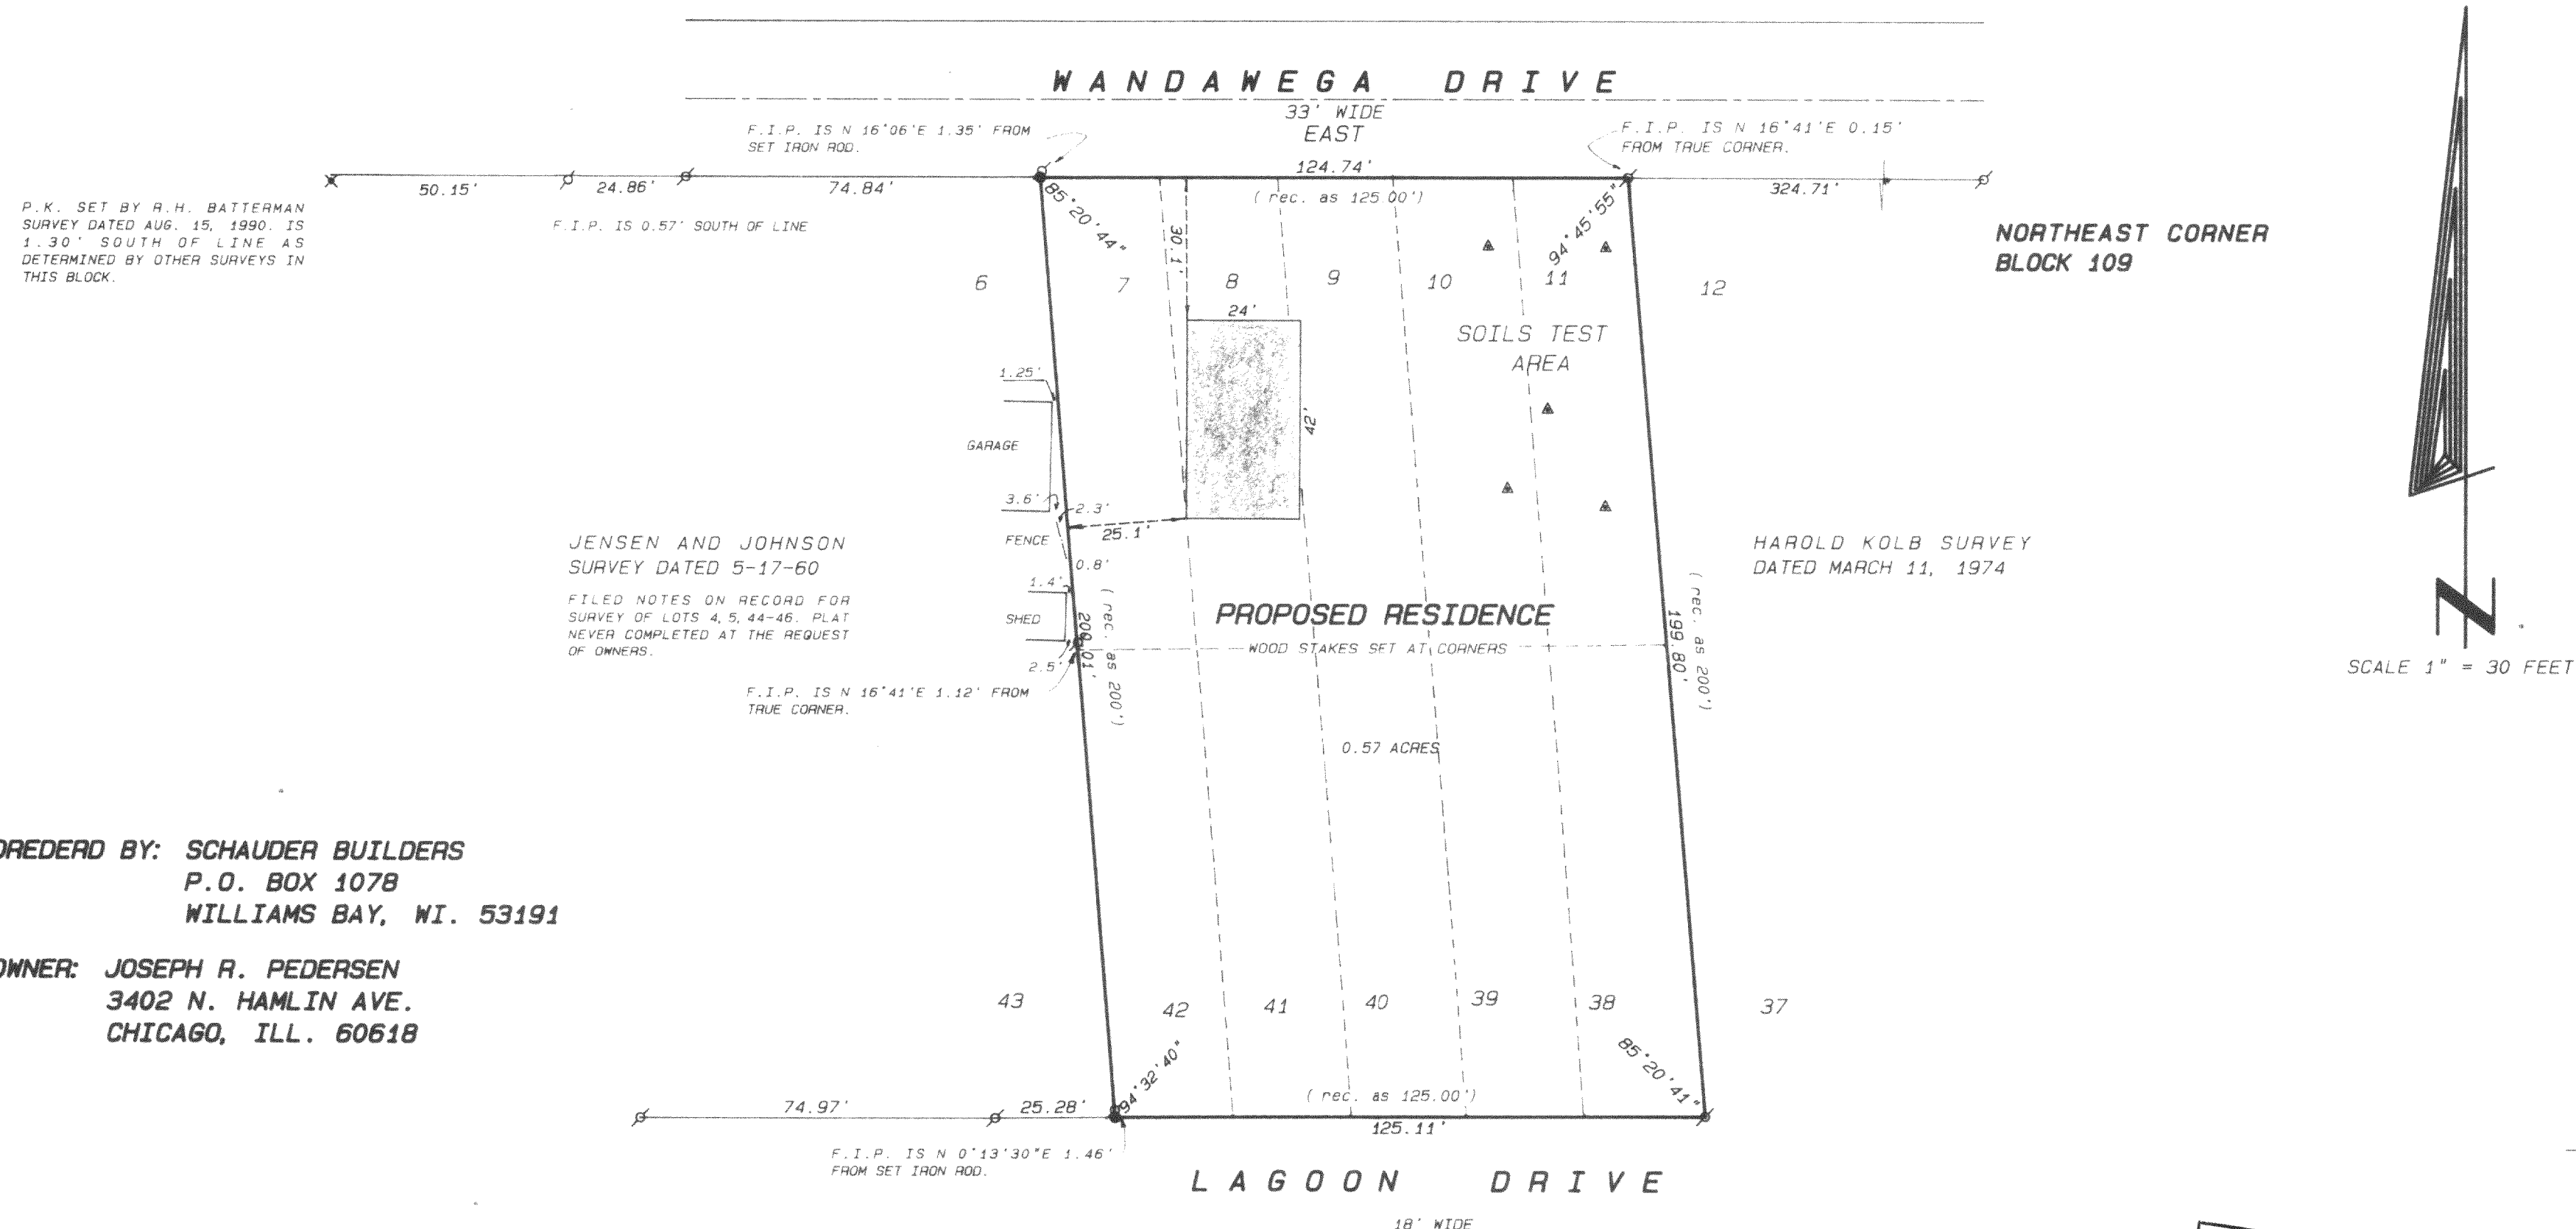

"I hereby certify that I have surveyed the above described property and that the above map is a true representation thereof and shows the size and location of the property, its exterior boundaries, the location of all visible structures and dimensions of all principal buildings thereon, boundary fences, apparent easements, roadways and visible encroachments, if any."

"This survey is made for the use of the present owners of the property, and also those who purchase, mortgage, or guarantee the title thereto within one year from date hereof."

Kenneth B. Abernathy, Jr.
KENNETH B. ABERNATHY, JR.
WISCONSIN REGISTERED LAND SURVEYOR,
S-1594

Date: OCTOBER 2, 1991 Job No. 9194