


ABELL
SURVEYING & MAPPING

DELAVAN, WISCONSIN 53115

414-728-6737

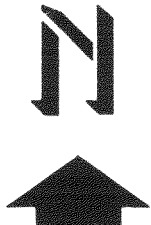


SCALE 1"=40'

LEGEND

- Ø - IRON PIPE FOUND
- - IRON PIPE SET
- () - RECORDED AS

NOTE: BEARINGS ARE REFERENCED TO THE
RECORDED SUBDIVISION PLAT.

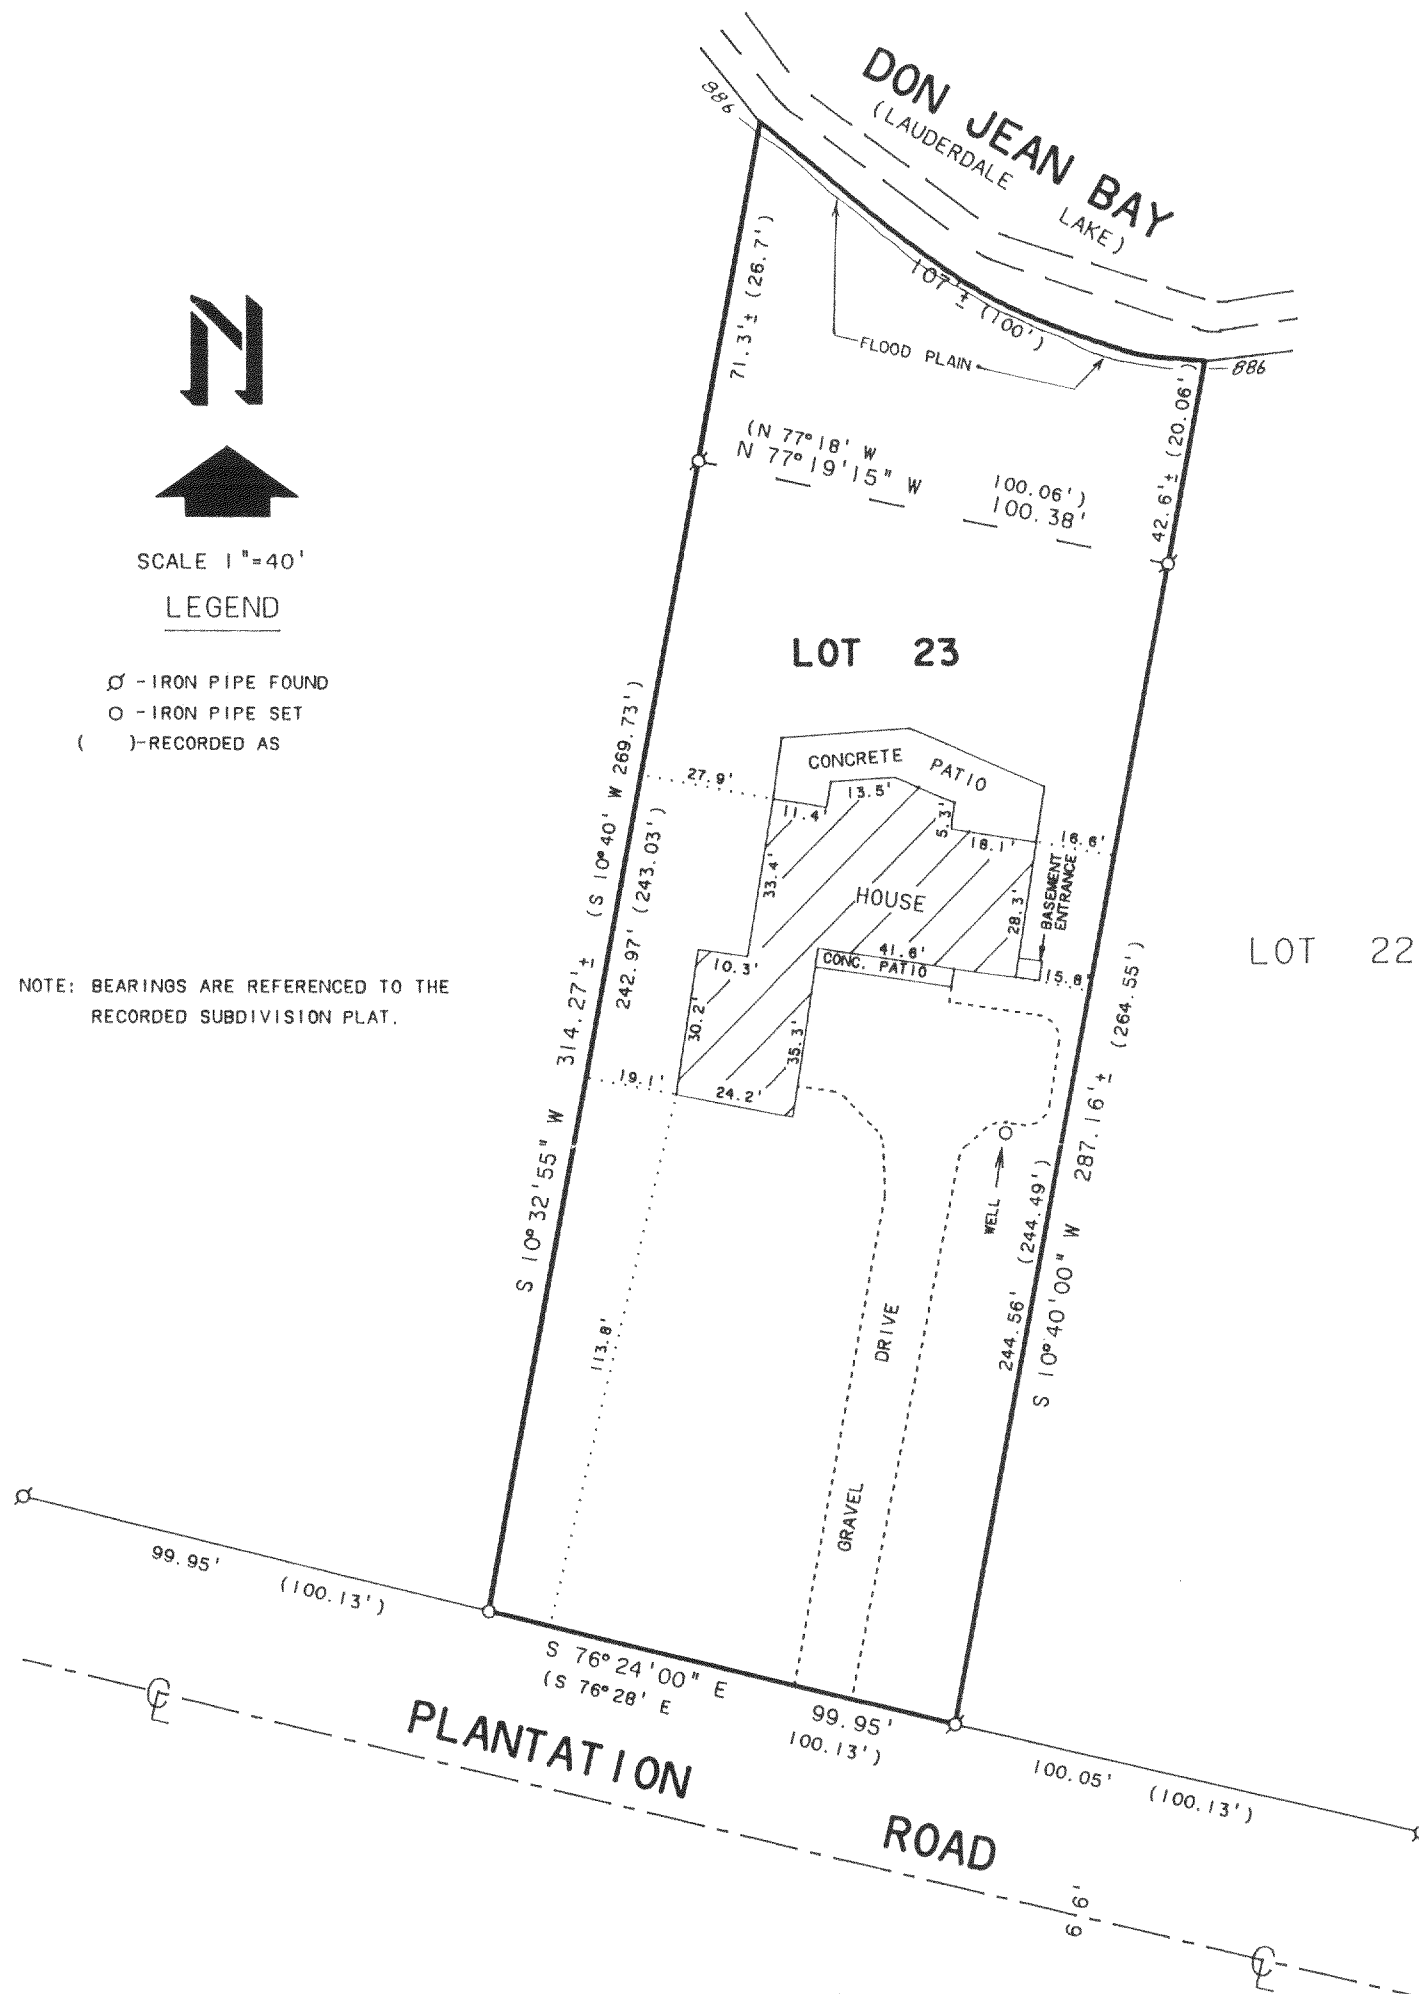

PLAT OF SURVEY OF

ORDERED BY: MONTSMA BUILDERS
917 RACINE ST.
DELAVAN, WI. 53115

LOT 23, BAYWOOD ESTATES, LOCATED IN
T3N, R16E, WALWORTH COUNTY, WISCONSIN.

REVISED: APRIL 3, 1992
TO SHOW THE LOCATION OF
THE FLOOD PLAIN.

ORDERED BY: PAT HONES
P.O. BOX 55
ELKHORN, WI. 53121


I, DAVID F. ABELL, DO HEREBY CERTIFY THAT I HAVE SURVEYED THE PROPERTY HEREON
DESCRIBED ACCORDING TO THE OFFICIAL RECORDS AND THAT THE PLAT HEREON IS A
CORRECT REPRESENTATION OF THE PROPERTY LINES TO THE BEST OF MY KNOWLEDGE AND
BELIEF.

David F. Abell

DAVID F. ABELL
WISCONSIN REGISTERED LAND SURVEYOR, S-1596

May 3, 1991

DATE: May 3, 1991 JOB NUMBER - 91087
NOTE: THIS IS NOT A CERTIFIED COPY UNLESS SEALED.

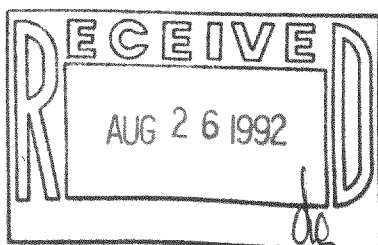

316-577

GBE-23