


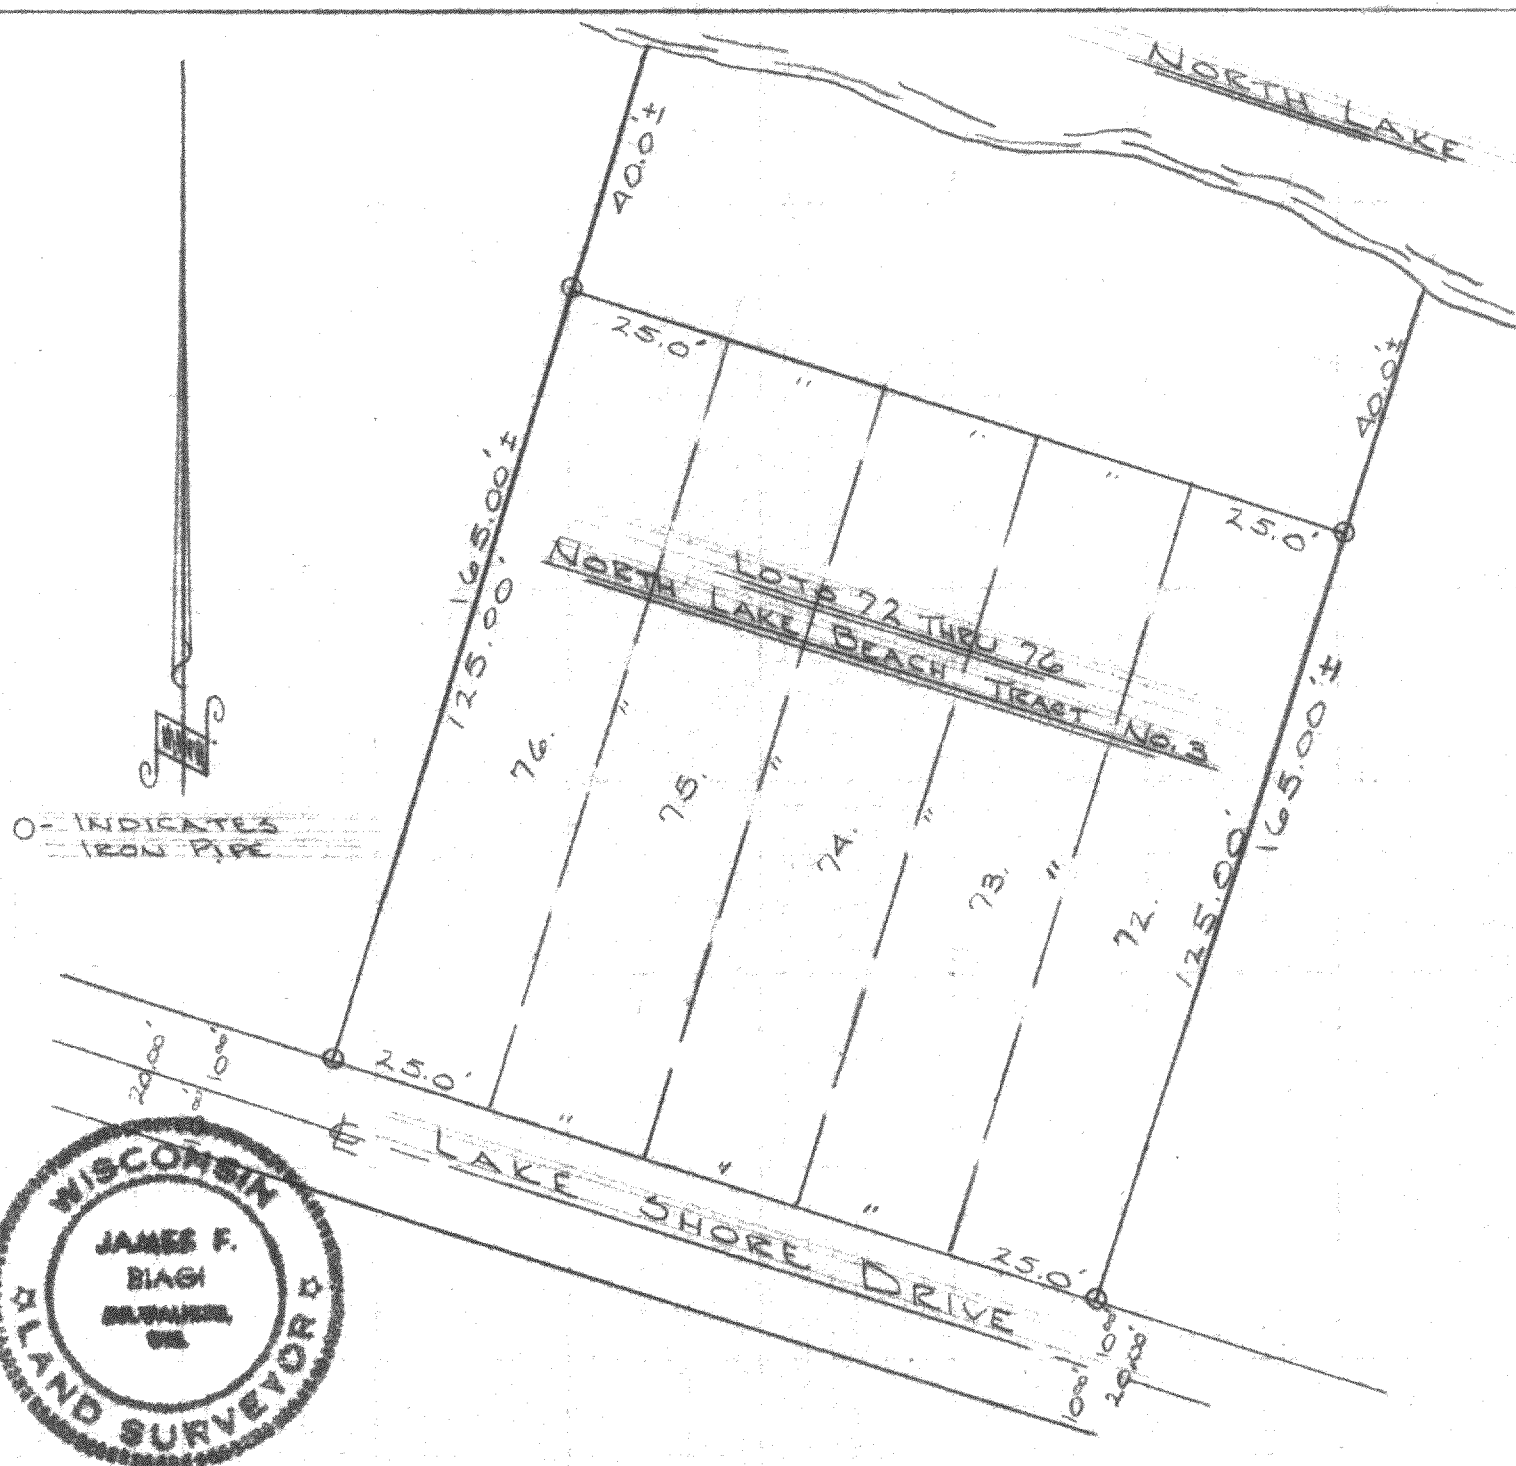

DESCRIPTION: Lots 72, 73, 74, 75, and 76 of Tract No. 3 of North Lake Beach Subdivision located in Section 8, T. 3 N., R. 16 E., Walworth County, Wisconsin, BLK A.

CERTIFICATE: I, James F. Biagi, surveyor do hereby certify that I have surveyed the property hereon described.


March 31, 1970.

James F. Biagi, R.L.S. 272

6N1B3-321

3/1/60

#42-70

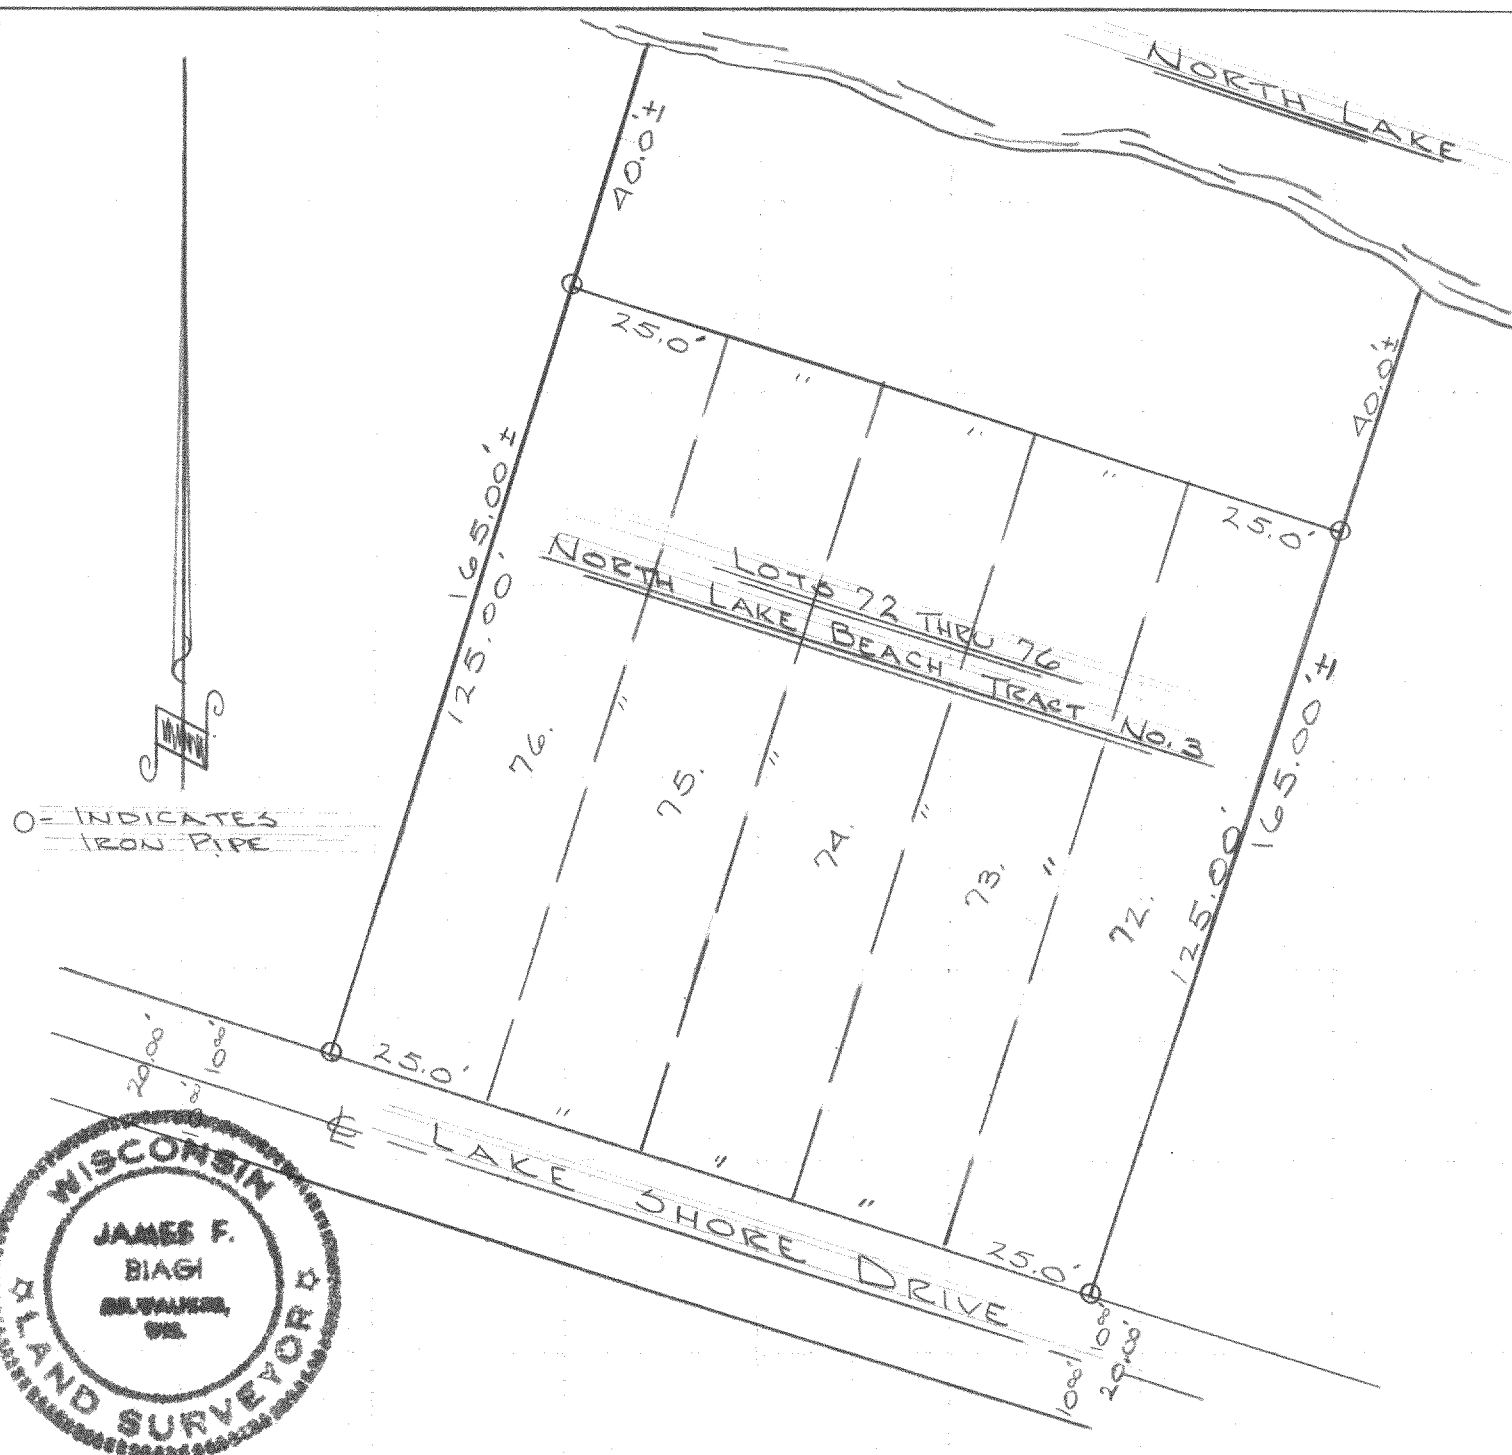

DESCRIPTION: Lots 72, 73, 74, 75, and 76 of Tract No. 3 of North Lake Beach Subdivision located in Section 8, T. 3 N., R. 16 E., Walworth County, Wisconsin.

CERTIFICATE: I, James F. Biagi, surveyor do hereby certify that I have surveyed the property hereon described.

March 31, 1970.

James F. Biagi, R.L.S. 272

316-57B