


THIS PARCEL Now Part of CSM 2051, LOT 1 - Doc # 235642

Vol. 574 Pg. 678

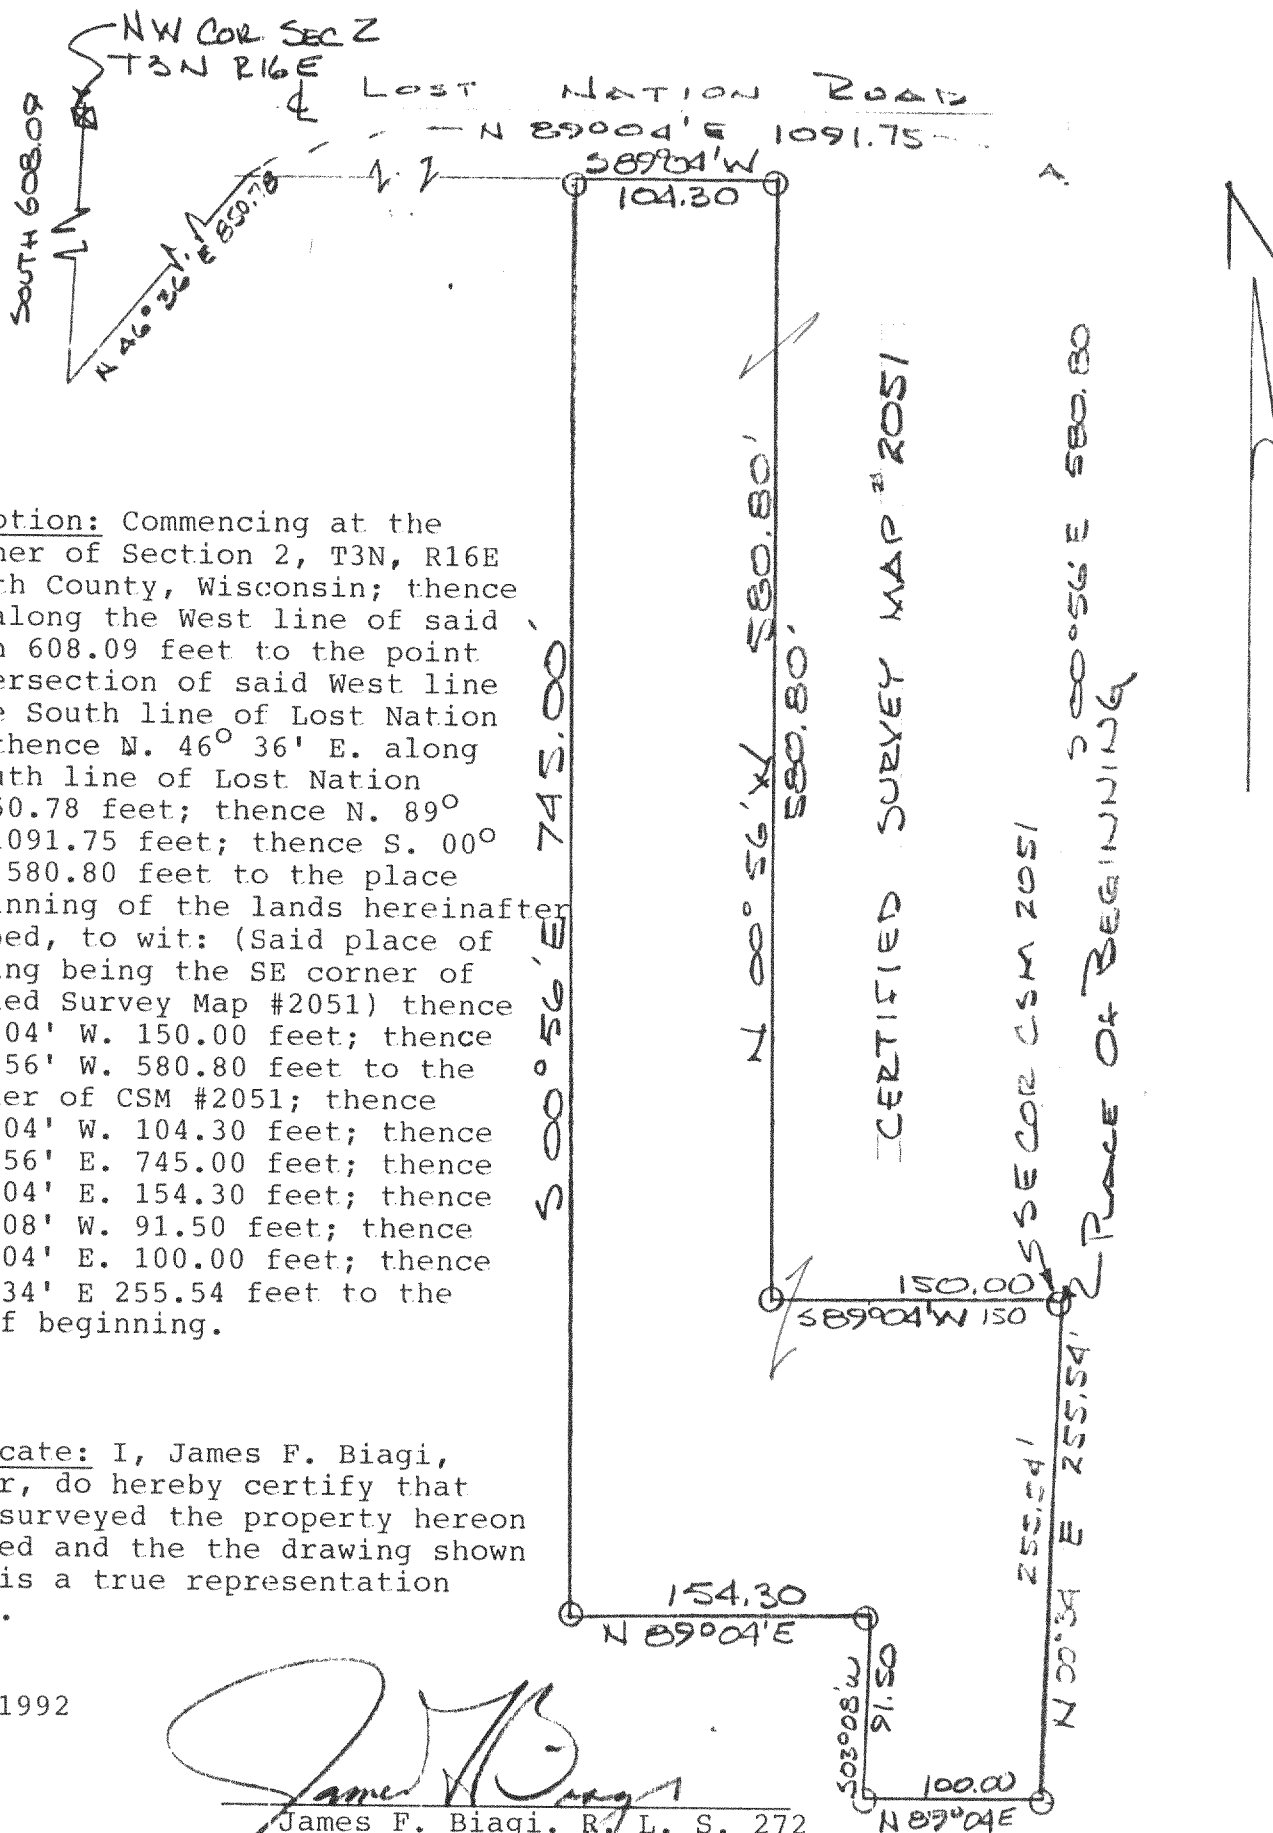


Description: Commencing at the NW corner of Section 2, T3N, R16E Walworth County, Wisconsin; thence South along the West line of said Section 608.09 feet to the point of intersection of said West line and the South line of Lost Nation Road; thence N. 46° 36' E. along the South line of Lost Nation Road 850.78 feet; thence N. 89° 04' E 1091.75 feet; thence S. 00° 56' E. 580.80 feet to the place of beginning of the lands hereinafter described, to wit: (Said place of beginning being the SE corner of Certified Survey Map #2051) thence S. 89° 04' W. 150.00 feet; thence N. 00° 56' W. 580.80 feet to the NW corner of CSM #2051; thence S. 89° 04' W. 104.30 feet; thence S. 00° 56' E. 745.00 feet; thence N. 89° 04' E. 154.30 feet; thence S. 03° 08' W. 91.50 feet; thence N. 89° 04' E. 100.00 feet; thence N. 00° 34' E 255.54 feet to the place of beginning.

Certificate: I, James F. Biagi, surveyor, do hereby certify that I have surveyed the property hereon described and the the drawing shown hereon is a true representation thereof.

May 5, 1992

James F. Biagi, R. L. S. 272

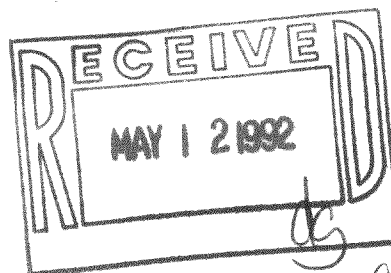

GA-2051-1

316-584