


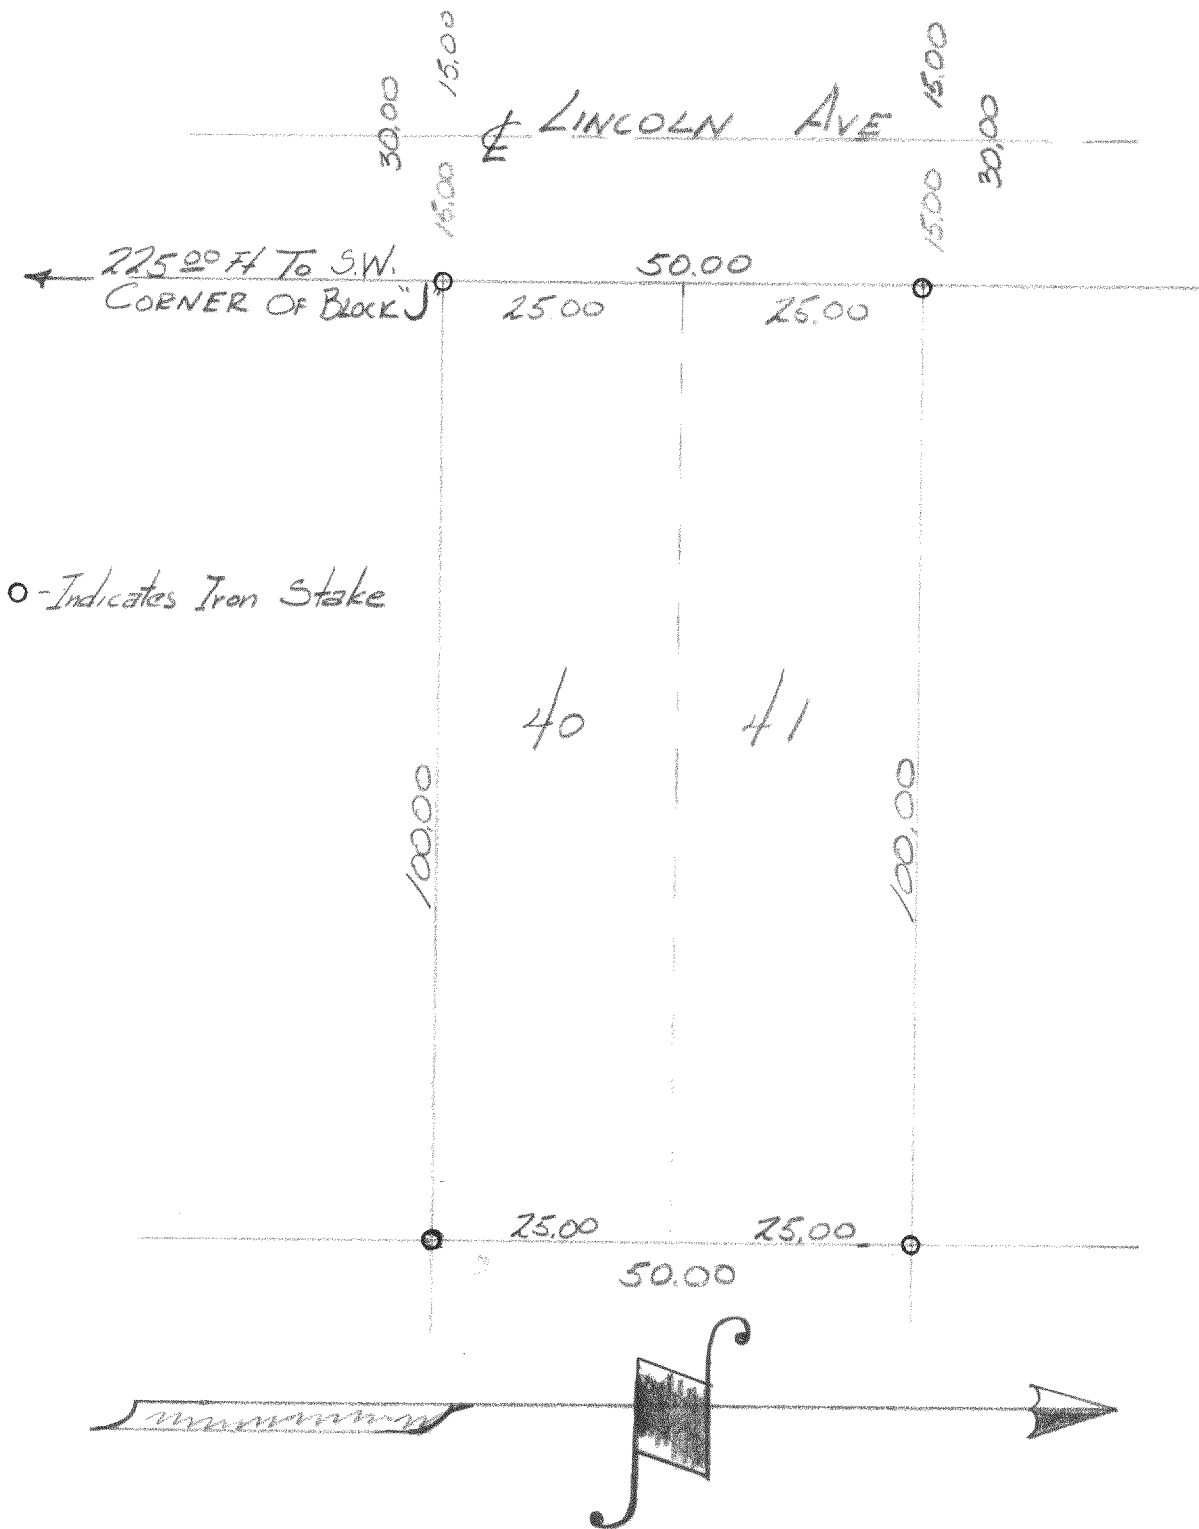


o - Indicates Iron Stake

DESCRIPTION: Lots 40 and 41 of Block J in North Lake Lake Beach Track No. 1, in Sections 5 and 8 of Town 3 North, Range 16 East, of the 4th Principal Meridian, Walworth County.

CERTIFICATE: I hereby certify that I have on this 28th day of October 1958, surveyed the above described property in accordance with the official records on file in the Register of Deeds office in and for Walworth County; I further certify that said survey corresponds with the description and drawing hereon shown.

SIGNED AND SEALED ON THIS THE 29th DAY OF OCTOBER 1958

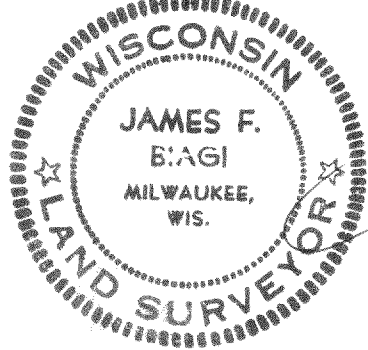

James F. Biagi
SURVEYOR NO. (272)