




PLAT OF SURVEY

LOT 2 OF COUNTRYSIDE
SUBDIVISION, located
in the Northwest 1/4
of Section 3, Town 3
North, Range 16 East,
Town of Sugar Creek,
Walworth County,
Wisconsin.

P R I V A T E L A K E

ORDERED BY: Ray Leanna Construction, Inc.
760 West Wisconsin St.
Palmyra, WI. 53156

OWNERS: Jim and Amy Ehlers
401 W. Center
Whitewater, WI 53190

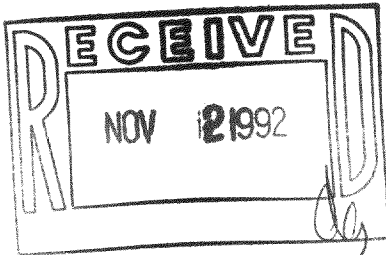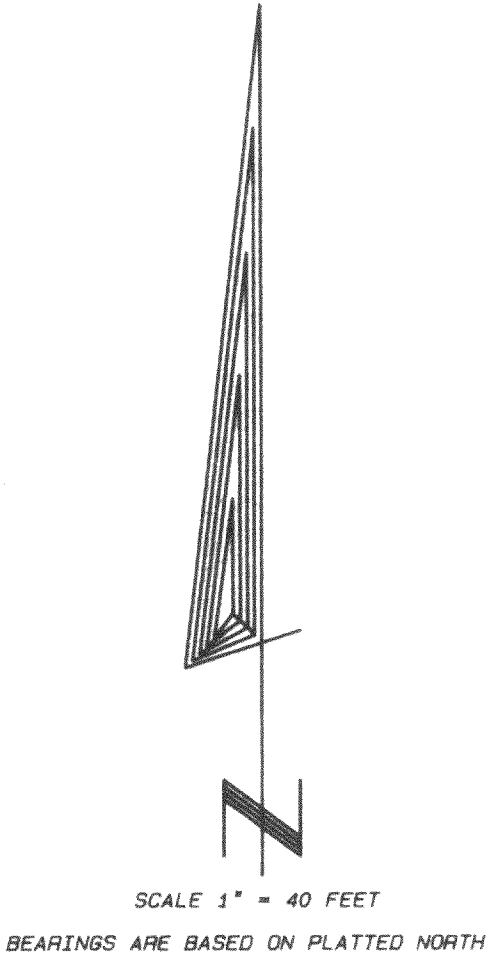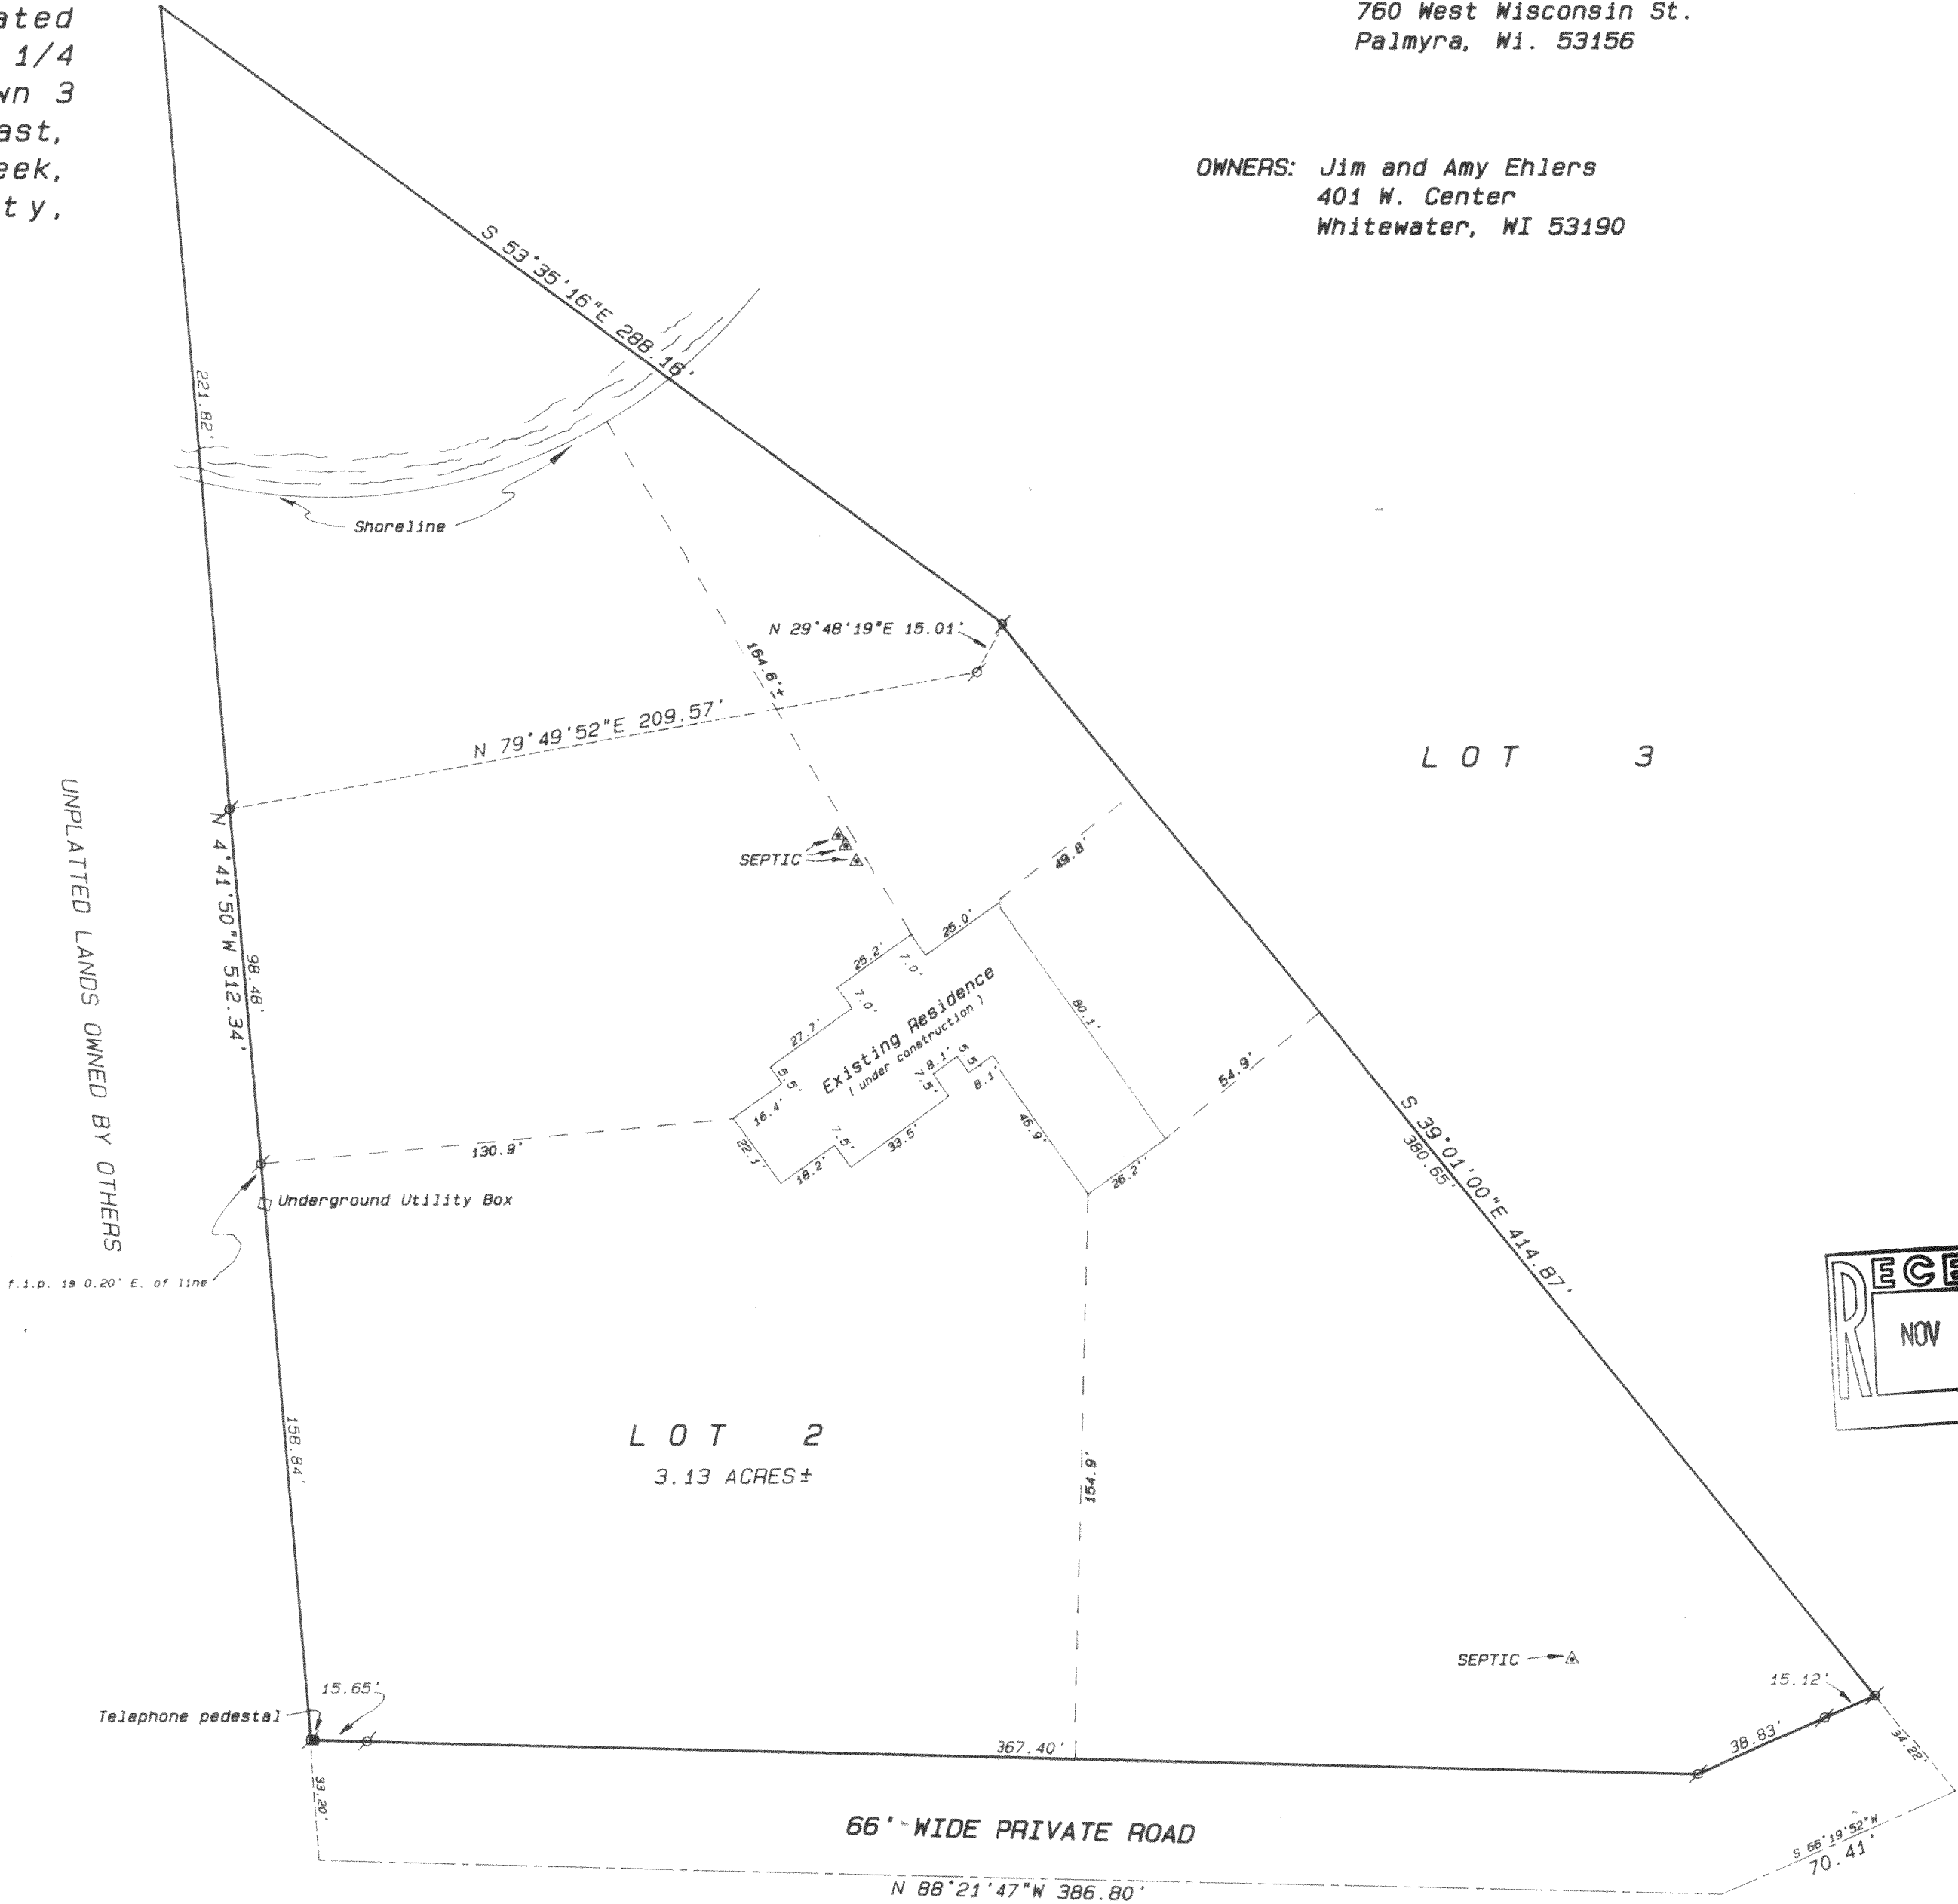

- Legend
- FOUND IRON PIPE
 - FOUND IRON ROD
 - FOUND BRASS CAPPED MONUMENT
 - FOUND CONCRETE MONUMENT
 - CHISEL CUT IN CONCRETE
 - SET IRON ROD, 24" LONG, WEIGHING 1.5 LBS., LINEAL FT., 3/8" DIA.
 - SET IRON ROD, 30" LONG, WEIGHING 4.5 LBS., LINEAL FT., 1-11/16" DIA.
 - RECORDED AS DIMENSION
 - EXISTING FENCE



I hereby certify that I have surveyed the above described property and that the above map is a true representation thereof and shows the size and location of the property, its exterior boundaries, the location of all visible structures and dimensions of all principal buildings thereon, boundary fences, apparent easements, roadways and visible encroachments, if any.

This survey is made for the use of the present owners of the property, and also those who purchase, mortgage, or guarantee the title thereto within one year from date hereof.

Kenneth B. Abernathy Jr.
KENNETH B. ABERNATHY, JR.
WISCONSIN REGISTERED LAND SURVEYOR,
S-1594
June 11, 1992 (as-built)
Date: February 12, 1992 Job No. 1992.201