

ABERNATHY and ASSOCIATES

Kenneth B. Abernathy Jr.

Wisconsin Registered Land Surveyor S-1594



Rt. 3, Box 273
Elkhorn, Wisconsin 53121
Phone: (414) 723-4260 (office)
(414) 723-4813 (residence)

PLAT OF SURVEY

THE SOUTH ONE-HALF OF LOT 21,
LOTS 22 AND 23 OF BLOCK 59 OF
THE FOURTH MAP OF INTERLAKEN,
A SUBDIVISION LOCATED IN
SECTION 11, TOWN 3 NORTH,
RANGE 16 EAST, TOWN OF SUGAR
CREEK, WALWORTH COUNTY,
WISCONSIN.


Ordered by: Century 21 Wood Realty
704 North Lincoln
Elkhorn, WI. 53121

Owner: Carl K. Miller Jr.
4731 E. Carol Ave.
Mesa, Az. 85206

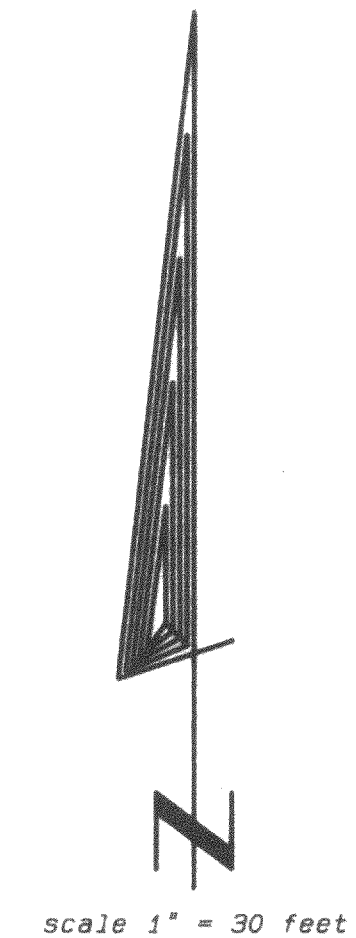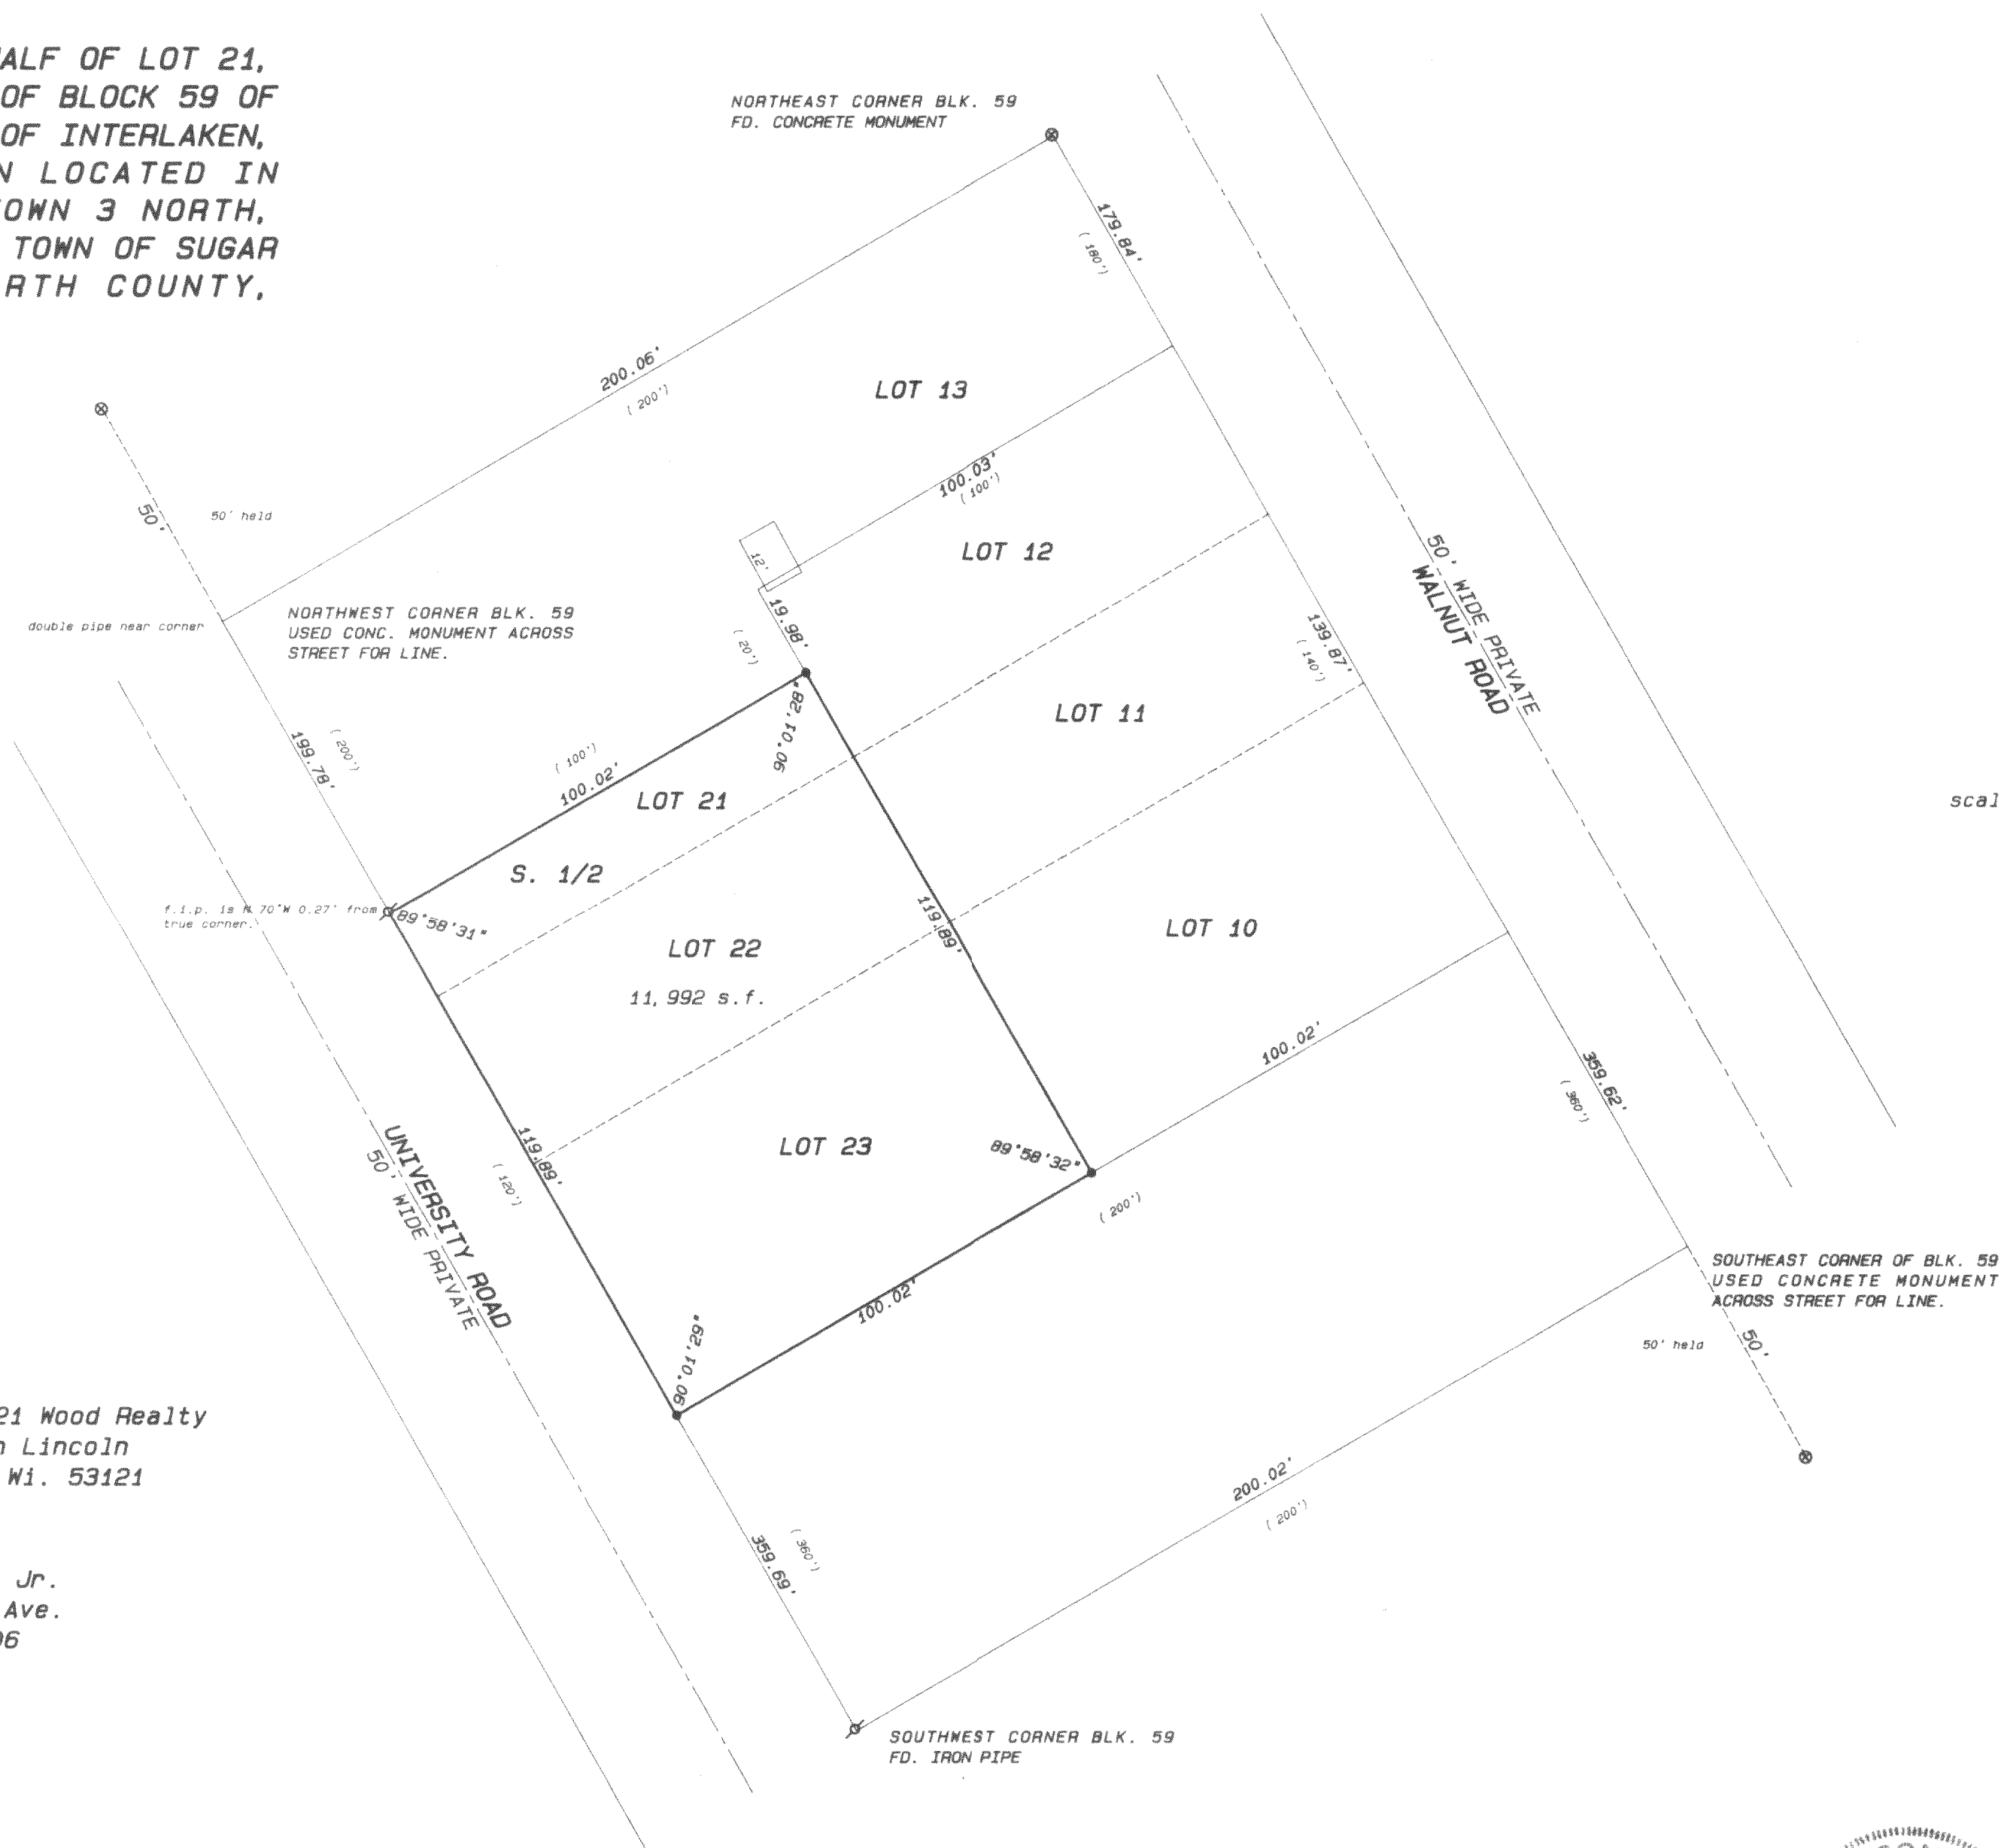

Legend

- FOUND IRON PIPE
- FOUND IRON ROD
- FOUND BRASS CAPPED MONUMENT
- FOUND CONCRETE MONUMENT
- CHISEL CUT IN CONCRETE
- SET IRON ROD, 24" LONG, WEIGHING 1.5 LBS./LINEAL FT., 3/4" DIA.
- SET IRON ROD, 30" LONG, WEIGHING 4.5 LBS./LINEAL FT., 1-11/16" DIA.
- RECORDED AS DIMENSION
- EXISTING FENCE

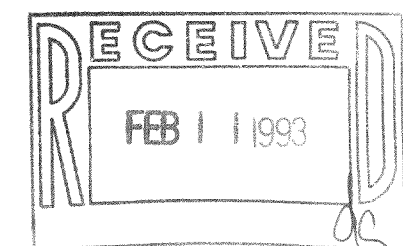

SCALE: 1" = 30 FEET

"I hereby certify that I have surveyed the above described property and that the above map is a true representation thereof and shows the size and location of the property, its exterior boundaries, the location of all visible structures and dimensions of all principal buildings thereon, boundary fences, apparent easements, roadways and visible encroachments, if any."

"This survey is made for the use of the present owners of the property, and also those who purchase, mortgage, or guarantee the title thereto within one year from date hereof."

Kenneth B. Abernathy Jr.

KENNETH B. ABERNATHY, JR.
WISCONSIN REGISTERED LAND SURVEYOR,
S-1594

Date: 12/1/92 Job No. 92.1017

