
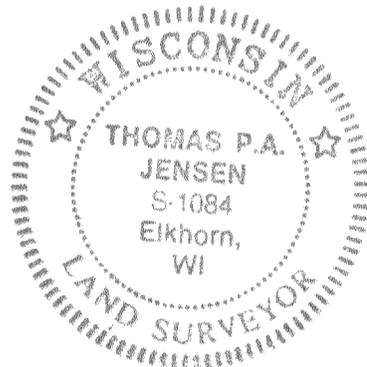


Plat of Survey

of

LOTS 11 THROUGH 17, BLOCK 9 OF NORTH LAKE SHOREWOODS, A SUBDIVISION
 LOCATED IN THE EAST 1/2 OF SECTION 5, T 3 N, R 16 E
 WALWORTH COUNTY, WISCONSIN


Surveyed for: EMIL ARENS
 RT 2, BOX 165A
 ELKHORN, WI 53121

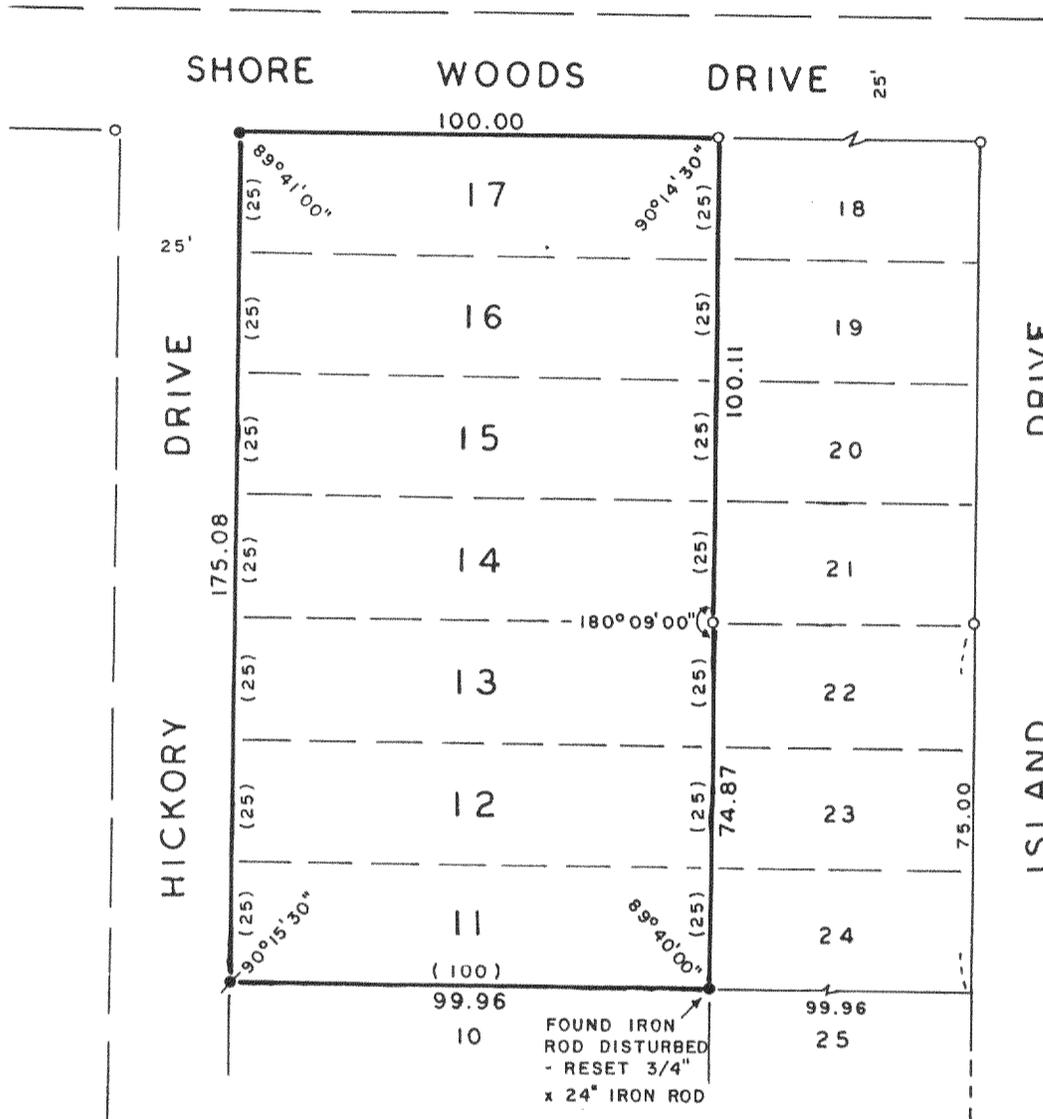

Copyright © 1991 by Jensen Surveying & Mapping S.C.
 All rights reserved. No part of this survey plat may be reproduced or transmitted in any form by any means - graphic, electronic, or mechanical, including photocopying, tracing, or information storage and retrieval systems - without permission in writing from Thomas P.A. Jensen.

I, Thomas P.A. Jensen, Wisconsin Registered Land Surveyor, do hereby certify that this survey was performed by me, or under my direction, in full compliance with the owner's/agent's instructions and Chapter A-E 7 of the Wisconsin Administrative Code 'Minimum Standards For Property Surveys', and that this map is an accurate representation thereof to the best of my knowledge and belief.

Note: This survey plat is not certified unless signed and sealed in red ink.

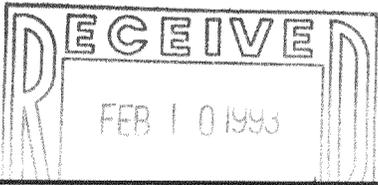

Thomas P.A. Jensen
 Thomas P.A. Jensen R.L.S. 1084

Legend

- Found iron pipe
- Found iron rod
-) Recorded as dimension
- SET IRON ROD, 3/4" DIAM.

Jensen Surveying & Mapping S.C.

45 South Wisconsin Street P.O. Box 322
 Elkhorn, Wisconsin. 53121.
 (414) 723-3434

Mapping date: NOVEMBER 27, 1991

Revisions: 316-606

Sheet 1 of 1 Sheets

Job reference number:

1991.181C

Scale: 1 = 40'



GNLS-94