
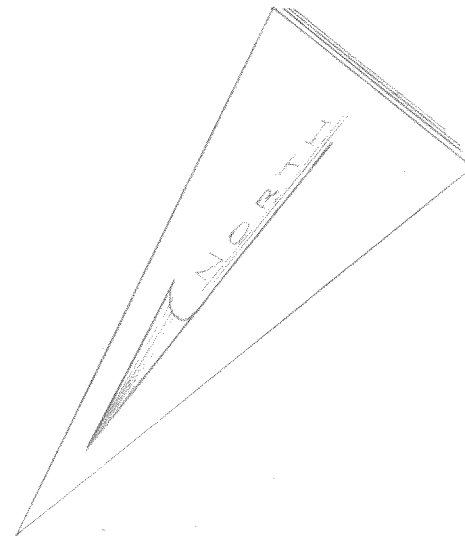


1994-65

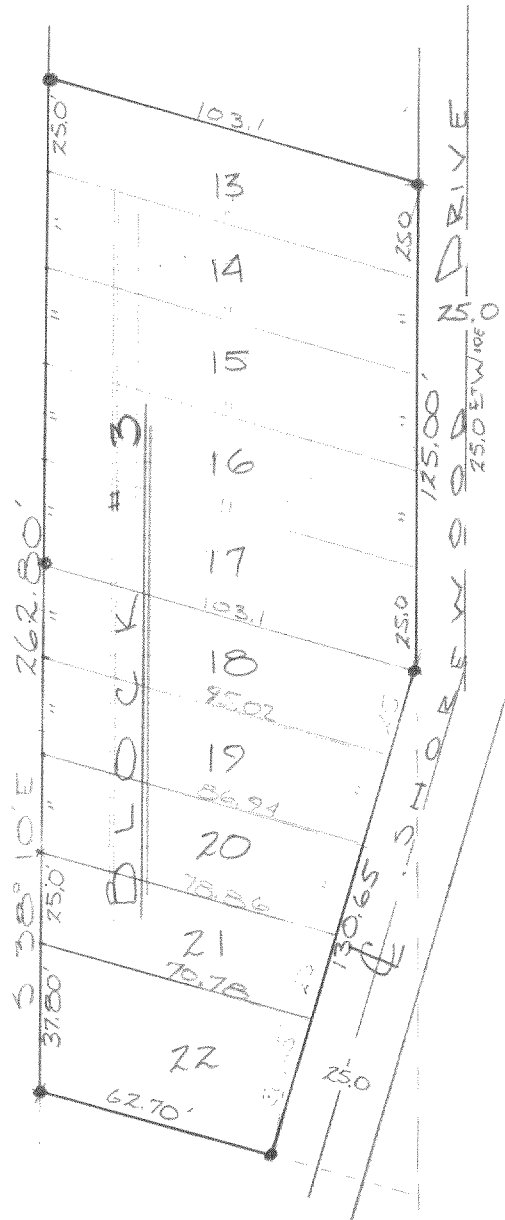


• - INDICATES IRON PIPE

DESCRIPTION: Lots 13, 14, 15, 16, 17, 18, 19, 20, 21, & 22 of Block 3 of North Lake Shorewoods Subdivision, Located in Section 5, T. 3 N., R. 16 E., Walworth County, Wisconsin.

CERTIFICATE: I, James F. Biagi, Surveyor do hereby certify that I have surveyed the property hereon described.

August 2, 1965.

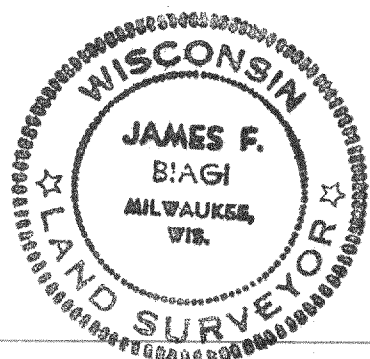

James F. Biagi
James F. Biagi, RLS 272

G-NLS 27, 28

316-60B