


HAROLD H. KOLB

REGISTERED PROFESSIONAL LAND SURVEYOR
LAKE GENEVA, WISCONSIN

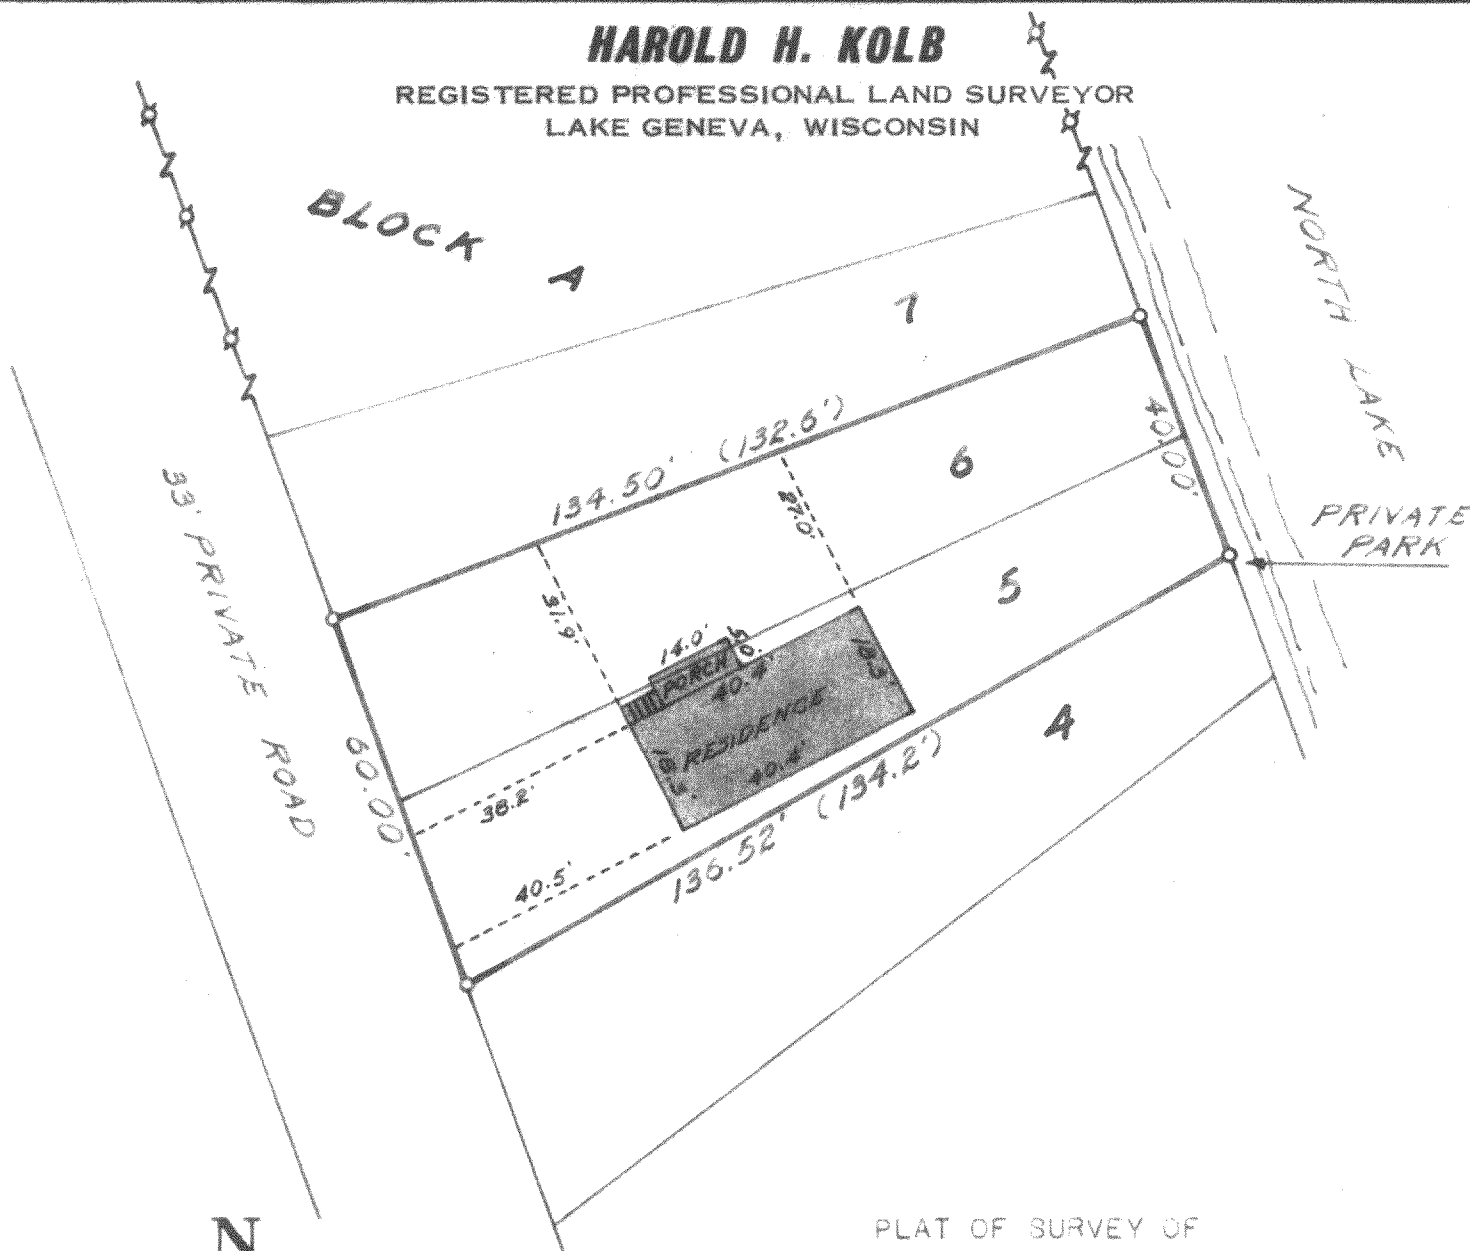

N



SCALE 1" = 30'

LEGEND

- X — IRON PIPE FOUND
- O — IRON PIPE PLACED
- — CONCRETE MONUMENT
- X — SPIKE
- () — RECORDED DISTANCE

PLAT OF SURVEY OF

Lots 5 and 6, Block A, North Lake Beach,
Tract 1, located in Section 5, T 3 N,
R 16 E, Walworth County, Wisconsin.

I, HAROLD H. KOLB, DO HEREBY CERTIFY THAT I HAVE
SURVEYED THE PROPERTY HEREON DESCRIBED ACCORDING
TO THE OFFICIAL RECORDS, AND THAT THE PLAT HEREON
IS A CORRECT REPRESENTATION OF THE LOT LINES.

Harold H. Kolb

HAROLD H. KOLB

WISCONSIN REGISTERED LAND SURVEYOR, S-187

DATE October 11, 1967