


HAROLD H. KOLB

REGISTERED PROFESSIONAL LAND SURVEYOR
LAKE GENEVA, WISCONSIN

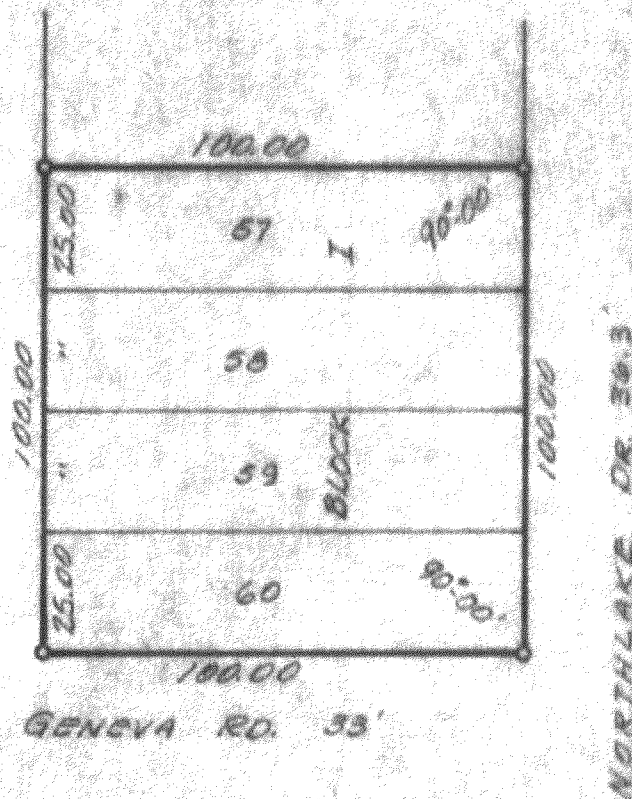

Plat of Survey of

Lots 57-60, Block 1, Tract 2,
North Lake Beach, a subdivision
located in Section 8, T 3 N,
R 16 E, Walworth County, Wis-
consin.



LEGEND

- I - IRON PIPE FOUND
- U - IRON PIPE PLACED
- - CONCRETE MONUMENT
- X - SPIKE

Scale - 1" = 40'

I, HAROLD H. KOLB, DO HEREBY CERTIFY THAT I HAVE
SURVEYED THE PROPERTY HEREON DESCRIBED ACCORDING
TO THE OFFICIAL RECORDS, AND THAT THE PLAT HEREON
IS A CORRECT REPRESENTATION OF THE LOT LINES.

Harold H. Kolb

HAROLD H. KOLB

WISCONSIN REGISTERED LAND SURVEYOR, S-187

DATE June 28, 1967

6-NLB2-171

316-63