
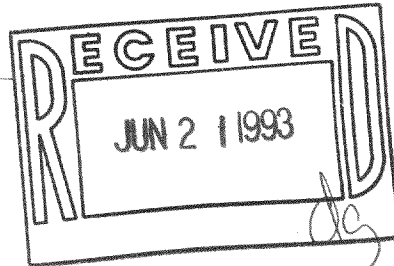


PLAT OF SURVEY

LOTS 14 THRU 20 INCLUSIVE AND LOTS 29 THRU 35 INCLUSIVE OF BLOCK 101 OF LAKE WANDAMEGA SUBDIVISION, TOWN 3 NORTH, RANGE 16 EAST, WALWORTH COUNTY, WISCONSIN.

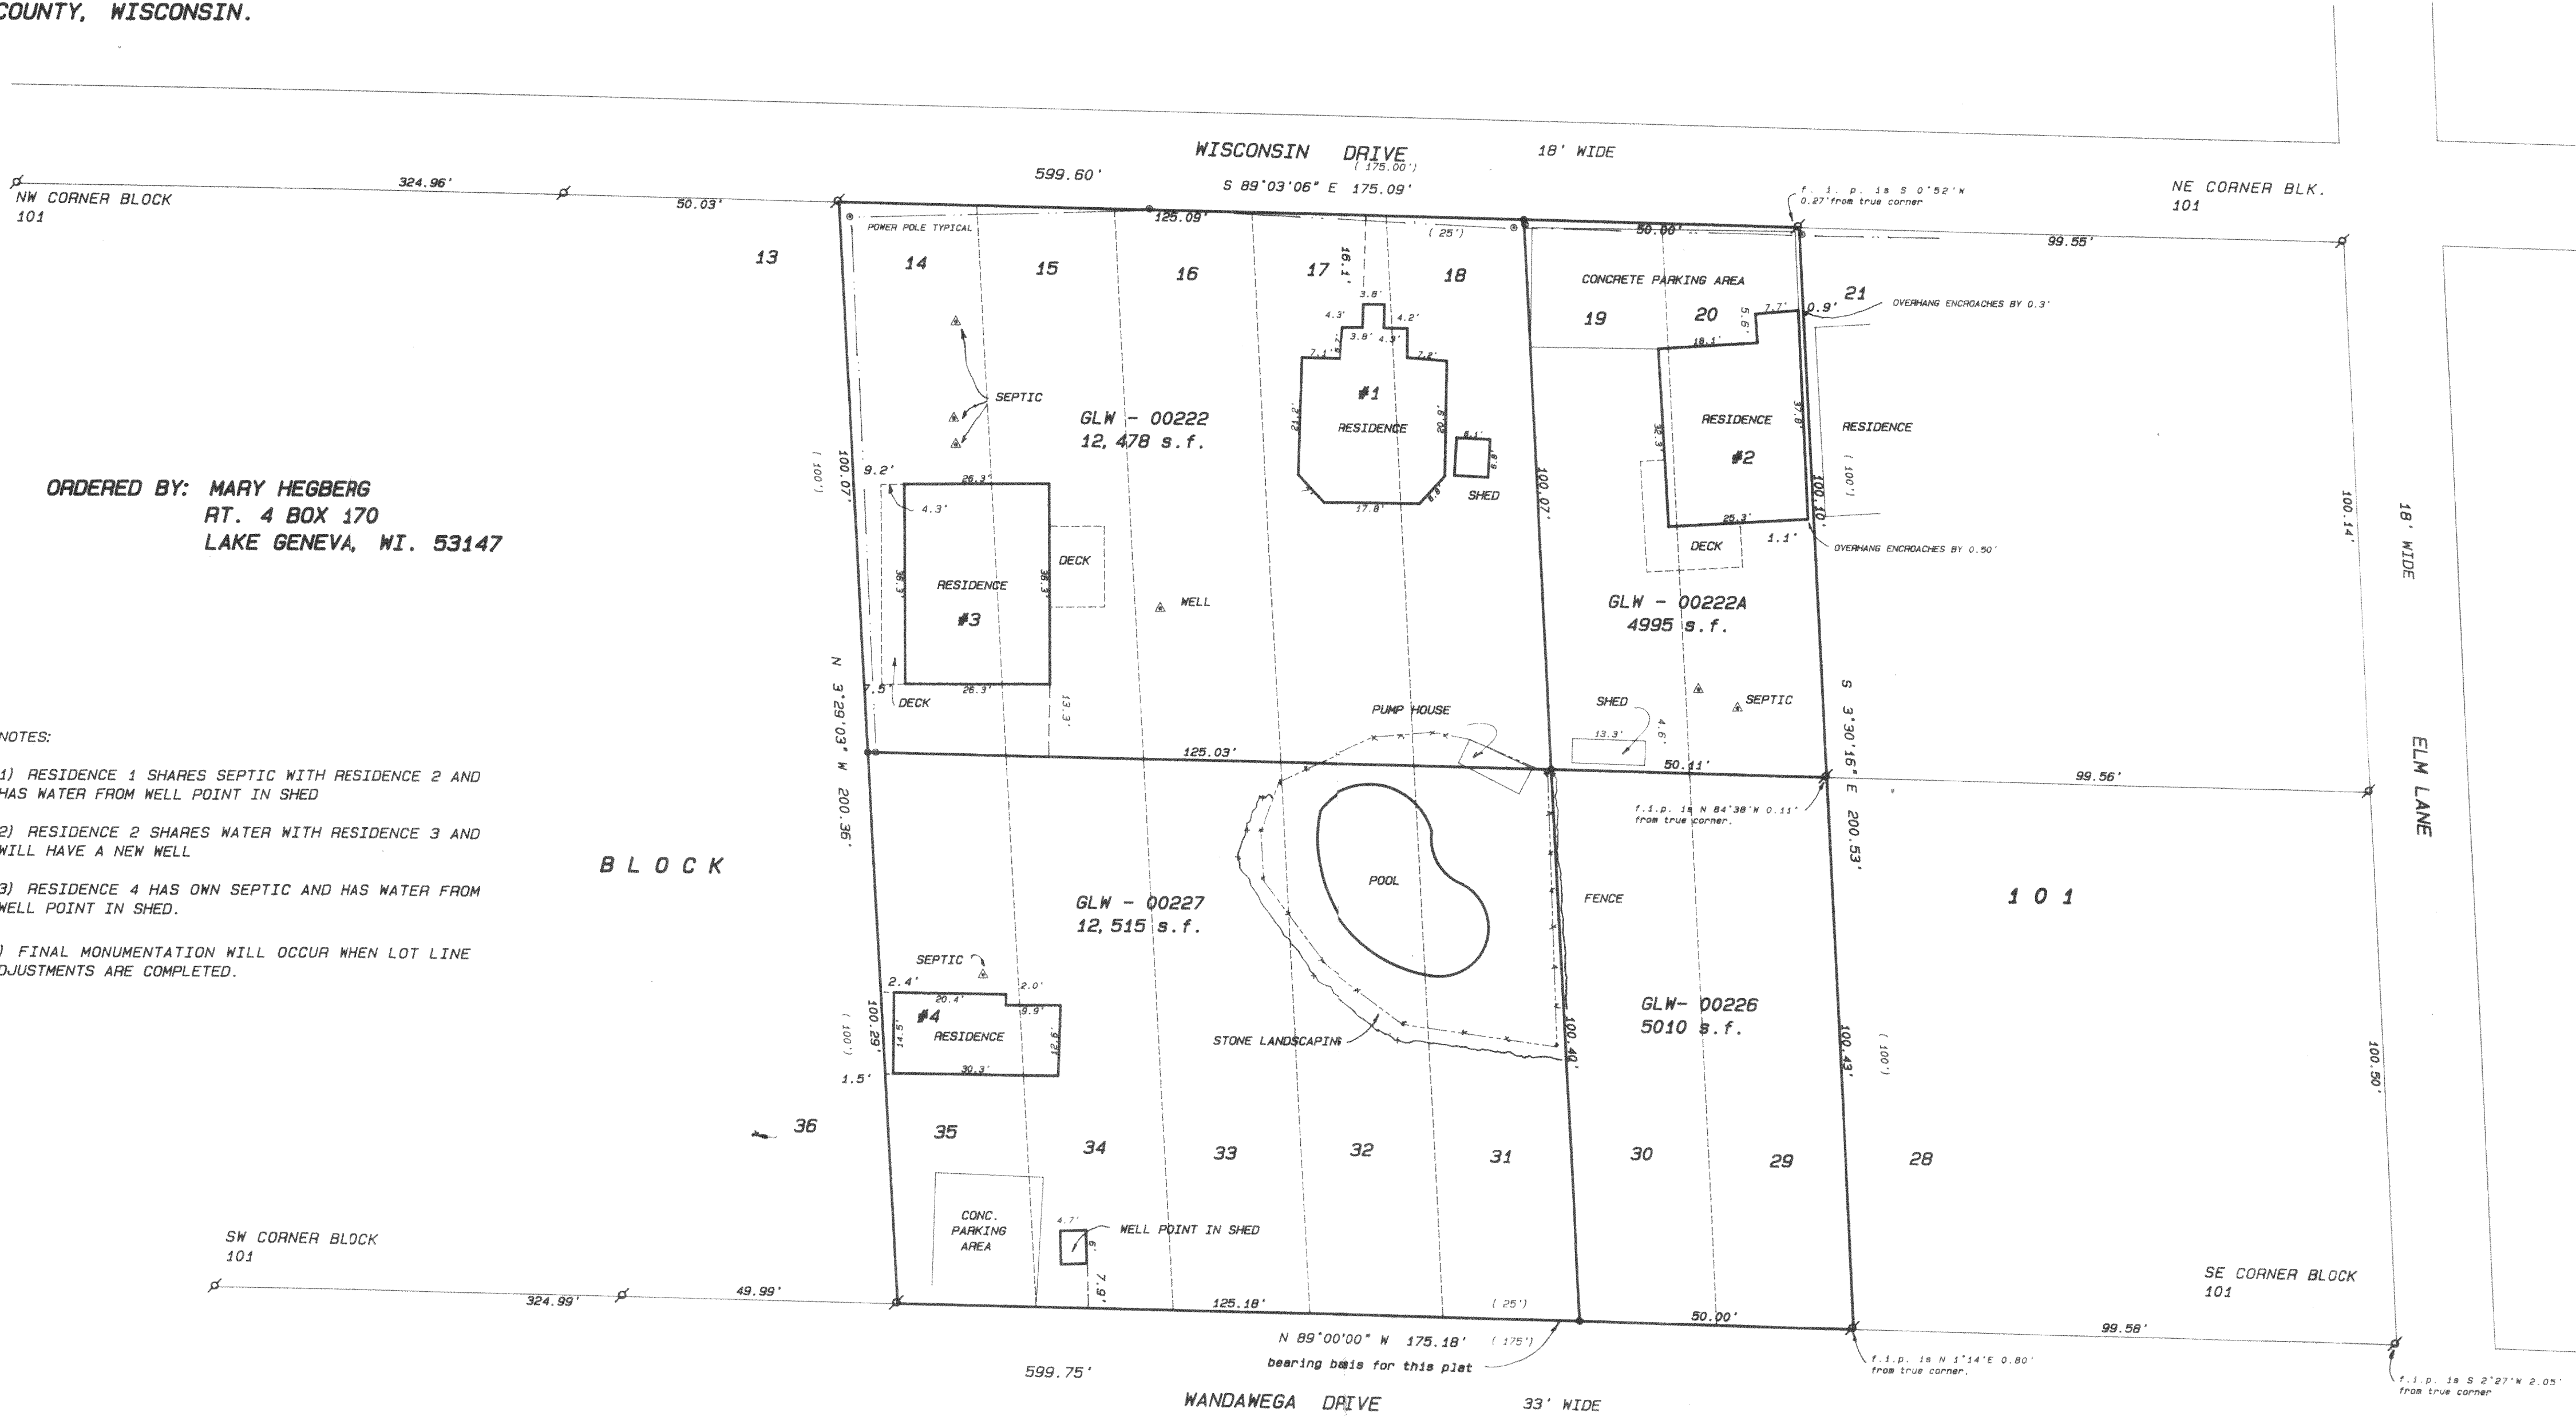


SCALE: 1" = 20 FEET

"I hereby certify that I have surveyed the above described property and that the above map is a true representation thereof and shows the size and location of the property, its exterior boundaries, the location of all visible structures and dimensions of all principal buildings thereon, boundary fences, apparent easements, roadways and visible encroachments, if any."

"This survey is made for the use of the present owners of the property, and also those who purchase, mortgage, or guarantee the title thereto within one year from date hereof."

Kenneth B. Abernathy Jr.
KENNETH B. ABERNATHY, JR.
WISCONSIN REGISTERED LAND SURVEYOR,
S-1594
Date: 5-20-93 Job No. 93,504

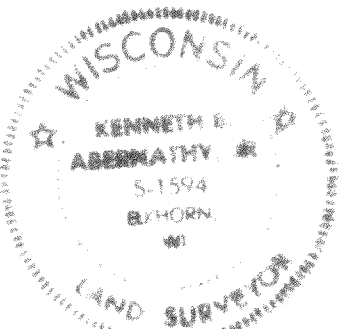

GLW - 222
GLW - 222A
GLW - 226
GLW - 227