


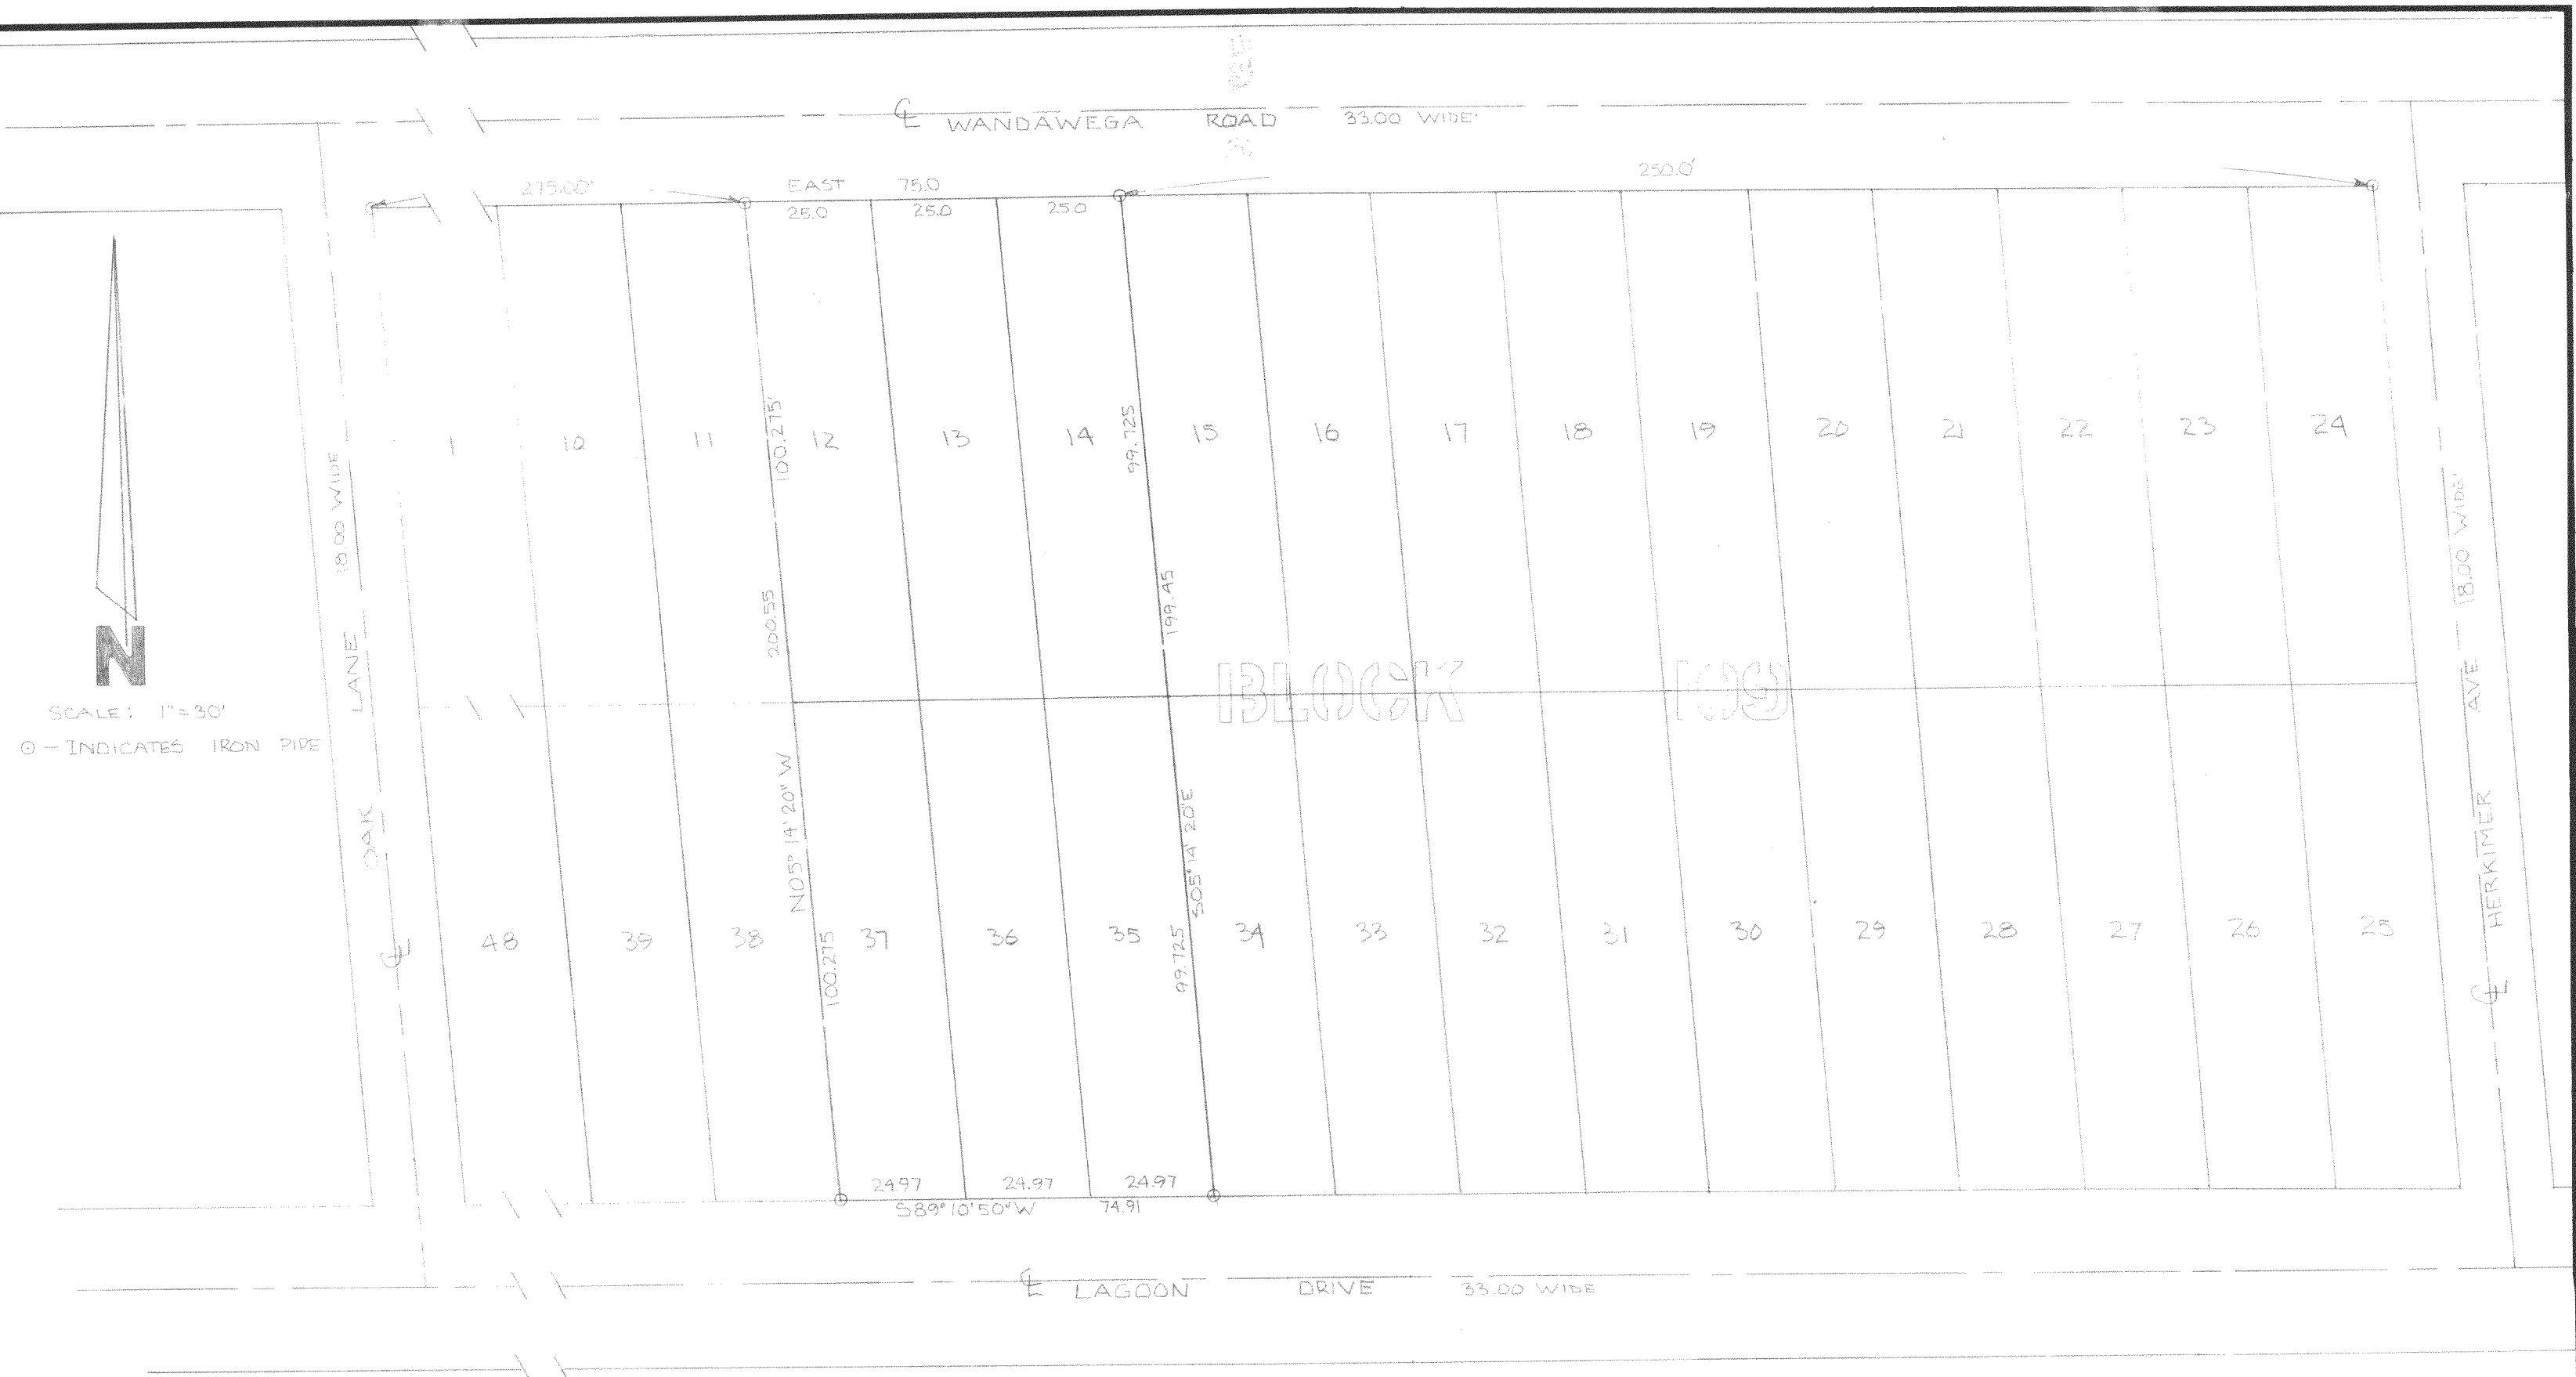


DESCRIPTION:

LOTS 12, 13, 14, 35, 36, AND 37 OF LAKE WANDAWEGA SUBDIVISION LOCATED IN SEC 1, TOWN 3 NORTH, RANGE 16 EAST WALWORTH COUNTY, WISCONSIN.

CERTIFICATE:

I JOSEPH M. BIAGI DO HEREBY CERTIFY THAT I HAVE SURVEYED THE PROPERTY HEREON DESCRIBED.

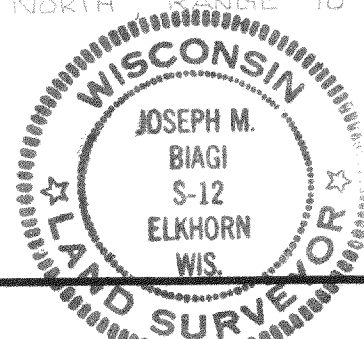

Joseph M. Biagi
JOSEPH M. BIAGI RLS 12 5/28/74
ELKHORN, WISC.

REVISIONS					
NO.	DATE	BY			
1					
2					
3			DRAWN BY JPR	SCALE 1"=30"	MATERIAL
4			CHK'D	DATE 5-28-74	DRAWING NO.
5			TRACED	APP'D	#30-74

GLW 311.320