


ABELL
SURVEYING & MAPPING
DELAVAN, WISCONSIN 53115
414-728-6737

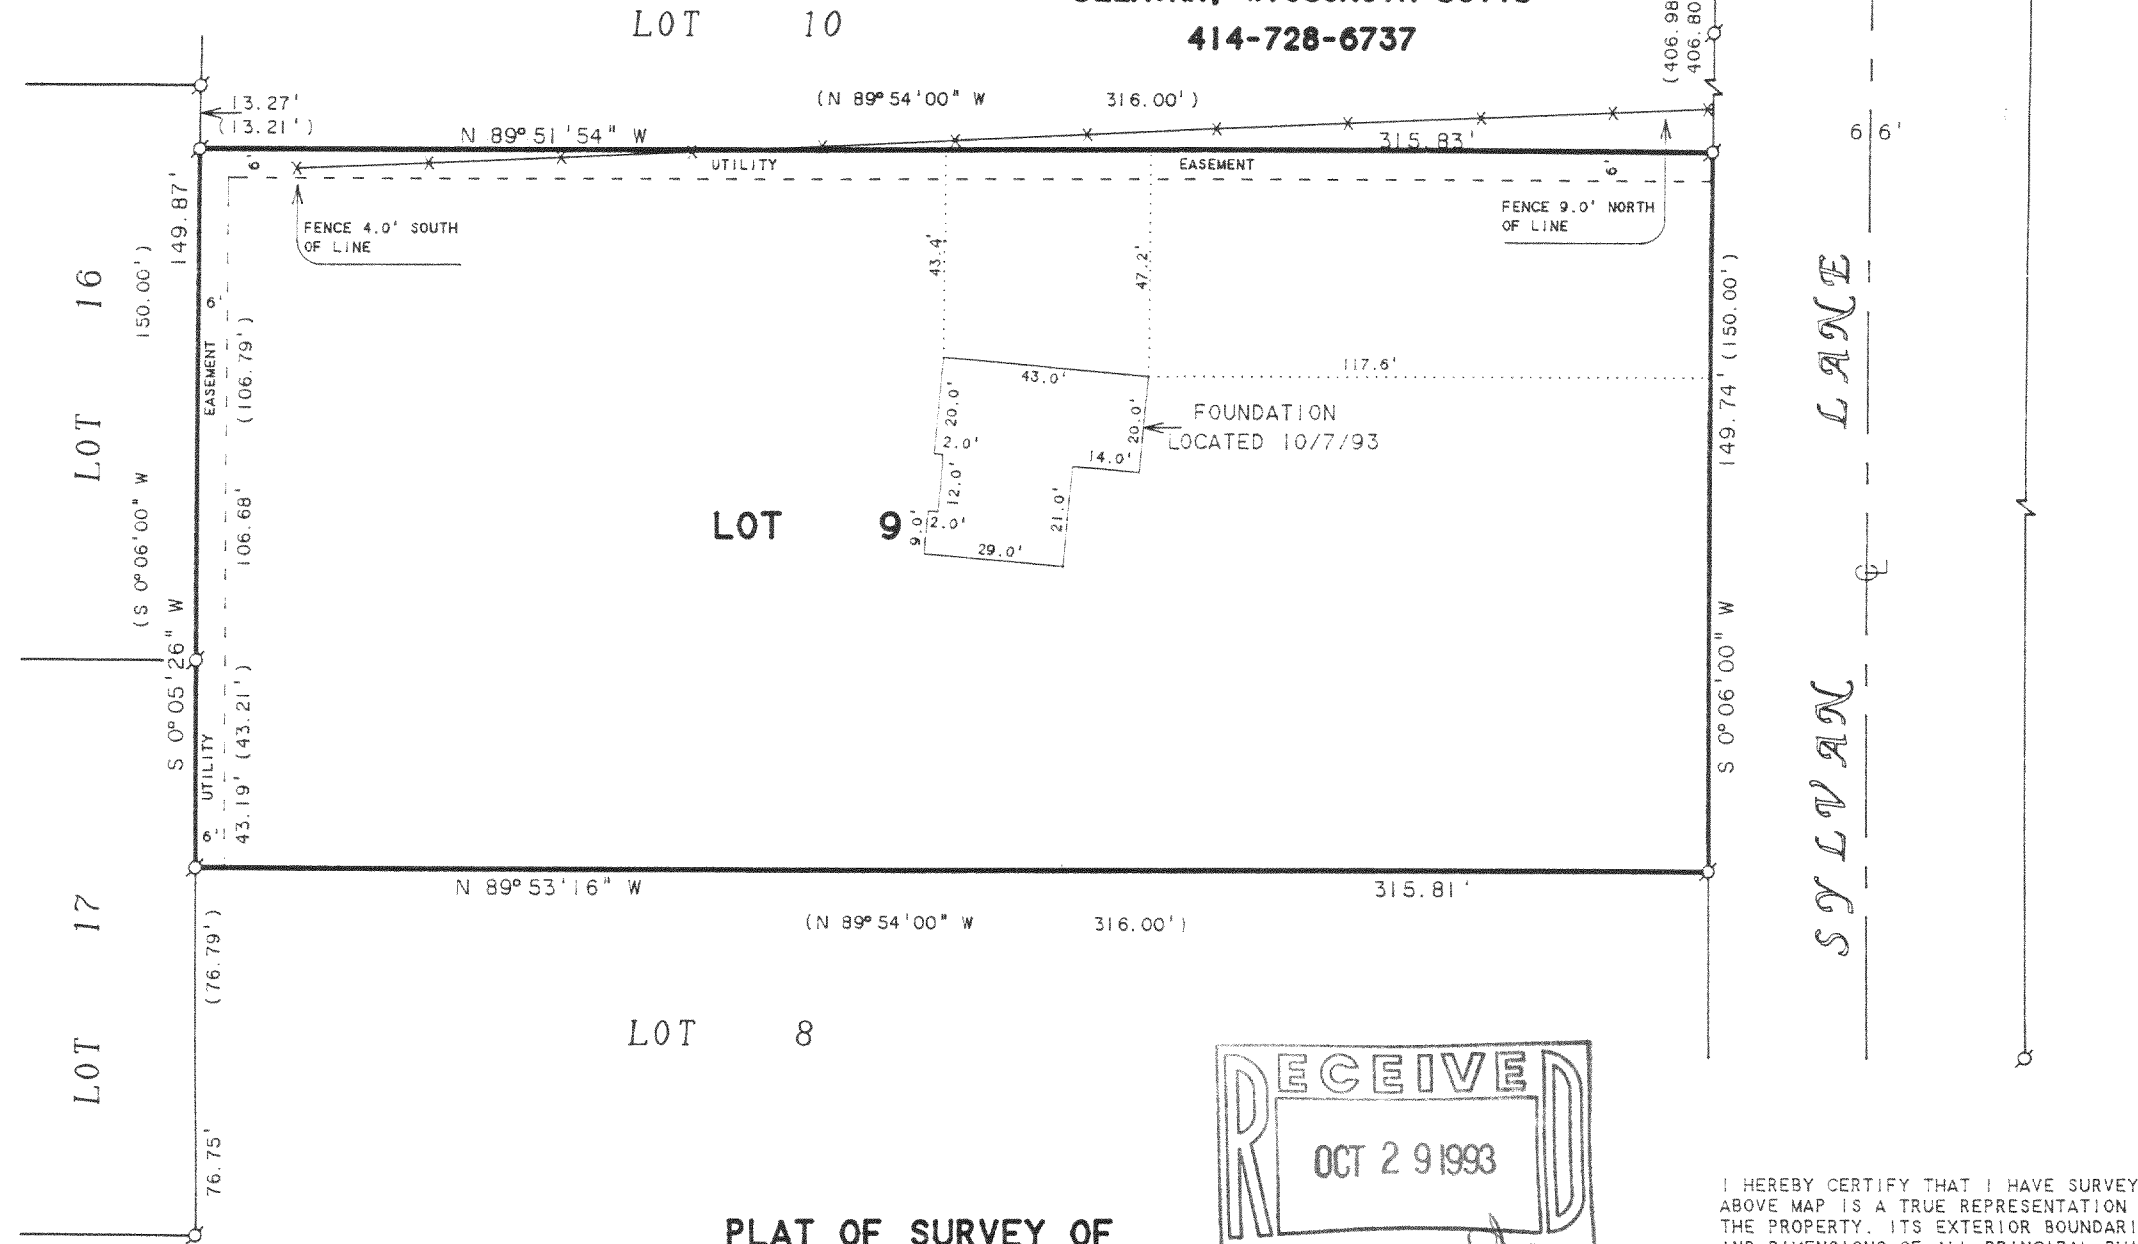


PLAT OF SURVEY OF

LOT 9, SYLVAN TRACE SUBDIVISION, LOCATED
IN T3N. R16E. WALWORTH COUNTY, WISCONSIN.

REVISED: JULY 28, 1993 TO SHOW THE PROPOSED LOCATION OF THE HOUSE

REVISED: OCTOBER 11, 1993 TO SHOW FOUNDATION LOCATION

ORDERED BY: DOUG GAHART
3615 S. BROWNS LAKE DR.
APT. 211
BURLINGTON, WI 53105

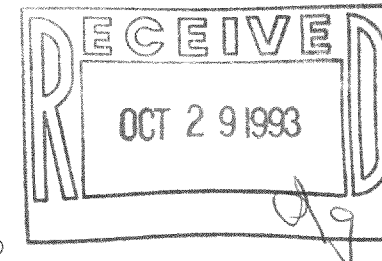

I HEREBY CERTIFY THAT I HAVE SURVEYED THE ABOVE DESCRIBED PROPERTY AND THAT THE ABOVE MAP IS A TRUE REPRESENTATION THEREOF AND SHOWS THE SIZE AND LOCATION OF THE PROPERTY, ITS EXTERIOR BOUNDARIES, THE LOCATION OF ALL VISIBLE STRUCTURES AND DIMENSIONS OF ALL PRINCIPAL BUILDINGS THEREON, BOUNDARY FENCES, APPARENT EASEMENTS, ROADWAYS AND VISIBLE ENCROACHMENTS, IF ANY, TO THE BEST OF MY KNOWLEDGE AND BELIEF.

THIS SURVEY IS MADE FOR THE USE OF THE PRESENT OWNERS OF THE PROPERTY, AND ALSO THOSE WHO PURCHASE, MORTGAGE, OR GUARANTEE THE TITLE THERETO WITHIN ONE (1) YEAR FROM DATE HEREON.

David F. Abell

DAVID F. ABELL
WISCONSIN REGISTERED LAND SURVEYOR, S-1596


April 22, 1992

DATE: April 22, 1992 JOB NUMBER - 92056
NOTE: THIS IS NOT A CERTIFIED COPY UNLESS SEALED.

6ST-9

316-667

ABELL
SURVEYING & MAPPING
DELAVER, WISCONSIN 53115
414-728-6737

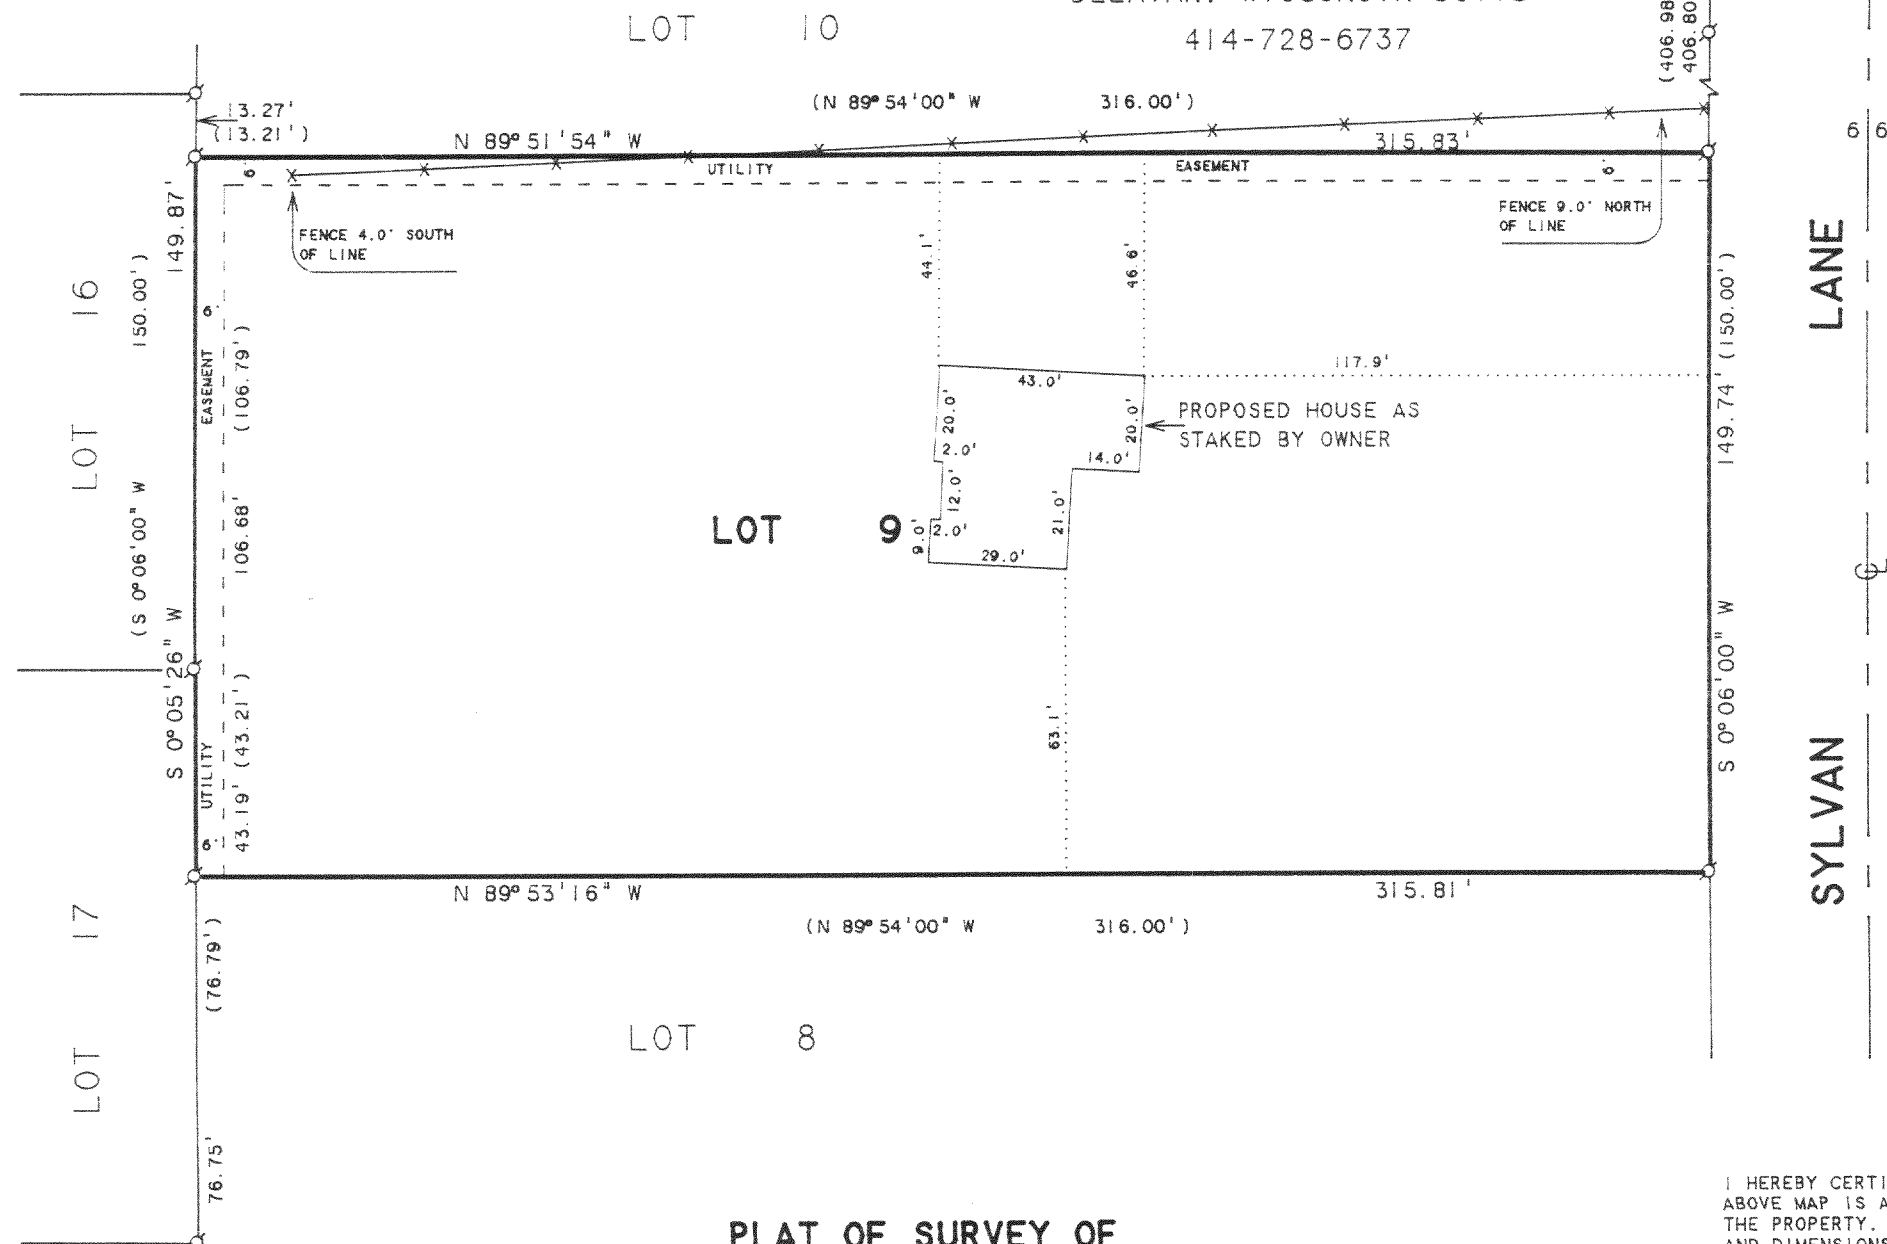


PLAT OF SURVEY OF

LOT 9, SYLVAN TRACE SUBDIVISION, LOCATED
IN T3N, R16E, WALWORTH COUNTY, WISCONSIN.

REVISED: JULY 28, 1993 TO SHOW THE PROPOSED LOCATION OF THE HOUSE

ORDERED BY: DOUG GAHART
3615 S. BROWNS LAKE DR.
APT. 211
BURLINGTON, WI 53105

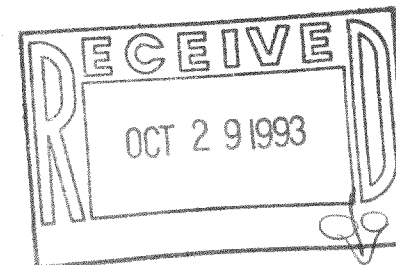

I HEREBY CERTIFY THAT I HAVE SURVEYED THE ABOVE DESCRIBED PROPERTY AND THAT THE ABOVE MAP IS A TRUE REPRESENTATION THEREOF AND SHOWS THE SIZE AND LOCATION OF THE PROPERTY, ITS EXTERIOR BOUNDARIES, THE LOCATION OF ALL VISIBLE STRUCTURES AND DIMENSIONS OF ALL PRINCIPAL BUILDINGS THEREON, BOUNDARY FENCES, APPARENT EASEMENTS, ROADWAYS AND VISIBLE ENCROACHMENTS, IF ANY, TO THE BEST OF MY KNOWLEDGE AND BELIEF.


THIS SURVEY IS MADE FOR THE USE OF THE PRESENT OWNERS OF THE PROPERTY, AND ALSO THOSE WHO PURCHASE, MORTGAGE, OR GUARANTEE THE TITLE THERETO WITHIN ONE (1) YEAR FROM DATE HEREON.

David F. Abell

DAVID F. ABELL
WISCONSIN REGISTERED LAND SURVEYOR, S-1596

April 22, 1992

DATE: April 22, 1992 JOB NUMBER - 92056
NOTE: THIS IS NOT A CERTIFIED COPY UNLESS SEALED.

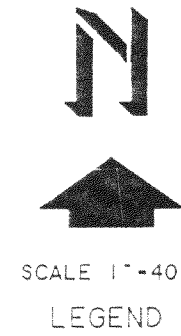

○ - IRON PIPE FOUND
* - WIRE FENCE
() - RECORDED AS

NOTE: BEARINGS ARE REFERENCED TO THE
RECORDED SUBDIVISION PLAT.

ORDERED BY: COLONY REALTY
16 E. WALWORTH ST.
ELKHORN, WI. 53121