


**ABELL
SURVEYING & MAPPING
DELAVAN, WISCONSIN 53115
414-728-6737**



NOTE: BEARINGS ARE REFERENCED TO
CERTIFIED SURVEY MAP NO. 572.


N

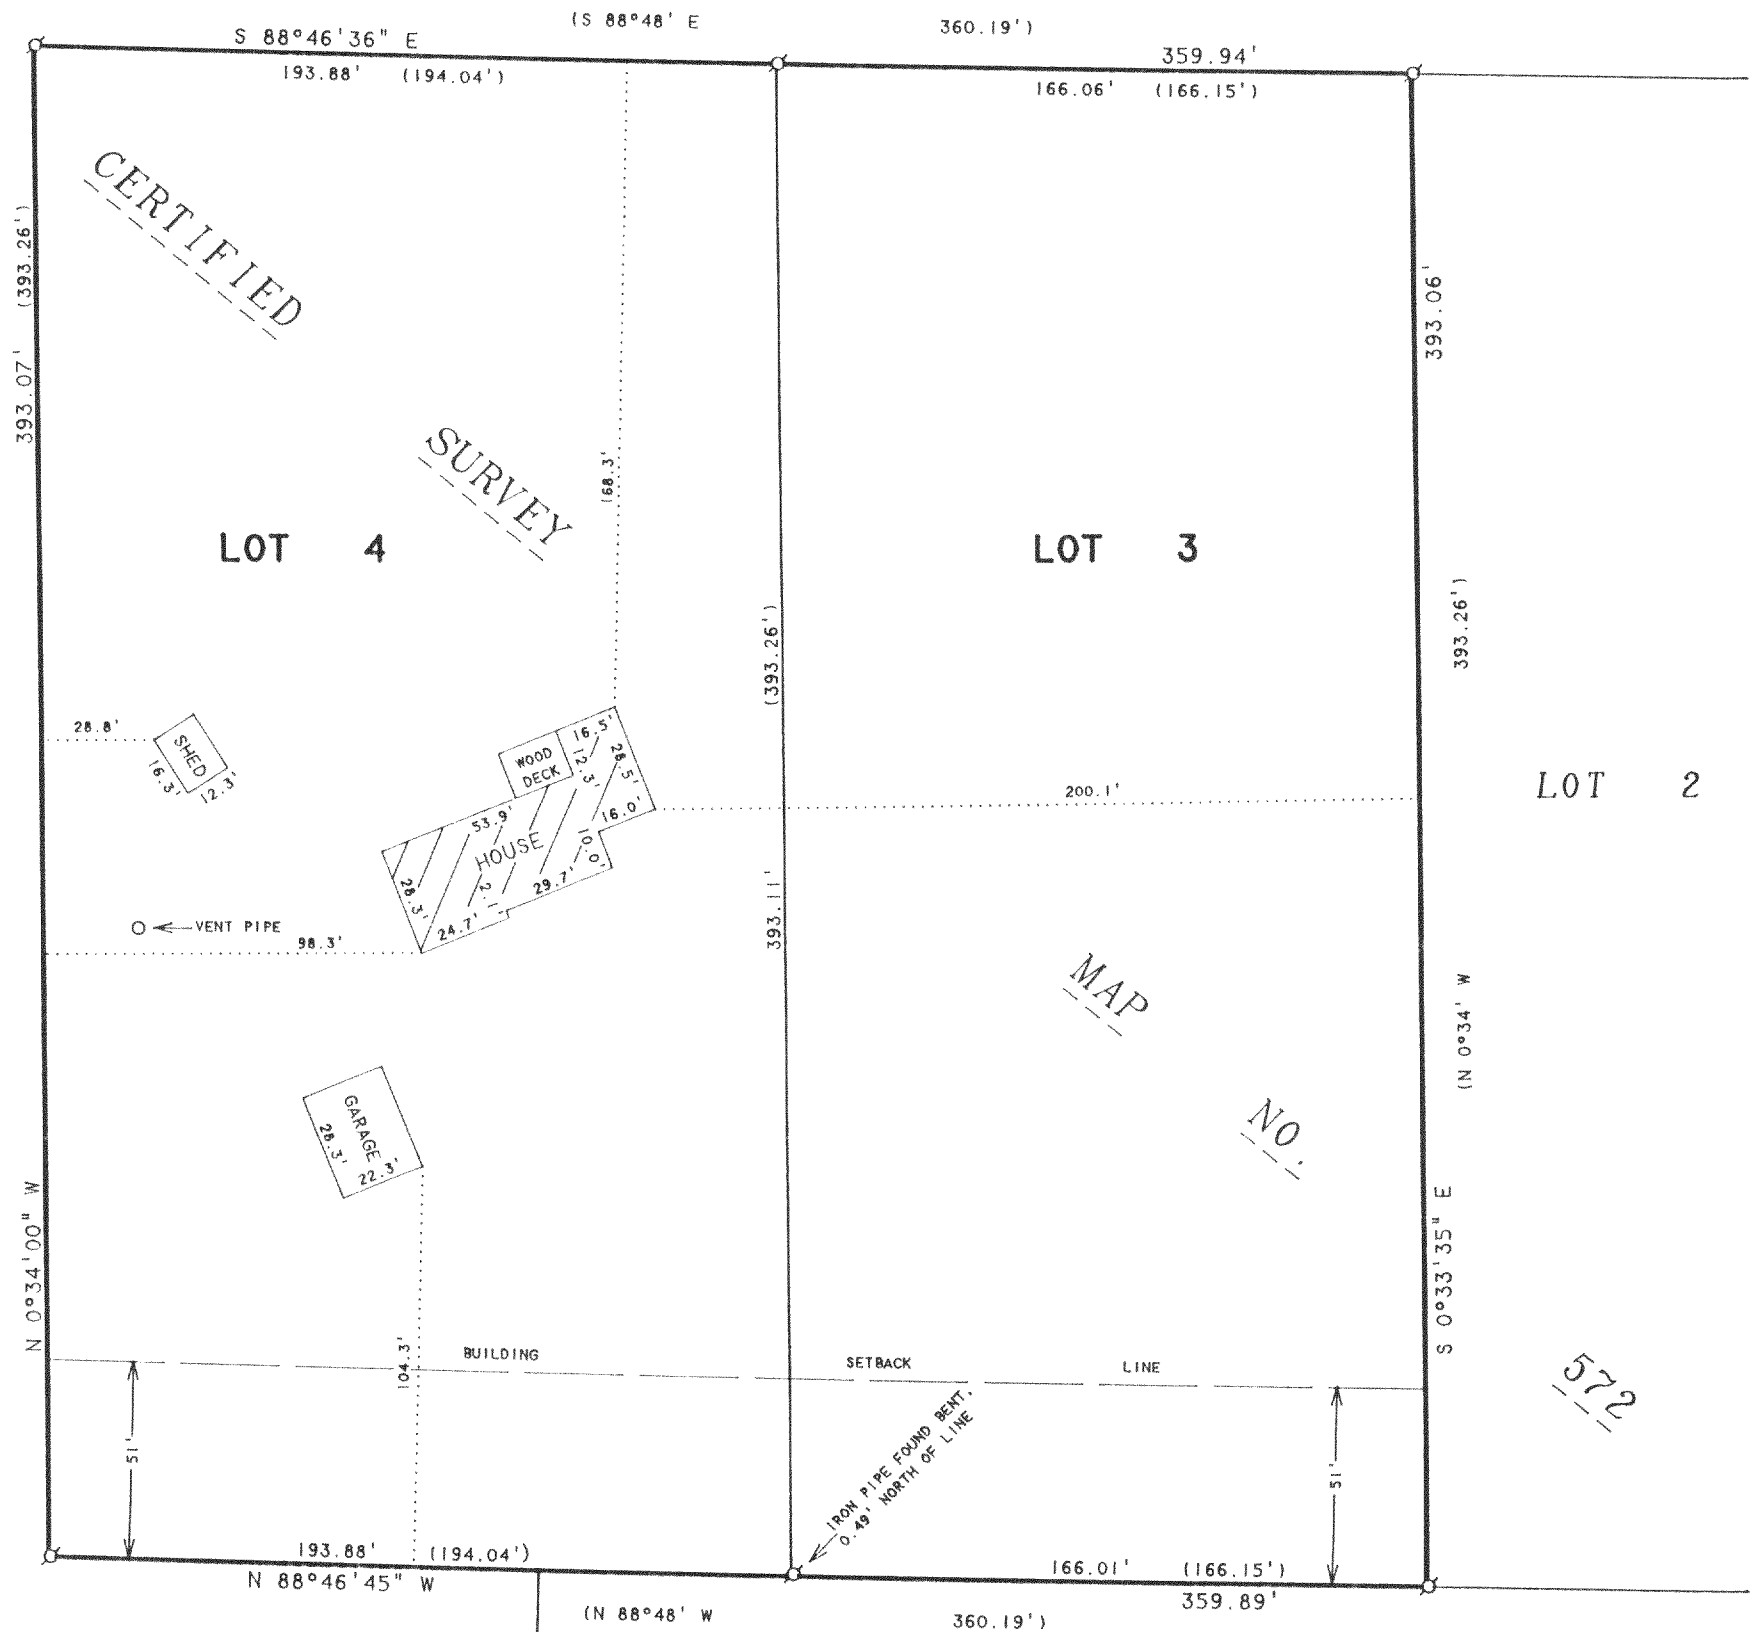

SCALE 1"=50'

LEGEND

⊙ - IRON PIPE FOUND
() - RECORDED AS

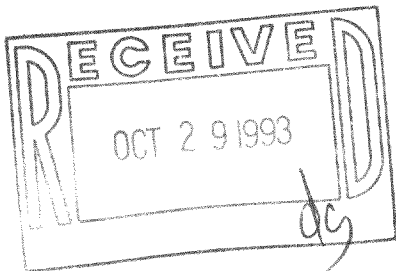

PLAT OF SURVEY OF

LOTS 3 AND 4, CERTIFIED SURVEY MAP NO. 572,
LOCATED IN THE NORTHEAST 1/4 OF SECTION 2,
T3N, R16E, WALWORTH COUNTY, WISCONSIN.

ORDERED BY: TIM BRELLENTHIN
RT. 5
ELKHORN, WI 53121

I, DAVID F. ABELL, DO HEREBY CERTIFY THAT I HAVE SURVEYED THE PROPERTY HEREON
DESCRIBED ACCORDING TO THE OFFICAL RECORDS AND THAT THE PLAT HEREON IS A
CORRECT REPRESENTATION OF THE PROPERTY LINES TO THE BEST OF MY KNOWLEDGE AND
BELIEF.

David F. Abell

DAVID F. ABELL
WISCONSIN REGISTERED LAND SURVEYOR, S-1596

August 19, 1993

DATE: August 19, 1993 JOB NUMBER - 93161
NOTE: THIS IS NOT A CERTIFIED COPY UNLESS SEALED.

GA-572-3
GA-572-4

316-668