

KENNEL ROAD

N 0°00'17" E
100.01


S 89°17'30" E
272.30

○ = IRON SURVEY STAKE UNDISTURBED
AS SHOWN ON CSM 2314



CSM 1874

N 0°01'52" E
623.06

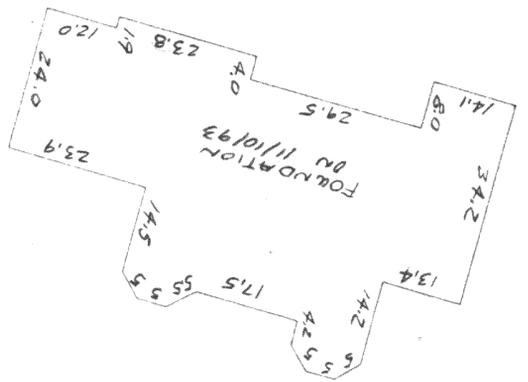

DETAIL OF RESIDENCE FOUNDATION ON 11/10/93
SCALE 1"=20'

N 89°17'30" W
1042.27

341.7



248.4'


321.3'

SCALE 1"=60'
LOCATION OF RESIDENCE ON LOT

436.8

S 0°01'52" W
724.53

UNPLATTED LANDS

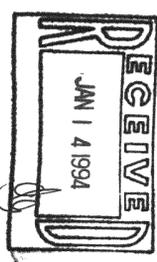


SUGAR CREEK ROAD

S 89°24'00" E
770.00

UNPLATTED LANDS

LOCATION OF NEW RESIDENCE FOUNDATION ON LOT 1 CSM 2314 IN NE 1/4 NW 1/4 SEC 27-3-16 WALWORTH CO., WI.

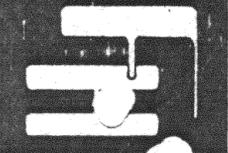

FARRIS, HANSEN & ASSOCIATES, INC.
Engineering, Architecture, Surveying
7 Ridgway Court P.O. Box 437
ELKHORN, WISCONSIN 53121
Office: (414) 723-2098
Fax: (414) 723-5886


REVISIONS

PROJECT NO 3861, RES
DATE 11/10/93
SHEET NO 1 of 1

I HEREBY CERTIFY THIS MAP TO BE A TRUE REPRESENTATION OF THE LOCATION OF A NEW FOUNDATION FOR A RESIDENCE UNDER CONSTRUCTION ON THIS PARCEL MEASURED 11/10/93

WORK ORDERED BY: CLARENCE THELEN

Robert A. Farris

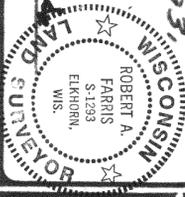

GA-2314-1

316-679