

Plat of Survey

of

Tax Parcel No: GLW 00342


Lots Fourteen (14), Fifteen (15) and Sixteen (16), in Block One Hundred Sixteen (116) in Lake Mandawega Subdivision, according to the recorded plat thereof.

Surveyed for: Daniel Murphy

N 6924 OAK LANE
ELKHORN, WI. 53121

Also Commencing at the Southwest corner of Lot 31, Block 116, Lake Mandawega Subdivision, thence West to the East line of Sugar Creek Lane and the place of beginning; run thence East to the Southwest corner of Lot 31, Block 116, Lake Mandawega Subdivision; thence North to the Southeast corner of Lot 16, Block 116, thence West to the East line of Sugar Creek Lane, thence South to the place of beginning, formerly described as Lots 17 and 18, Block 116, Lake Mandawega Subdivision.

Bearings are assumed.

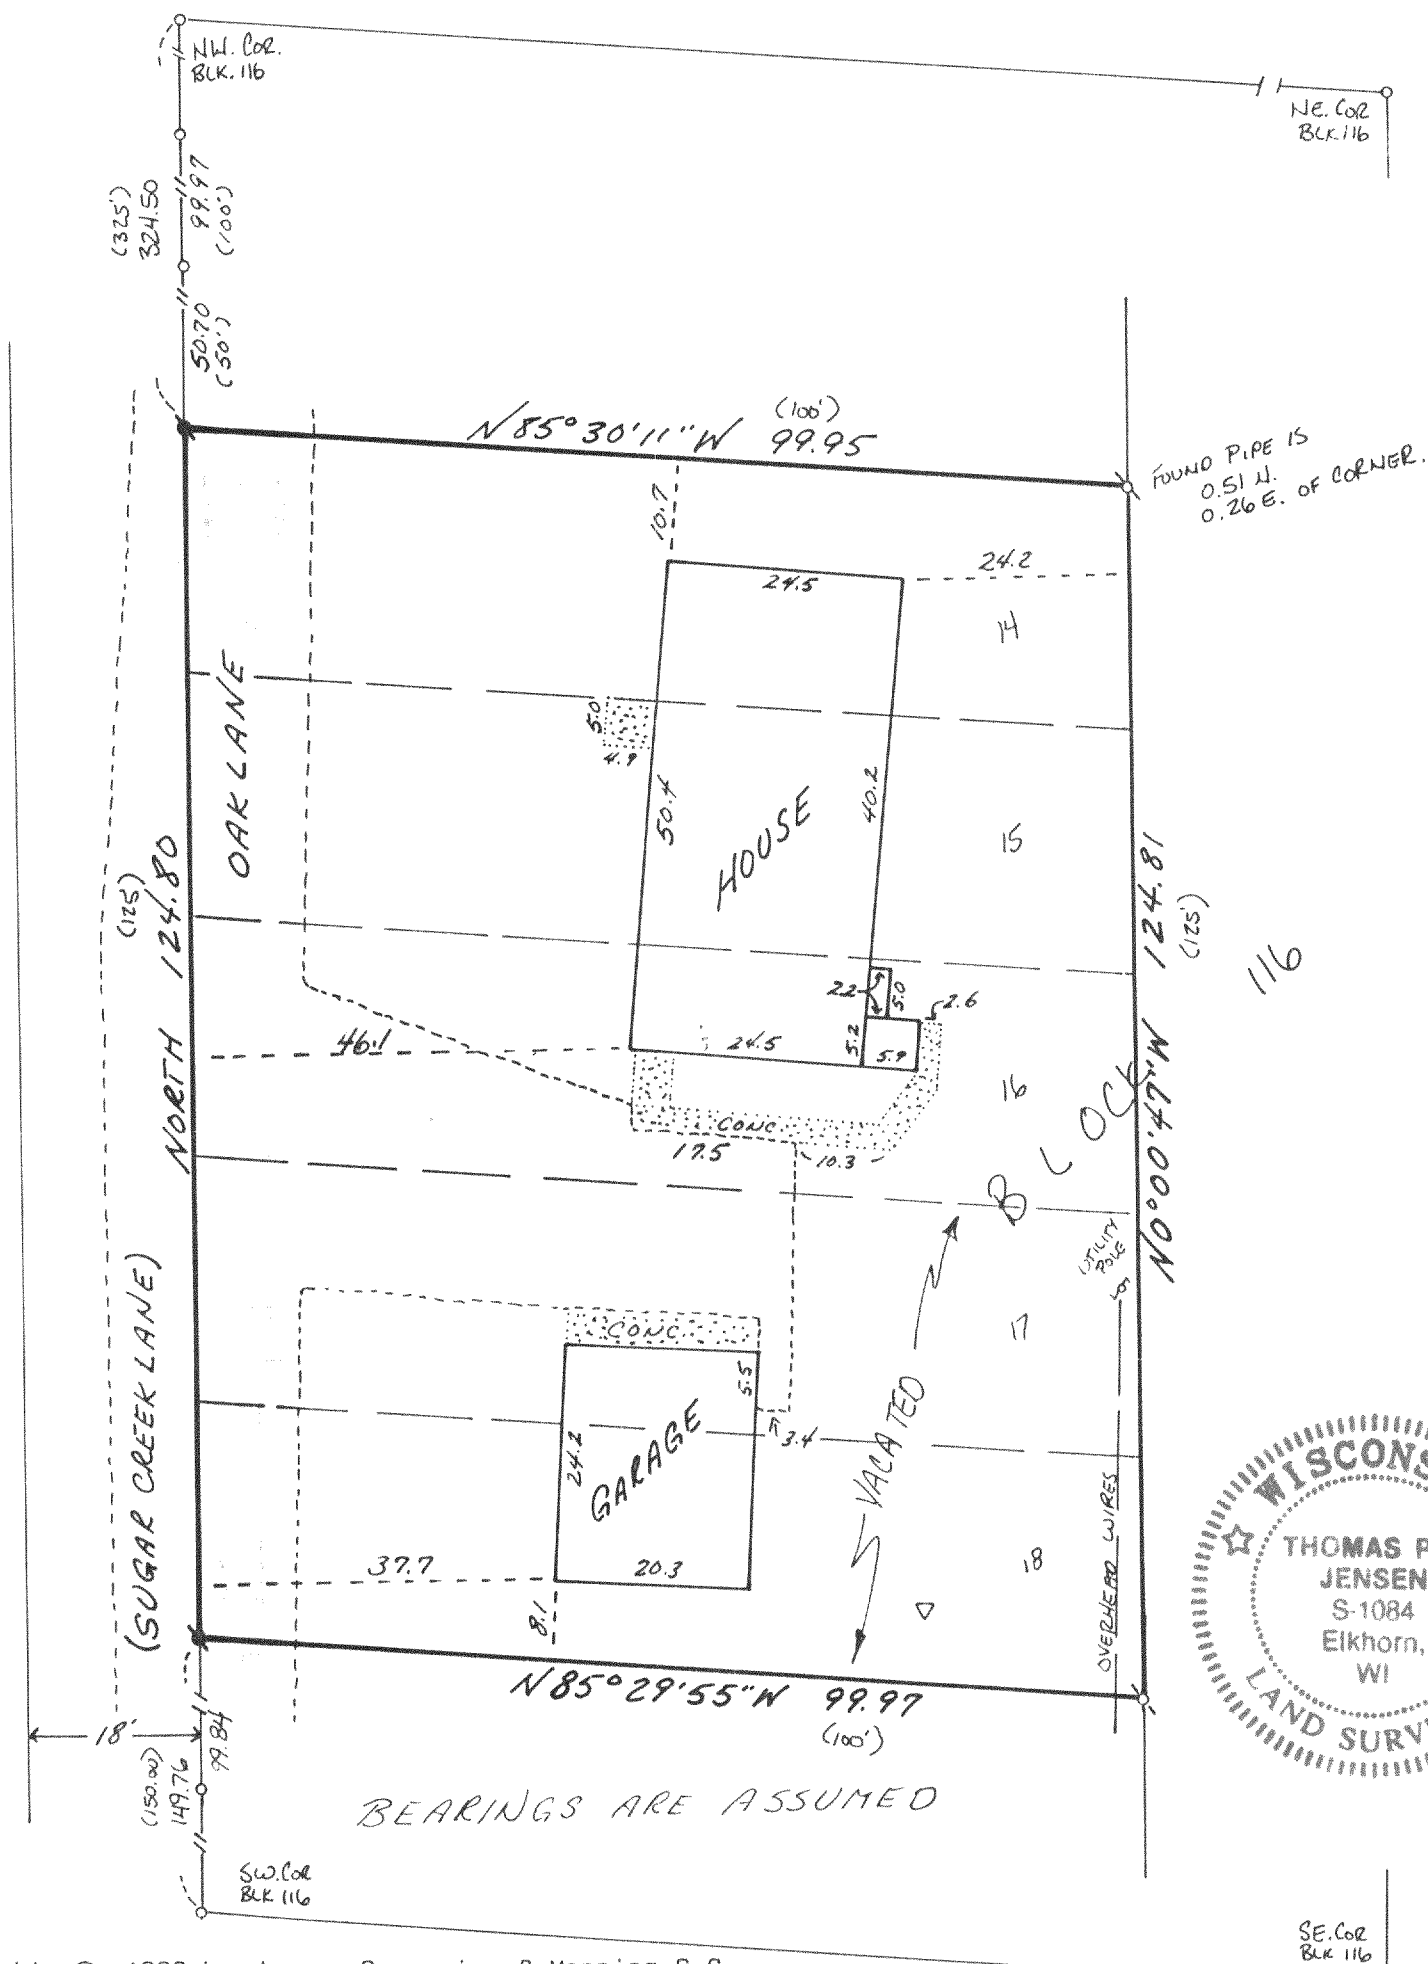


Copyright © 1993 by Jensen Surveying & Mapping S.C.

All rights reserved. No part of this survey plat may be reproduced or transmitted in any form by any means - graphic, electronic, or mechanical, including photocopying, tracing, or information storage and retrieval systems - without permission in writing from Thomas P.A. Jensen.

I, Thomas P.A. Jensen, Wisconsin Registered Land Surveyor, do hereby certify that this survey was performed by me, or under my direction, in full compliance with the owner's/agent's instructions and Chapter A-E 7 of the Wisconsin Administrative Code 'Minimum Standards For Property Surveys', and that this map is an accurate representation thereof to the best of my knowledge and belief.

Note: This survey plat is not certified unless signed and sealed in red ink.

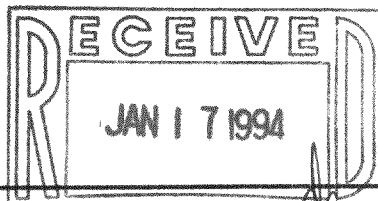

Thomas P.A. Jensen R.L.S. 1084

Legend

- Found iron pipe
- Found iron rod
- △ Set iron rod 3/4 dia.
- ▲ Set R.R. spike
- () Recorded as dimension
- △ Septic vent
- Blacktop surface

Jensen Surveying & Mapping S.C.

45 South Wisconsin Street P.O. Box 322
Elkhorn, Wisconsin. 53121.
(414) 723-3434

Mapping date: DECEMBER 8, 1993.

Revisions: _____

Sheet 1 of 1 Sheets

Job reference number: 316-681
1993.120

Scale: 1" = 20'



GLW-342