


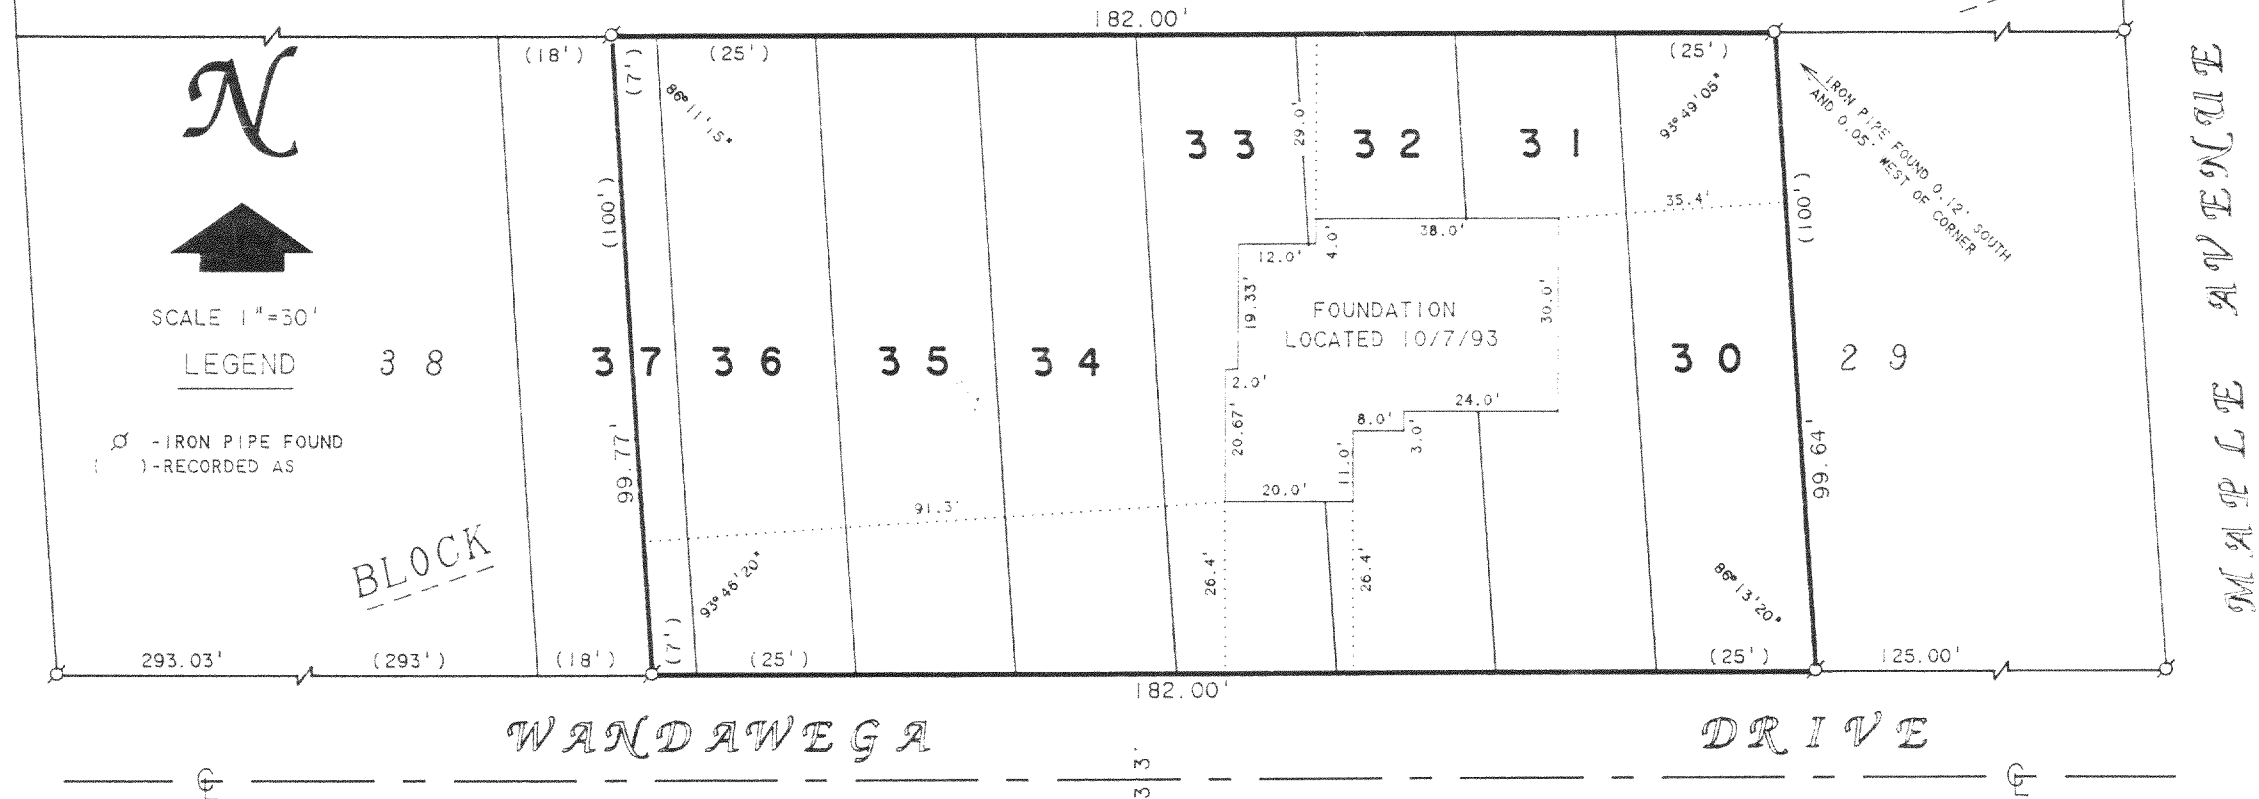


ORDERED BY: NEUMANN HOMES  
4450 MILTON AVE.  
SUITE 206  
JANESVILLE, WI 53546

### PLAT OF SURVEY OF

LOTS 30 - 36 AND LOT 37 EXCEPT THE WEST 18 FEET THEREOF, BLOCK 99 OF LAKE WANDAWEGA SUBDIVISION, LOCATED IN T3N. R16E. WALWORTH COUNTY, WISCONSIN.

**ABELL**  
**SURVEYING & MAPPING**  
DELAVAN, WISCONSIN 53115  
414-728-6737

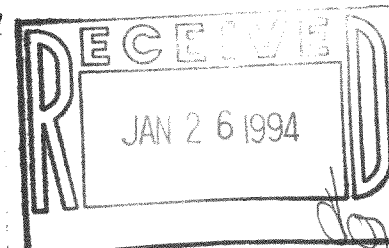

I HEREBY CERTIFY THAT I HAVE SURVEYED THE ABOVE DESCRIBED PROPERTY AND THAT THE ABOVE MAP IS A TRUE REPRESENTATION THEREOF AND SHOWS THE SIZE AND LOCATION OF THE PROPERTY, ITS EXTERIOR BOUNDARIES, THE LOCATION OF ALL VISIBLE STRUCTURES AND DIMENSIONS OF ALL PRINCIPAL BUILDINGS THEREON, BOUNDARY FENCES, APPARENT EASEMENTS, ROADWAYS AND VISIBLE ENCROACHMENTS, IF ANY, TO THE BEST OF MY KNOWLEDGE AND BELIEF.

THIS SURVEY IS MADE FOR THE USE OF THE PRESENT OWNERS OF THE PROPERTY, AND ALSO THOSE WHO PURCHASE, MORTGAGE, OR GUARANTEE THE TITLE THERETO WITHIN ONE (1) YEAR FROM DATE HEREON.

*David F. Abell*

DAVID F. ABELL  
WISCONSIN REGISTERED LAND SURVEYOR, S-1596

REVISED DATE OCTOBER 11, 1993

JUNE 24, 1992

REVISED DATE AUGUST 25, 1993

DATE

JOB NUMBER - 92136

NOTE: THIS IS NOT A CERTIFIED COPY UNLESS SEALED.

GLW-197  
GLW-198

316-688