



PLAT OF SURVEY

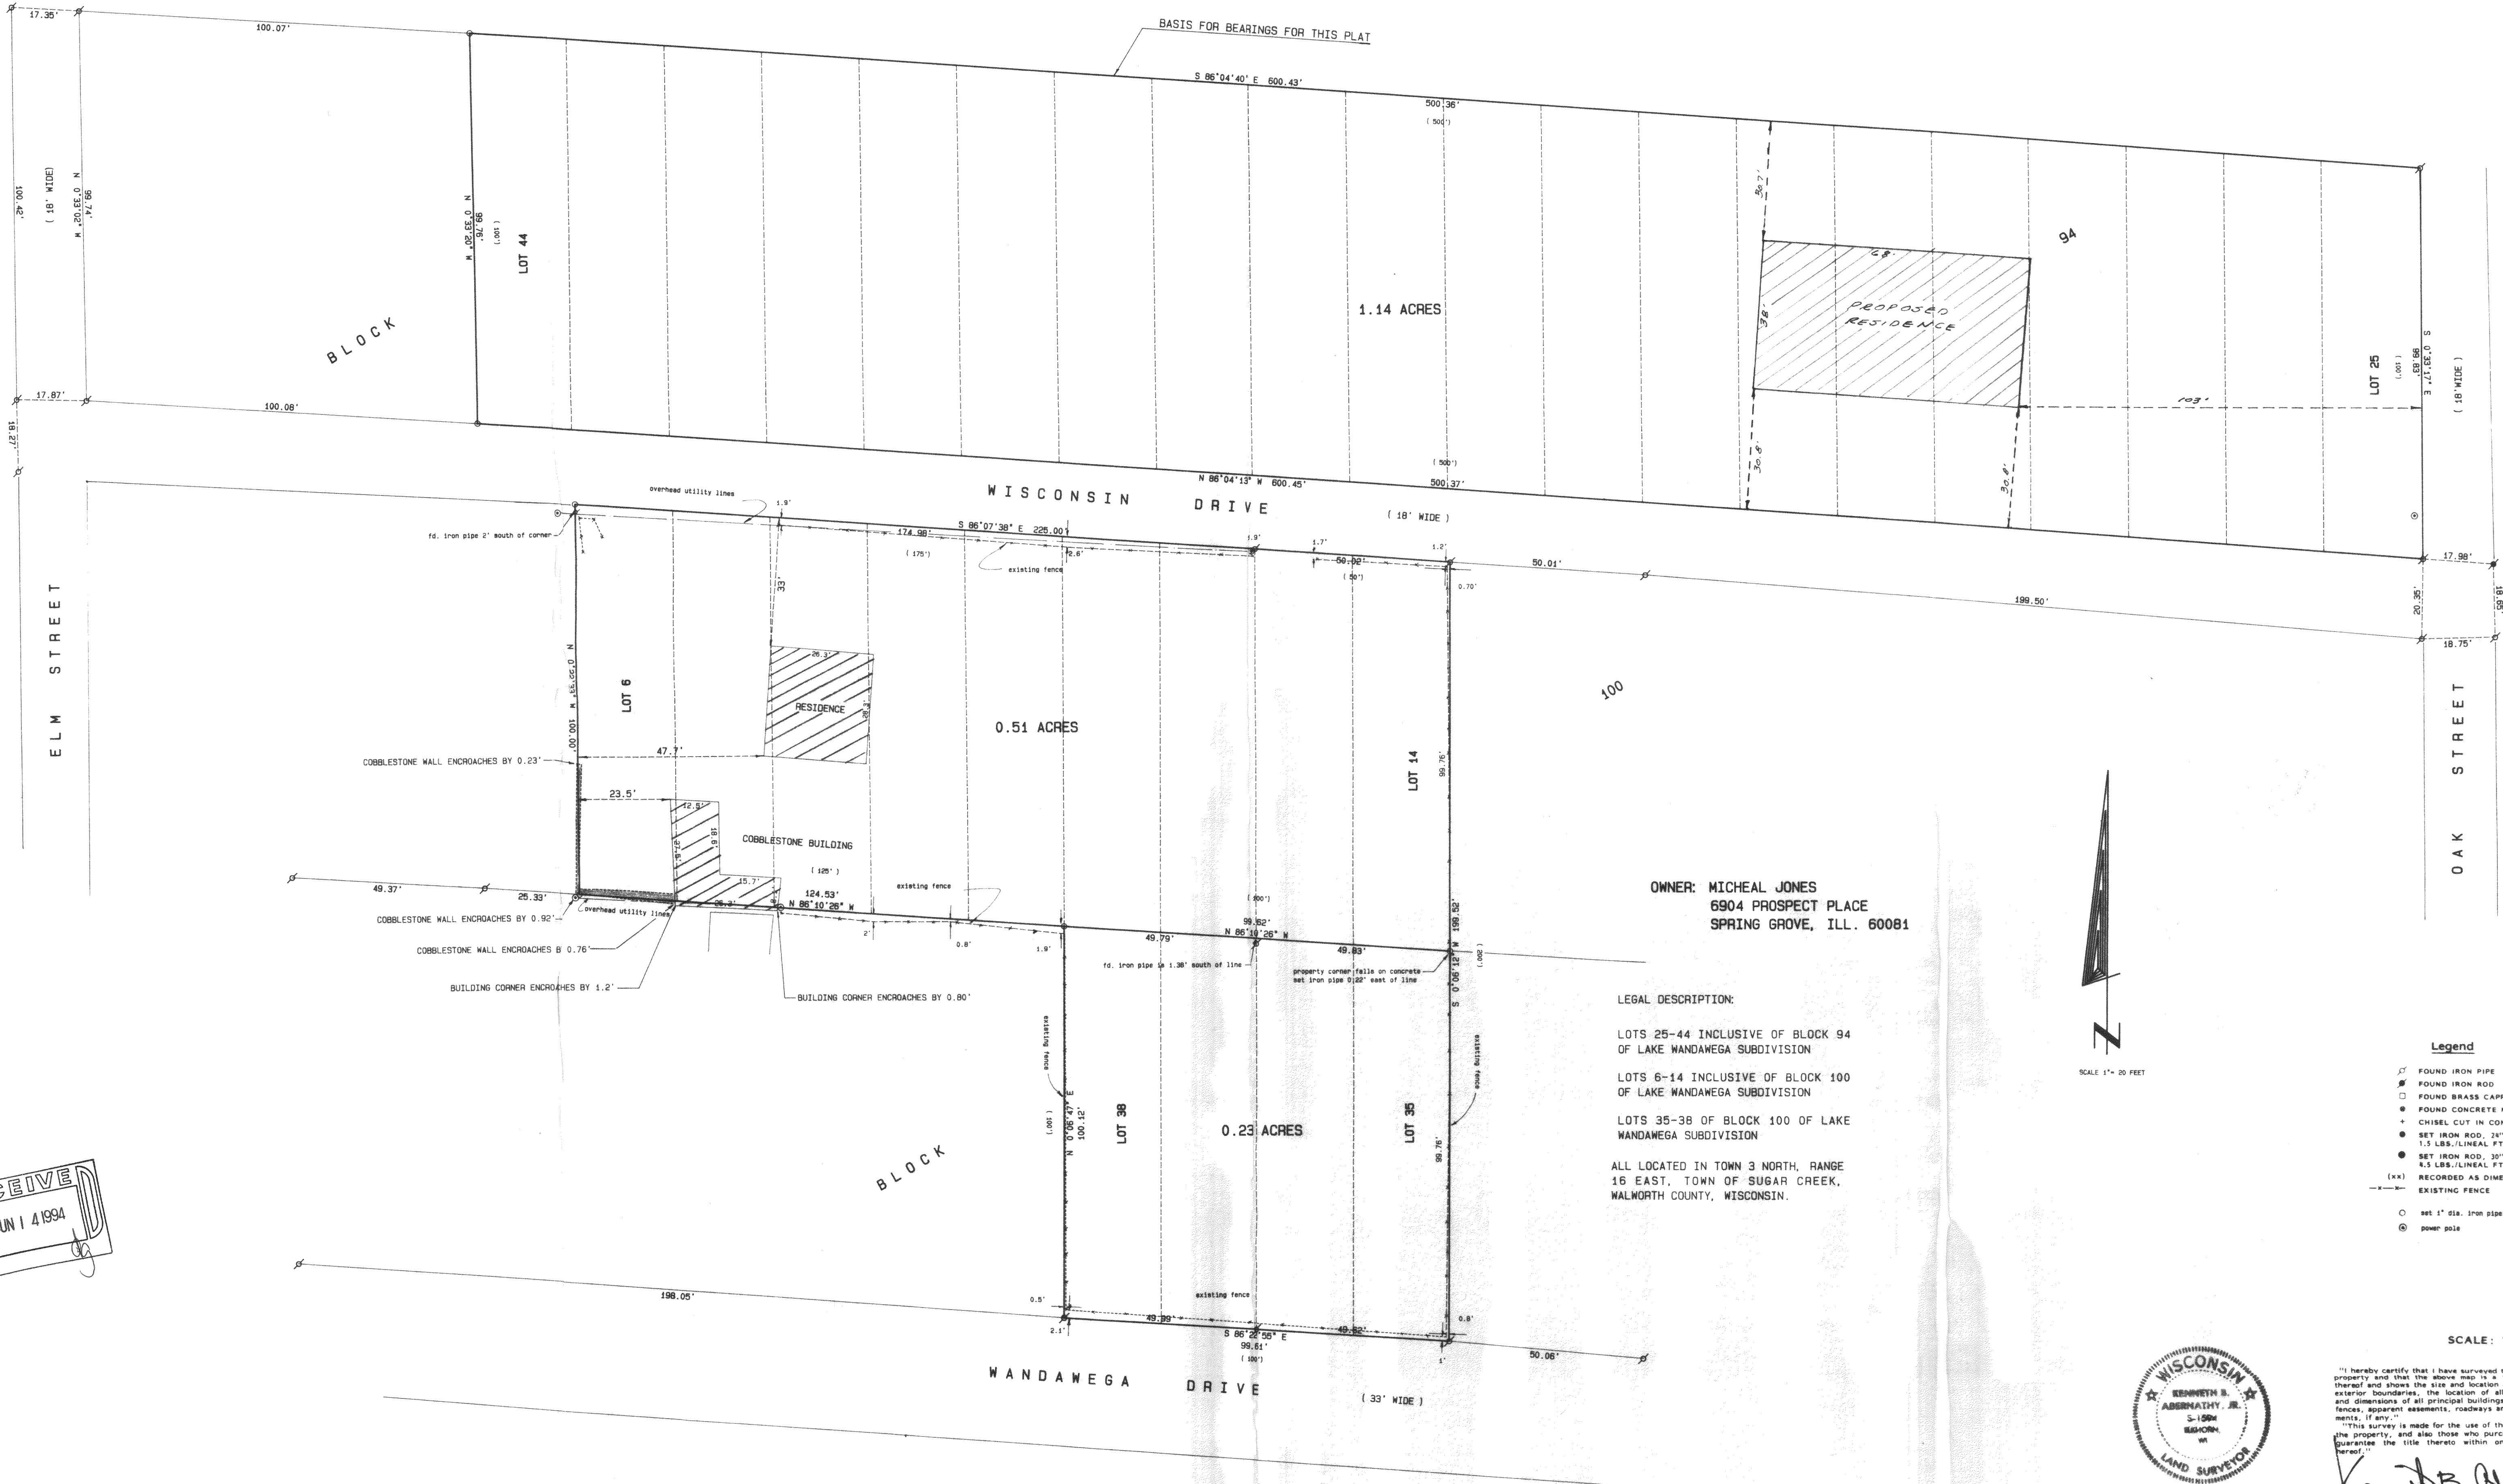

OWNER: MICHAEL JONES
6904 PROSPECT PLACE
SPRING GROVE, ILL. 60081

LEGAL DESCRIPTION:
LOTS 25-44 INCLUSIVE OF BLOCK 94
OF LAKE WANDAMEGA SUBDIVISION
LOTS 6-14 INCLUSIVE OF BLOCK 100
OF LAKE WANDAMEGA SUBDIVISION
LOTS 35-38 OF BLOCK 100 OF LAKE
WANDAMEGA SUBDIVISION
ALL LOCATED IN TOWN 3 NORTH, RANGE
16 EAST, TOWN OF SUGAR CREEK,
WALNORTH COUNTY, WISCONSIN.

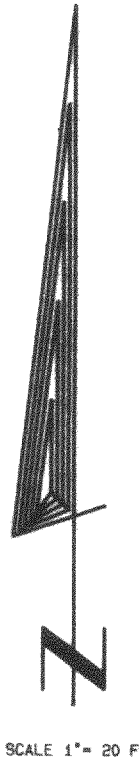

- Legend**
- FOUND IRON PIPE
 - FOUND IRON ROD
 - FOUND BRASS CAPPED MONUMENT
 - FOUND CONCRETE MONUMENT
 - CHISEL CUT IN CONCRETE
 - SET IRON ROD, 24" LONG, WEIGHING 1.5 LBS./LINEAL FT., 1/4" DIA.
 - SET IRON ROD, 30" LONG, WEIGHING 4.5 LBS./LINEAL FT., 1-11/16" DIA.
 - RECORDED AS DIMENSION
 - EXISTING FENCE
 - set 1" dia. iron pipe 2' long
 - power pole



"I hereby certify that I have surveyed the above described property and that the above map is a true representation thereof and shows the size and location of the property, its exterior boundaries, the location of all visible structures and dimensions of all principal buildings thereon, boundary fences, apparent easements, roadways and visible encroachments, if any."
"This survey is made for the use of the present owners of the property, and also those who purchase, mortgage, or guarantee the title thereto within one year from date hereof."
Kenneth B. Abernathy, Jr.
KENNETH B. ABERNATHY, JR.
WISCONSIN REGISTERED LAND SURVEYOR,
RENEWED 4/1/94
Date: April 2, 1992 Job No. 1992.205

RECEIVED
JUN 1 4 1994

BSC-1-22
GLW-205
GLW-213
GLW-204